

DEPARTMENT OF MINES AND ENERGY  
SOUTH AUSTRALIA

OPEN FILE

REPT.BK.NO. 84/94

LEIGH CREEK LOBE 'B'  
UPPER SERIES GROUNDWATER  
INVESTIGATION

GEOLOGICAL SURVEY

by

D. ARMSTRONG

D. EDWARDS

GROUNDWATER & ENGINEERING

NOVEMBER, 1984

DME. 519/77

<u>CONTENTS</u>	<u>PAGE</u>
INTRODUCTION	1
WELL NUMBERING SYSTEM	2
SELECTION OF SITES	2
INITIAL PRODUCTION WELL DESIGN CONCEPT	2
AQUIFER IDENTIFICATION	4
1982-1983 DRILLING AND TESTING PROGRAMMES	4
U/24 Site 9010W	4
U/24 Site 9020W	5
U/24 Results of Pumping Tests at 9020W	6
U/25 Site 9030W	9
U/25 Site 9040W	10
U/27 Site 9050W	12
U/27 Results of Pumping Tests at 9050W	14
Back Analysis of Test Data from 9050W	15
DEWATERING OF THE UPPER SERIES HANGINGWALL SEQUENCE	17
WATER QUALITY	20

#### APPENDICES

- Appendix 1. U/24 Site.  
2. U/25 Site.  
3. U/27 Site.  
4. AMDEL Report.  
5. Water Analyses.  
6. Index of DME Well Unit Numbers.

#### FIGURES

<u>Fig. No.</u>	<u>Title</u>	<u>Plan No.</u>
1.	Site location plan.	84-274
2.	Provisional correlation of sand members.	S17431
3.	9010W airlift test 1/10/82.	S17432
4.	9020W pump test 21/11/82.	S17434
5.	9020W pump test 21/1/83 semi/log plot.	S17433
6.	9020W pump test 21/1/83 log/log plot.	S17435
7.	9020W pump test 12/5/83 semi/log plot.	S17436
8.	9020W pump test 12/5/83 log/log plot.	S17437
9.	Observation Well 9010W drawdown 12/5/83.	S17438
10.	Generalised cross section U/24 site.	84-275
11.	Early time response in 9020W.	84-276
12.	Distance vs drawdown 9020W test 24/7/83.	S17439
13.	Obs. well 9024P and 9025P response 26/7/83 and 9/8/83.	S17440
14.	Generalised cross section U/25 site.	S17441
15.	Observation wells 9041P: 9042P, airlifting 9040W.	S17442
16.	Generalised cross section U/27 site.	S17443
17.	Stage 1 airlift 9050W linear scale plot.	S17444
18.	Stage 1 airlift 9050W semi/log plot.	S17445
19.	Stages 2 and 3 9050W linear scale plot.	S17446
20.	Stages 2 and 3 9050W semilog plot.	84-277
21.	Behaviour of 9050W during construction.	S17447
22.	9050W pump test 29/8/83.	S17448
23.	Potentiometric gradient.	S17449
24.	Simple basin model.	S17450

Appendix 1Plan No.

## U/24 Site Well Locations

S17451

Composite Log 9010W

82-338

Composite Log 9020W

83-504

Composite Log 9024/5P

83-503

Composite Log 9026P

83-513

Appendix 2

## U/25 Site Well Locations

S17452

Composite Logs 9030W

83-506

Composite Logs 9040W

83-505

Composite Logs 9041P

83-507

Composite Logs 9042P

83-508

Composite Logs 9043/4P

83-509

Appendix 3

## U/27 Site Well Location

S17453

Composite Logs 9050W

83-510

Composite Logs 9051P

83-511

Composite Logs 9052P

83-515

Composite Logs 9053P

83-512

Composite Logs 9054P

83-514

## 905W Caliper Logging

S17454

DEPARTMENT OF MINES AND ENERGY  
SOUTH AUSTRALIA

Rept.Bk.No. 84/94  
D.M.E. No.  
Disk No. 161

LEIGH CREEK LOBE 'B' UPPER SERIES  
GROUNDWATER INVESTIGATION

INTRODUCTION

A series of relatively dry years at Leigh Creek has resulted in serious depletion of industrial water supplies used for road watering.

In response to a request from the Electricity Trust of South Australia (E.T.S.A.) an investigation was initiated into the possibility of obtaining industrial water from the hangingwall sediments in the Upper Series at Lobe B as soon as possible.

The increasing water problems encountered during mining of the Upper Series required that the possibility of dewatering the hangingwall sediments be investigated as a medium to long term exercise.

Drilling and well completion methods suitable for high yielding production wells in the Upper Series hangingwall sediments have been investigated and three successful production wells and a series of observation wells have been installed.

The anticipated consumption rate for industrial water at the present level of development of the mine is 660 ML per year or roughly 2 ML per day. This water has in the past been supplied from surface storage of rainwater and mine water in disused open pits on the coalfield and some minor contribution from Reverse Osmosis (R.O.) plant reject water will be available when the R.O. plant is operating.

Provided that the rate of deepening of these cuts is compatible, it is highly probable that the twin objectives of provision of an industrial water supply and mine dewatering will be attainable at relatively low cost, possibly without the drilling of any additional production wells for a period of at least five years.

## WELL NUMBERING SYSTEM

In order to be compatible with the existing ETSA computer format a four digit numbering system was selected in which the first digit is 9 indicating that the hole is part of the water drilling programme. The second and third digits are the production well number and the fourth digit is the number of the observation well or piezometer associated with the production well indicated by the second and third digits. Suffixes W and P indicate production well and piezometer respectively. Thus:-

9040W is the fourth production well drilled.

and 9042P is the second piezometer associated with 9040W. This numbering system replaces the HOB series and existing HOB wells have been allocated new numbers.

## SELECTION OF SITES

An initial examination of electrical logs of existing coal exploration and geotechnical holes in early 1982 by G. Kwitko (SADME) indicated extensive zones of aquifer material in the hangingwall sequence. This exercise concentrated on the eastern end of the syncline which was closest to the M3? cut and therefore required a minimum of pipeline for disposal of water. Cored hole 3645 near the U/24 cut was selected as a suitable site and 9010W and 9020W were subsequently drilled at that location together with a series of piezometers completed partly by the E.T.S.A. shothole rig and partly by contractor during the 1983 drilling programme.

The results of pumping from 9020W were sufficiently encouraging to warrant further work in the upper series and logs of existing holes were examined in order to select sites covering a wider extent. Cored Holes nos. 3161 at U/25 and 3239 at U/27 were selected and after inspection of the cores it was decided to drill production wells at both sites.

Fig. 1 shows the location of the three sites investigated to date.

## INITIAL PRODUCTION WELL DESIGN CONCEPT

9010W was designed as a scout hole and was equipped with 6 m of 100 mm diameter, 0.375 mm aperture screen and natural sand pack. After initial development problems the results of

airlifting this hole were sufficiently encouraging to justify the drilling of 9020W as a gravel packed large diameter well.

9020W. When 9020W was being designed it was still felt that the aquifer material was sand in a moderately consolidated state. A large diameter gravel packed well was designed employing a specially prepared gravel pack material and 6 m of 200 mm diameter 1.0 mm aperture screen with the selected gravel pack extending to approximately 15 metres above the screen and a coarse crushed rock gravel pack extending from that point to surface. This design theoretically allows all aquifer zones penetrated by the hole to contribute to discharge.

9030W to 9050W. The original concept was to construct relatively large diameter gravel packed screened wells with 2 screens in what were believed to be moderately consolidated sands. Verbal reports concerning the aquifer intervals strongly suggested that the material emerged from the core barrel in a plastic condition and subsequently hardened into a slightly friable sandstone on drying in the core box.

The lower screen in each well was designed as a telescopic assembly to permit withdrawal of the screen if corrosion or clogging problems were encountered during the operation of the well.

Cores from the lowest two sand intervals in 3239 and the second lowest sand interval in 3161 were carefully logged and sampled for grain size distribution analysis. Preparation of samples involved crushing and wet sieving. The resultant optimum screen aperture size of 0.4 mm was used in the construction of 9030W with disastrous results. It is now clear that the sample preparation process resulted in the breakdown of lithic fragments to produce a sand which was considerably finer than the material in the undisturbed state.

Pieces of core were also submitted to Australian Mineral Development Laboratories (A.M.D.E.L.) for petrographic description and laboratory permeability testing. The results of the AMDEL work (see Appendix 4) only became available after the drilling programme was partially completed and confirmed that the aquifers were sandstones of reasonable permeability and porosity and that 0.4 mm was too small an aperture size for the insitu materials.

## AQUIFER IDENTIFICATION

Fig. 2 shows an interpretation of the continuity of permeable zones based on the inspection of 12 logged holes and the three production wells. This interpretation is provisional and may be changed as a result of further more detailed inspection of cores and electric logs.

At least 6 major sandy zones have been recognised and numbered consecutively starting from the lowest. They are referred to throughout this report as SAND 1 etc. but the lowest 2 or 3 members are sandstones at the depth of the production wells. The lithic nature of these sandstones renders them susceptible to chemical weathering as outcrop or subcrop is approached and in shallow intersection and pit walls they may appear as clayey sands.

It should be noted that 9020W is completed in SAND 2 and that SAND 2 appears to be washed out and replaced by a carbonaceous sequence between 9040W and 9050W.

### 1982-1983 DRILLING & TESTING PROGRAMME

#### U/24 Site 9010W

9010W was drilled by Thomson Drilling to a depth of 94 m close to cored hole 3645 and geophysically logged by Century Geophysical Corporation in May 1982.

Problems encountered in drilling and development are reported in SADME report No. 82/47 (D. Edwards) and are summarised below for completeness.

Difficulty in placing the screen at the first attempt necessitated reaming and the screen was finally located on top of a blockage (broken drill bit) at 56.5 m to 62.5 m in SAND 2.

Initial development yielded only 1.1 m<sup>3</sup>/day and subsequent airlift development yielded 180 m<sup>3</sup>/day. A further attempt at airlift development produced 320 m<sup>3</sup>/day with 8 m of drawdown.

Clearly the poor construction of this hole was responsible for the difficult development however 3.7 l/sec (320 m<sup>3</sup>/day) may be considered to be a useful yield from a 100 mm diameter screen in a poorly completed well for only 8 m of drawdown. Summary composite logs and completion details are shown in Appendix 1 and the results of the airlift pump test are shown in Fig. 3.

The specific capacity of 9010W is calculated at  $\frac{320}{8} = 40 \text{ m}^3/\text{d}$  per metre of drawdown. With a pump set at 35 m and available drawdown of about 20 m the well could be expected to produce up to  $40 \times 20 = 800 \text{ m}^3/\text{day}$  or 9 l/sec.

The transmissivity indicated by the 8 hr. test is of the order of 60 to 70  $\text{m}^2/\text{day}$  and the elastic storage coefficient is  $7.8 \times 10^{-5}$  or approximately  $1 \times 10^{-4}$ .

#### U/24 Site 9020W

Well 9010W was completed with relatively small diameter (150 mm) PVC casing to 38 m and therefore could not be equipped with a high capacity pump. It was decided to move 100 m in a downdip direction and drill a new well (9020W) with 200 mm casing in a fully gravel packed hole. In September 1982 Thompson Drilling contracted to drill the well which reached a total depth of 108 m. The hole was reamed to 311 mm diameter to 106 m and the section opposite the screen was reamed to 381 mm (90 m to 98 m). 200 mm diameter PVC casing with 6 m of 1 mm aperture screen located at 91.5 to 97.5 m (SAND 2) was installed and a selected gravel pack (1.1 mm to 1.8 mm) was placed from approximately 75 m to the bottom. The remainder of the annulus was filled with crushed rock aggregate (approximately 19 mm) containing about 5% of fines. Airlift development yielded 11 l/sec and a subsequent pump test (21/11/82) produced 9 l/sec with a drawdown in the well of the order of 50 m after 2 hrs.

Composite logs are presented in Appendix 1 and the results of the initial pump test in Fig. 4.

9020W was felt to be very inefficient and an attempt was made to redevelop the well using airlift which resulted in the removal of some dark fine grained material before the compressor failed.

A pump test carried out 21/1/83 produced a similar yield of 9 l/sec but for 2 m less drawdown (see Figs. 5 & 6).

The well was subsequently equipped and pumped for industrial water supply at 8 to 9 l/sec commencing 12/5/83. Drawdown was recorded for part of the period of pumping. The results are shown in Figs. 7, 8 and 9 and are discussed later.



In order to obtain a better feel for distance-drawdown relationships and drainage effects at the basin margins three shallow observation wells were drilled to a depth of 18 m using the ETSA shothole rig.

9021P is located 55 m in the updip direction from 9020W and was intended to intersect a permeable zone (SAND 5) appearing at a depth of 33 to 39 m in the production well. It was subsequently felt that 9021P may have been slightly too shallow and during the mid-1983 drilling programme a replacement 9026P was drilled to 30 m and completed with slotted 50 mm PVC casing in the target zone.

9022P and 9033P were drilled by ETSA at 170 m and 180 m respectively updip from the production well and were completed with 50 mm slotted PVC in the permeable zone which was screened in 9020W (SAND 2).

Because of the suspected low efficiency of 9020W it was decided to drill an observation well at 5 m radius from this production well. A dual completion technique enabled slotted PVC to be set opposite the screened zone in the production well (9024P) and in a permeable zone at a depth of 65 m (9025P SAND 5).

Summary logs, composite logs and completion details are given in Appendix 1 for all observation wells. A generalised cross section at U/24 site is given in Fig. 10.

#### Results of Pumping Tests at 9020W

The well was equipped with an electrosubmersible pump and pumped for approximately 4 200 mins at a rate of 9 l/sec commencing 21/11/82 and finishing 24/11/82.

Drawdown was observed in the pumping well, and 9010W. At the end of 4 200 mins the water level in 9020W was drawn down 54.48 m and in 9010W the drawdown was 4.94 m.

A semilog plot of drawdown vs time (Fig. 5) shows an unusual shape for the pumped well drawdown between 5 and 20 mins in which a recovery of over 2 m occurred despite continuous pumping. This feature is thought to be related to movement of water through the gravel packed annulus which requires some time to establish hence for the first 5 minutes of the test, the screened aquifer was supplying almost all of the discharge.

The log/log plot (Fig. 6) of observation well drawdown vs time clearly departs from the Theis Type Curve at about 30 mins in the fashion of a typical delayed yield response.

Transmissivity calculated from the early time match point data is  $35 \text{ m}^2/\text{d}$  and Elastic Storage Coefficient  $5.7 \times 10^{-5}$ .

The 120 mins test carried out on 21/1/83 after redevelopment showed a similar shape for the production well on the semilog plot (Fig. 7) but drawdowns were in general about 2 m less than drawdown prior to redevelopment.

Observation wells 9021P, 9022P and 9023P were drilled before the long term commissioning of 9020W as a water supply well and the drawdown observed for the 20 440 mins of continuous pumping between 12/5/83 and 24/5/83 are of considerable interest.

Fig. 7, a semilog drawdown vs time plot for the pumping well (9020W) shows three well defined straight line segments.

- 0- 100 mins - aquifer response  $T = 57 \text{ m}^2/\text{d}$
- 100- 3000 mins - delayed yield response
- 3000-20440 mins - basin dewatering.

The delayed yield segment reflects the onset of gravity drainage of the subcrop of the aquifer and the basin dewatering effect is felt when the contribution from delayed yield has diminished thus allowing the area of influence to increase and gradually drain the shallow margin of the basin.

The same three segments are evident in Fig. 9 a semilog drawdown vs time plot for 9010W and the aquifer response segment indicates an early time  $T$  of  $55 \text{ m}^2/\text{d}$ .

Fig. 8 is a log/log plot of drawdown vs time in 9010W and 9023P. Similar phases of drawdown can be interpreted from these plots with aquifer parameters from early time matches with the Theis Type Curve of:

- 9010W  $T = 41 \text{ m}^2/\text{d}$   $S = 6 \times 10^{-5}$
- 9023P  $T = 52 \text{ m}^2/\text{d}$   $S = 2.3 \times 10^{-4}$

The different stages of drawdown are excellently shown in the 9023P plot which indicates that the effects of basin dewatering were felt as early as 1 000 mins due to the location of the observation well close to the subcrop of SAND 2.

During the period of the test some 11 ML of water were withdrawn from 9020W. At the beginning of the pumping period the

Standing Water Level (SWL) in 9010W was 6.89 m below Top of Casing (T.O.C.) and two months later, on 25/7/83 the SWL had only recovered to 11.69 m below T.O.C. some intermittent pumping in the intervening period plus continued mine drainage in the working cut at U/27 make it impossible to relate the 4.8 m drop in SWL to a volume of water removed, however it does indicate that dewatering is occurring when a production well is pumped.

The early time response of 9020W to pumping is clearly shown for various test runs in Fig. 11.

It is interesting to note that the behaviour in the first 10 mins has changed between 21/1/83 and 12/5/83 with a much less pronounced recovery occurring at an earlier time on 12/5/83. Discharge rates were similar for each run.

The construction of an observation well at a radius of 5 m from 9020W has provided the opportunity to examine the efficiency of the pumped well however it has not been possible to observe the behaviour of 9024P and 9025P during a long period of pumping from 9020W.

Immediately after completion of the 5 m radius observation wells (26/7/83), the production well was airlifted at 8.5 l/sec for 3 hours (180 mins). Drawdowns observed in 9024P, opposite the screen in SAND 2 and in 9010W at 180 mins are shown in the distance versus drawdown semilog plot Fig. 12. The extrapolated drawdown at the radius of the wall of 9020W was 33 m compared with 48.5 m of drawdown observed during pumping of the well at a similar rate. The production well appeared to be only moderately efficient therefore it was decided to treat the production well with Calgon in an attempt to improve the efficiency. Previous airlift development had marginally improved the specific capacity from 15 m<sup>3</sup>/d/m to 15.5 m<sup>3</sup>/d/m and it was hoped that Calgon treatment would result in a more significant improvement.

During the airlift test of 26/7/83 prior to the placement of Calgon solution in 9020W the reaction of the 5 m radius observation wells was recorded whilst airlifting at 8.5 l/sec. Fig. 13 shows their response together with the results of a short post Calgon treatment airlift at the rate of 7.8 l/sec (9/8/83). The two sets of readings cannot be directly compared

since discharge was changing as the airlifted well was developing during the post Calgon phase.

The pre-Calgon behaviour of 9024P and 9025P will be compared with post-Calgon behaviour more effectively when 9020W is re-equipped with a pump.

U/25 Site: 9030W

The first production well in the 1983 drilling programme - 9030W - was drilled to 162 m adjacent to existing cored hole 3161. The assumption was made that SANDS 1 & 2 were unconsolidated and a natural sand pack would be developed. Based on sieve analysis of core from 3161 and 3239 a screen aperture of 0.4 mm was selected.

An in line screen was set opposite SAND 2 at 135 to 140 m and a telescope screen assembly was set opposite SAND 1 at 153 to 158 m. Completion details are shown in Appendix 2.

A telescope screen in the lowest sand was selected on the assumption that the poor quality of the water in the Upper Series may create corrosion problems and if such was suspected in the future, the telescopic screen could be withdrawn and inspected.

Development commenced on 28/5/83 with the driller following instructions which were to develop the lower telescoped screen first in order to avoid the possibility of the telescope section floating up the hole. No sand was produced during early development. After 2 hours of jetting the main casing string dropped 200 mm and the yield increased from less than 0.1 l/sec of clear water to 4.4 l/sec of dirty water with clay and gravel particles. Subsequently the main casing string locked into the drill rods and rotated one complete turn. The driller suspected collapse of the upper screen and immediately pulled back the rods to 92 m. The yield had increased to 7 l/sec by this time.

The rods were withdrawn from the hole and a dummy pump was run on 30/5/83. The dummy would not pass below 136 m confirming collapse of the in line screen.

This probably occurred due to blinding of the screen by clay and carbonaceous particles with full hydraulic pressure against the outside of the screen and a much reduced pressure due to airlifting inside the screen.

An attempt was made to recover the casing but a joint failed at 80 m below surface thus only the upper 80 m of casing was recovered. The hole was abandoned and redrilled as 9040W.

U/25 Site 9040W

Following the failure of 9030W it was decided to redrill the production well under the new number 9040W. Drilling started on 6/6/83 and was completed on 14/6/83. A variation from the original design was the addition of a sand pack to prevent collapse of the walls of the hole during development. The sand was selected from the U/27 excavation as the coarsest sand available and was in fact weathered aquifer material. The sand pack was emplaced in the hole using reverse circulation.

The driller was instructed to gradually develop both screens in order to avoid the problems encountered in 9030W however during development of the telescope screen set at 158 to 163 m, the jetting tool penetrated the end cap of the sump at 165 m. This cap was originally placed at 167 m therefore the telescope assembly had floated up the hole during the sand packing process to rest with the reducer and 'K' packer against the bottom of the in line screen.

This fact was subsequently confirmed by caliper logging.

A great deal of sand pack was lifted from the hole after the end cap had been penetrated. The annulus was topped up with sand, development was stopped and a cement plug set from 162 to 165 m to replace the end cap.

Subsequent development produced a yield of only 0.7 l/sec. The situation was reviewed and it was clear that the small screen aperture and sand pack were not effective.

It was decided to work over the hole, first drilling out the cement plug and airlifting any sand pack material which was surrounding the telescope screen assembly. It was clear by this time that SANDS 1 & 2 were in fact sandstones and probably capable of standing open-hole. It was therefore decided to withdraw the telescope assembly if possible and attempt to develop open hole in SAND 1.

This work was undertaken on 20/7/83. On drilling out the cement plug and airlifting from beneath the casing a yield of approximately 40 l/sec was developed with some sand and clay which cleared fairly rapidly.

During this process the entire telescope section floated to the surface and was recovered. Development then continued with open hole from 157 m downwards.

Very little sand pack was recovered. The sandstone was demonstrated to be stable even under considerable stress and the in line screen was either stabilised by sand pack, or free of sand pack since there was no seal at the bottom of the main casing string. The sand pack was stable at some level in the hole because although 7 m<sup>3</sup> of sand was added to the annulus during construction, only minor amounts were produced in this development process.

During airlifting, drawdown was observed in two observation wells and when the jetting tool was removed from the hole a caliper log was run over the open hole interval which confirmed the stability of the sandstone.

The final completion of 9040W is shown in Appendix 2.

Observation wells were drilled at 50 m radius to monitor SAND 1 (9041P) and SAND 2 (9042P). It was decided that useful distance drawdown data would be obtained from a dual completion observation well at 120 m radius, close to the projected highwall of the U25 cut.

A hole was drilled to 94 m and geophysically logged. Cuttings and geophysical logs indicated that SAND 1 was poorly developed so two observation wells were installed, 9043P slotted at 70 to 72 m and exposed via the hole annulus to SAND 1 and SAND 2, and 9044P slotted at 70 to 72 m opposite SAND 3.

Composite logs for all wells at U/25 site are presented in Appendix 2 and a cross section in Fig. 14.

Unfortunately there has been no pumping from 9040W since the completion of the observation wells at 120 m radius.

During airlifting of 9040W at approximately 40 l/sec, water levels were observed in 9041P and 9042P. The semilog plots of drawdown versus time are presented in Fig. 15.

Assuming that each aquifer contributes half of the discharge, the indicated transmissivities for early times are:-

9041P SAND 1  $T = 63 \text{ m}^2/\text{d}$

9042P SAND 2  $T = 53 \text{ m}^2/\text{d}$

An "impermeable" boundary was intersected at 10 and 8 mins in 9041P and 9042P respectively.

This behaviour is believed to be due to the interconnection between aquifers afforded by cored hole 3161 and the abandoned 9030W. At early time the induced leakage results in an apparent T value which is too high. At later times the leakage becomes less important and the T value approaches the true value for the aquifer.

Late Time 9041P SAND 1  $T = 29 \text{ m}^2/\text{d}$

9042P SAND 2  $T = 30 \text{ m}^2/\text{d}$

A comprehensive pump test will be carried out on 9040W as soon as a pipeline is installed to remove the water produced.

#### U/27 SITE 9050W

In order to test the theory that open hole completion would prove satisfactory for Upper Series production wells, 9050W was designed and constructed as follows.

Stage 1. A gravel packed well was constructed with 2 mm aperture heavy duty screen from 121 to 126 m opposite SAND 3. A fibreglass flange was installed at the bottom of the casing at 128 m. The well was developed and the yield noted.

Stage 2. The sandstone from 130 to 140 m (SAND 2) was drilled with a down the hole hammer and the yield noted after a short period of development.

Stage 3. The hole was advanced by down the hole hammer to penetrate the lowest sandstone (SAND 1, 144 to 151 m) and underlying siltstones to 160 m. Further development of aquifer intervals was then carried out.

Four observation wells, all at 50 m radius were completed prior to the commencement of the production well drilling. A fully cored hole 3239 is located 5 m from the production well.

Observations of water level fluctuation in all four observation wells were recorded during the three development stages and during drilling stages 2 and 3.

Stage 1 of the drilling of 9050W was carried out using the rotary mud technique and it was necessary to ream a slim (200 mm) pilot hole to 368 mm in order to install 200 mm ID fibreglass casing, stainless steel screen and 2 to 5 mm gravel pack. A fibreglass flange with open 200 mm ID centre and outside diameter of 355 mm was used as a firm base on which the casing could sit on the bottom of the hole. The flange would also prevent loss of gravel pack during stages 2 and 3.

Problems were encountered during installation of the casing due to the small clearance between the bottom flange and the walls of the hole, particularly opposite permeable sandstone intervals where mud cake had developed on the walls of the hole.

It required considerable effort to push the casing past such intervals and the last few metres required removal of the mudcake by prolonged washing beneath the casing before final depth could be achieved.

The reaming and casing operation occupied 5 full rig days.

The hammer drilling of stage 2 took only 40 mins and stage 3 took only 1 hr. 20 mins.

Two observation wells 50 m west of 9050W were drilled using rotary mud drilling.

9051P was completed in SAND 1 at 149 to 151 m and 9052P was completed in SAND 2 at 135 to 137 m.

A second pair of observation wells was drilled, also at 50 m radius but north of the production well, using air and a tricone bit. No problems were encountered with the drilling of 9053P and 9054P but both required to be filled with mud to retain wall stability during the casing operation.

9053P was completed in SAND 3 at 97 to 99 m and 9054P in SAND 4 at 86 to 88 m.

Thus at U/27 site there are observation wells in each of the four lowest sand members but there is no opportunity to observe distance drawdown relationships.



Standing water levels in these observation wells, after development showed a trend with the lowest sand member having the deepest SWL and successive members showing shallower SWL's.

SWL (below Top of Casing)		
9054P	SAND 4	19.28 m
9053P	SAND 3	21.77 m
9053P	SAND 2	23.00 m
9051P	SAND 1	23.35 m

This vertical potentiometric gradient is thought to be due to the drainage of the lowest sand member into the U/27 cut which has not yet exposed the higher sand members below water level and is believed to be a phenomenon which exists throughout the Upper Series hangingwall rocks.

Completion details and composite logs for all U27 drilling is contained in Appendix 3 and a cross section is presented in Fig. 16.

#### Results of Pumping Tests on 9050W

During the air drilling of 9053P airlift yield was carefully monitored as the drilling proceeded.

<u>Depth(m)</u>	<u>Cumulative Q (l/sec)</u>	
50	1.6	)
64	2.2	) SAND 5
76	3.3	)
80	4.1	) SAND 4 & 5
90	5.7	)
100	8.6	)
102	11.2	) SAND 3, 4, 5

It is clear that each sand unit is saturated and capable of yielding water. Available submergence for the efficient operation of air lift increased with drilling depth and the most significant discharge recorded was at full depth when the maximum submergence was available.

The 11.2 l/sec recorded was in good agreement with the discharge of 13 l/sec obtained from Stage 1 of 9050W in which similar sand members were exposed to the gravel pack and screen. All available observation wells were monitored during the airlift development of Stage 1 of 9050W. Results are shown in Figs. 17, 18. Although only SANDS 3 and 4 were penetrated by the production well, a response of 1 m was noted in the SAND 2

observation well at 50 m radius. This was due to interconnection of aquifers via the old cored hole 3239. The SAND 1 observation well did not respond at this stage.

Assuming that of the 13 l/sec discharge developed after 100 mins, 7 l/sec was contributed by the screened interval (SAND 3) for a  $\Delta s$  of 6 m but 1.6 l/sec was derived from SAND 2 via cored hole 3239, and 6 l/sec came from SAND 4 for a  $\Delta s$  of 5.6 m, the transmissivities of the two sand members are:-

$$\text{SAND 3} \quad T = 14 \text{ m}^2/\text{d}$$

$$\text{SAND 4} \quad T = 17 \text{ m}^2/\text{d}$$

Interesting observation well responses were noted during the drilling of Stages 2 and 3 (see Figs. 19 & 20).

During Stage 2, when the drill was penetrating SAND 2, some response was recorded in 9051P, the SAND 1 observation well. After 140 mins of airlifting, 7 m of drawdown had developed at 50 m radius. This drawdown can only be attributed to the presence of the cored hole at 5 m radius which must be assumed to be still open over the aquifer intervals.

During Stage 3, when SAND 1 was being drilled a drawdown of 17 m developed in 9051P.

The presence of an open hole so close to the production well simulates the behaviour of a leaky aquifer and makes precise analysis of pump test data impossible. Since there is a large number of exploration holes in the Upper Series, most of which can be assumed to be open at depth to some degree, the Upper Series can be expected to behave as a leaky aquifer system which will assist in the ultimate drainage of higher sand members in the sequence.

#### Back Analysis of Test Data on 9050W

##### Stage 1

After 100 m airlifting at  $Q = 13 \text{ l/sec} = 1125 \text{ m}^3/\text{d}$ .

SAND	$\Delta s$	Estimated $Q$	$\frac{Q}{\Delta s}$	$T = .183 \frac{Q}{\Delta s}$
4	5.6 m	432 $\text{m}^3/\text{d}$	77	14 $\text{m}^2/\text{d}$
3	6.0 m	550 $\text{m}^3/\text{d}$	92	17 $\text{m}^2/\text{d}$
2	0.8 m	141 $\text{m}^3/\text{d}$	176	32 $\text{m}^2/\text{d}$
1	-	-	-	-

Since SAND 2 was not exposed in the production well during Stage 1 there is clearly some interconnection between aquifers via cored hole 3239 (see Fig. 21A).

Ignoring leakage,  $Q$  SAND 3 = 661 m<sup>3</sup>/d and  $T = 20$  m<sup>2</sup>/d.

### Stage 2

After 100 mins airlifting  $Q = 27$  l/sec = 2333 m<sup>3</sup>/d.

SAND	$\Delta s$	Estimated $Q$	$\frac{Q}{\Delta s}$	$T = \frac{.183Q}{\Delta s}$
4	3.0 m	231 m <sup>3</sup> /d	77	14 m <sup>2</sup> /d
3	3.47m	319 m <sup>3</sup> /d	92	17 m <sup>2</sup> /d
2	4.3 m	1205 m <sup>3</sup> /d	280	51 m <sup>2</sup> /d
1	7.6 m	578 m <sup>3</sup> /d	76	14 m <sup>2</sup> /d

The  $T$  value for SAND 2 is spuriously high due to the excellent interconnection which must exist between 9050W and 3239 at the level of SAND 2 (see Fig. 21B).

Image well theory indicates that 3239 is behaving as a recharge well with respect to SAND 2 and will result in the  $\Delta s$  value observed in 9052P being reduced by half.

To calculate  $T$  for SAND 2  $Q$  becomes 1205+578 = 1783 m<sup>3</sup>/d and  $\Delta s$  is doubled from 4.3 to 8.6 giving :-

$$T = \frac{.183 \times 1783}{8.6} = 38 \text{ m}^2/\text{d}$$

Realistic values from Stage 2 are:-

	$T$
SAND 4	14 m <sup>2</sup> /d
SAND 3	17 m <sup>2</sup> /d
SAND 2	38 m <sup>2</sup> /d
SAND 1	14 m <sup>2</sup> /d

Drawdowns observed during a pump test (29/8/83) on Completed Well 9050W, with a  $Q = 2013$  m<sup>3</sup>/d are shown in Fig. 22.

Because all 4 sand zones are available for direct discharge into 9050W the effects of 3239 will be minimised and the system treated as if no leakage was occurring (see Fig. 21C).

SAND	$\Delta s$	Estimated $Q$	$\frac{Q}{\Delta s}$	$T = \frac{.183Q}{\Delta s}$
4	2.3 m	177 m <sup>3</sup> /d	77	14 m <sup>2</sup> /d
3	3.2 m	294 m <sup>3</sup> /d	92	14 m <sup>2</sup> /d
2	4.4 m	836 m <sup>3</sup> /d	190	35 m <sup>2</sup> /d
1	9.3 m	706 m <sup>3</sup> /d	76	14 m <sup>2</sup> /d
				$\Sigma T \text{ } 80 \text{ m}^2/\text{d}$

Analysis of the drawdown in the discharging well 9050W gives an apparent T of 87 m<sup>2</sup>/d which is good agreement with values obtained by treating aquifers separately.

Hydraulic Conductivity may be calculated from the Transmissivity values obtained during pump testing.

SAND	T	Thickness bm	$K = \frac{T}{b}$	Amdel lab values of K
4	14	5	2.8m/d	-
3	17	9	1.9m/d	-
2	35	10	3.5m/d	3.65 m/d
1	14	7	2.0m/d	2.72 to 3.28 m/d

The assumptions on which the above Transmissivity values were based rely on the equation  $T = \frac{.183Q}{\Delta s}$  and the fact that for a given aquifer, Transmissivity is a constant therefore the ratio  $\frac{Q}{\Delta s}$  should be a constant enabling Q to be determined from  $\Delta s$ . A subjective estimate of flow rates was made for Stage 1 and for flows from Sands 1 and 2 in the Pumping Test. Minor adjustments were then made to all flow values to obtain a stable set of transmissivities. Caliper logs from the open hole interval of 9050W before (8-8-83) and after (21-10-83) pumping are shown in Appendix.

#### Dewatering of the Upper Series Hangingwall Sequence

The Upper Series hangingwall consists of a multilayered sequence of alternating siltstone or mudstone aquitards separating sand or sandstone aquifers of moderate permeability.

This represents a complex leaky aquifer system whose behaviour in the undisturbed state would be largely governed by the vertical hydraulic conductivity (Kv) of the aquitards and the hydraulic properties of the aquifers themselves.

The situation is made more complex by the existence of a large number of coal exploration holes and several cored geotechnical holes which the present programme has shown to have a high probability of being open at least over the lower sand members particularly at depths unaffected by weathering where the material is in the form of sandstone.

An indication of the number of holes involved may be obtained from the location plan (Fig. 1). Counting only those holes which lie in areas outside the indicated 1986/87 highwall the number of holes by area is:-

Area 20	40
21	16
22	25
23	62
24	>100
25	16
26	16
27	10

There are thus between 200 and 300 holes which may be open allowing interconnection of aquifers.

Whilst interconnection facilitates drainage of the entire basin it makes precise determination of aquifer properties on a basin-wide basis almost impossible.

The behaviour of the basin as a whole in response to dewatering pumpage will be dependent on a number of factors.

1. Degree of aquifer interconnection in a vertical sense.
2. Extent of continuity of aquifers horizontally.
3. Presence or absence of faults which may produce partial compartmentalisation of the system.
4. Changes in physical nature of aquifers in response to weathering at shallow depths. Delayed yields and perhaps inability to drain under gravity may accompany the process of weathering of a lithic sandstone to a sandy clay or clayey sand.
5. The hydraulic properties of the aquitards.
6. The absence or presence of recharge via surface alluvial sediments.
7. Interaction with existing and future pit drainage.

The situation in August 1983, when relatively little pumping of groundwater from dewatering wells had occurred indicates that mine drainage has created a potentiometric gradient from east to west.

Water levels from the three sites discussed in this report (Fig. 23) show a gradient of  $\frac{3 \text{ m}}{1000 \text{ m}}$  or  $3 \times 10^{-3} \text{ m/m}$  between 9040(U/25), and 9050(U/27) sites. The gradient between 9020(U/24) and 9040(U/25) is  $\frac{6.5}{1000}$  or  $6.5 \times 10^{-3} \text{ m/m}$ . These gradients are the result of early and continuing drainage at the U/27 cut which is currently the deepest upper series

excavation. Water levels at 9050 site are around 170 m AHD and at 9020 site are 186.5 m AHD.

It is anticipated that these gradients will be substantially modified by pumping from the dewatering wells which will ultimately produce interacting cones of influence which, in the absence of recharge, will gradually dewater the basin.

On the assumptions that:

- 1) industrial water is required at the rate of 3 ML/day,
- 2) 30 or 50 m total thickness of sand has to be drained with a Specific Yield of 0.2,
- 3) there is no recharge to the basin and pumping is continuous, a simple model of the progress of dewatering can be constructed.

Fig. 24 shows such a model which suggests that for a total sand thickness of 50 m, the water level throughout the basin can be lowered by 150 m in about 14 years of continuous pumping at a rate of 3 ML/day which will satisfy industrial water requirements.

This model will underestimate the rate of lowering of water level if:-

- a) Sand thickness is greater than 50 m
- b) Specific Yield is greater than 0.2
- c) The aquitards can yield significant volumes of water with depressurisation.

A higher discharge rate will increase the rate of lowering all other things being equal (current well capacity is at least 50 l/sec or 4.32 ML/day). If dewatering proceeds at a rate greater than the demand for industrial water a significant surface storage will be required.

As the basin water level declines so will the maximum capacity of the dewatering wells and it will be necessary to drill progressively deeper wells with the passage of time.

Overall dewatering planning will depend upon the rate of lowering of water level necessary to achieve dry pit conditions and it may therefore be necessary to drill some additional shallower wells to rapidly dewater areas required for mining in the immediate future.

In order to monitor the basin-wide progress of dewatering it would be desirable to establish observation wells at points remote from discharge sites.

Water Quality

Water analyses from all production wells are included in Appendix 5.

With the exception of 9010W which showed a wide variation in T.D.S. between 21 000 and 8 000 mg/l, all are typical sodium chloride type waters with some calcium and sulphate. (The latter due to oxidation of pyrite).

T.D.S. ranges from 12 070 mg/l to 16 400 mg/l suggesting a long residence time and poor flushing.

At the well head the water smells strongly of  $H_2S$  but strong smell is usually associated with relatively low levels of this gas which can easily be removed by aeration.


DA;DRE:ZV



D. ARMSTRONG



D. R. EDWARDS

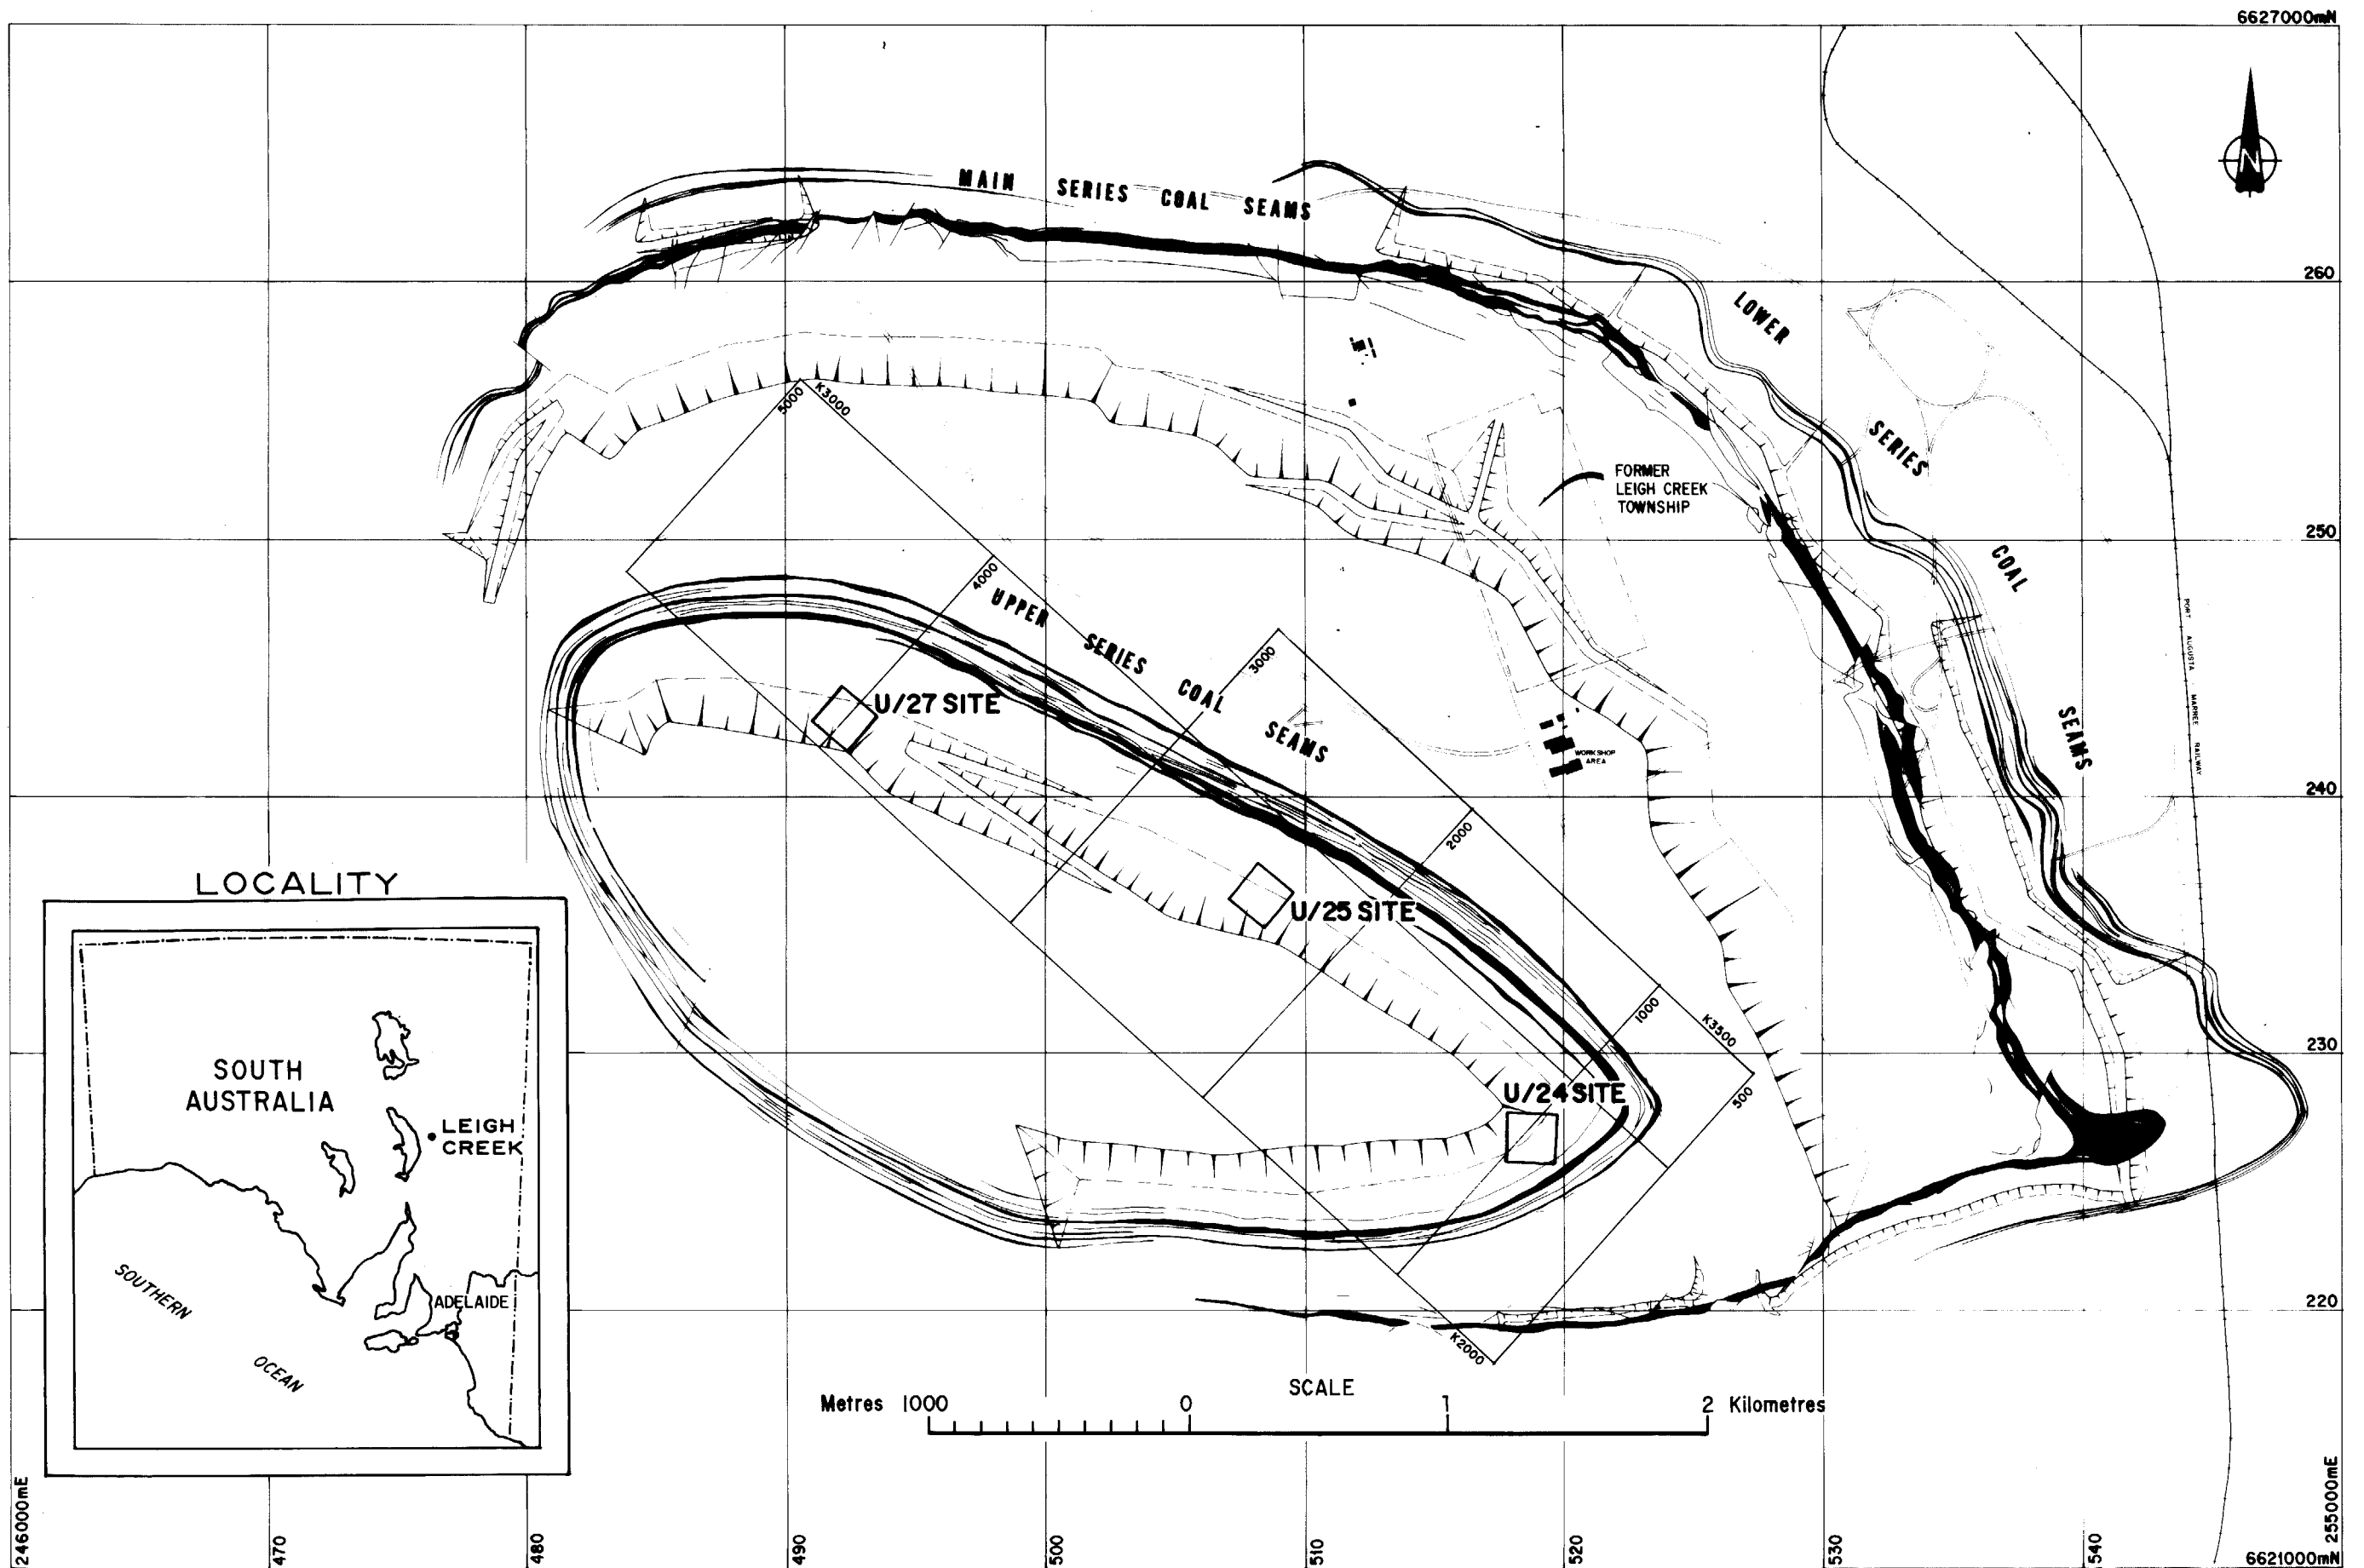

# REFERENCE

- Road
- Building other than township
- Sub-outcrop of coal seams

- Faults disclosed by drilling
- Mining limits
- Datum is Australian Map Grid, Zone 54

<p>DEPARTMENT OF MINES AND ENERGY SOUTH AUSTRALIA</p> <p>LEIGH CREEK COALFIELD LOBE B GROUNDWATER INVESTIGATION</p> <p><b>SITE LOCATION PLAN</b></p>		COMPILED D. E.	<i>22/11/85</i> DATE
		DRAWN G. B.	SCALE 1:25 000
		DATE 27 JUN 84	PLAN NUMBER
		CHECKED	<b>84-274</b>

FIG... 1




W

E

9040W WELL UNIT NO. 6537 46r OW 00598

9050W WELL UNIT NO. 6537 47n OW 00532

9020W WELL UNIT NO. 6536.05d OW 00426

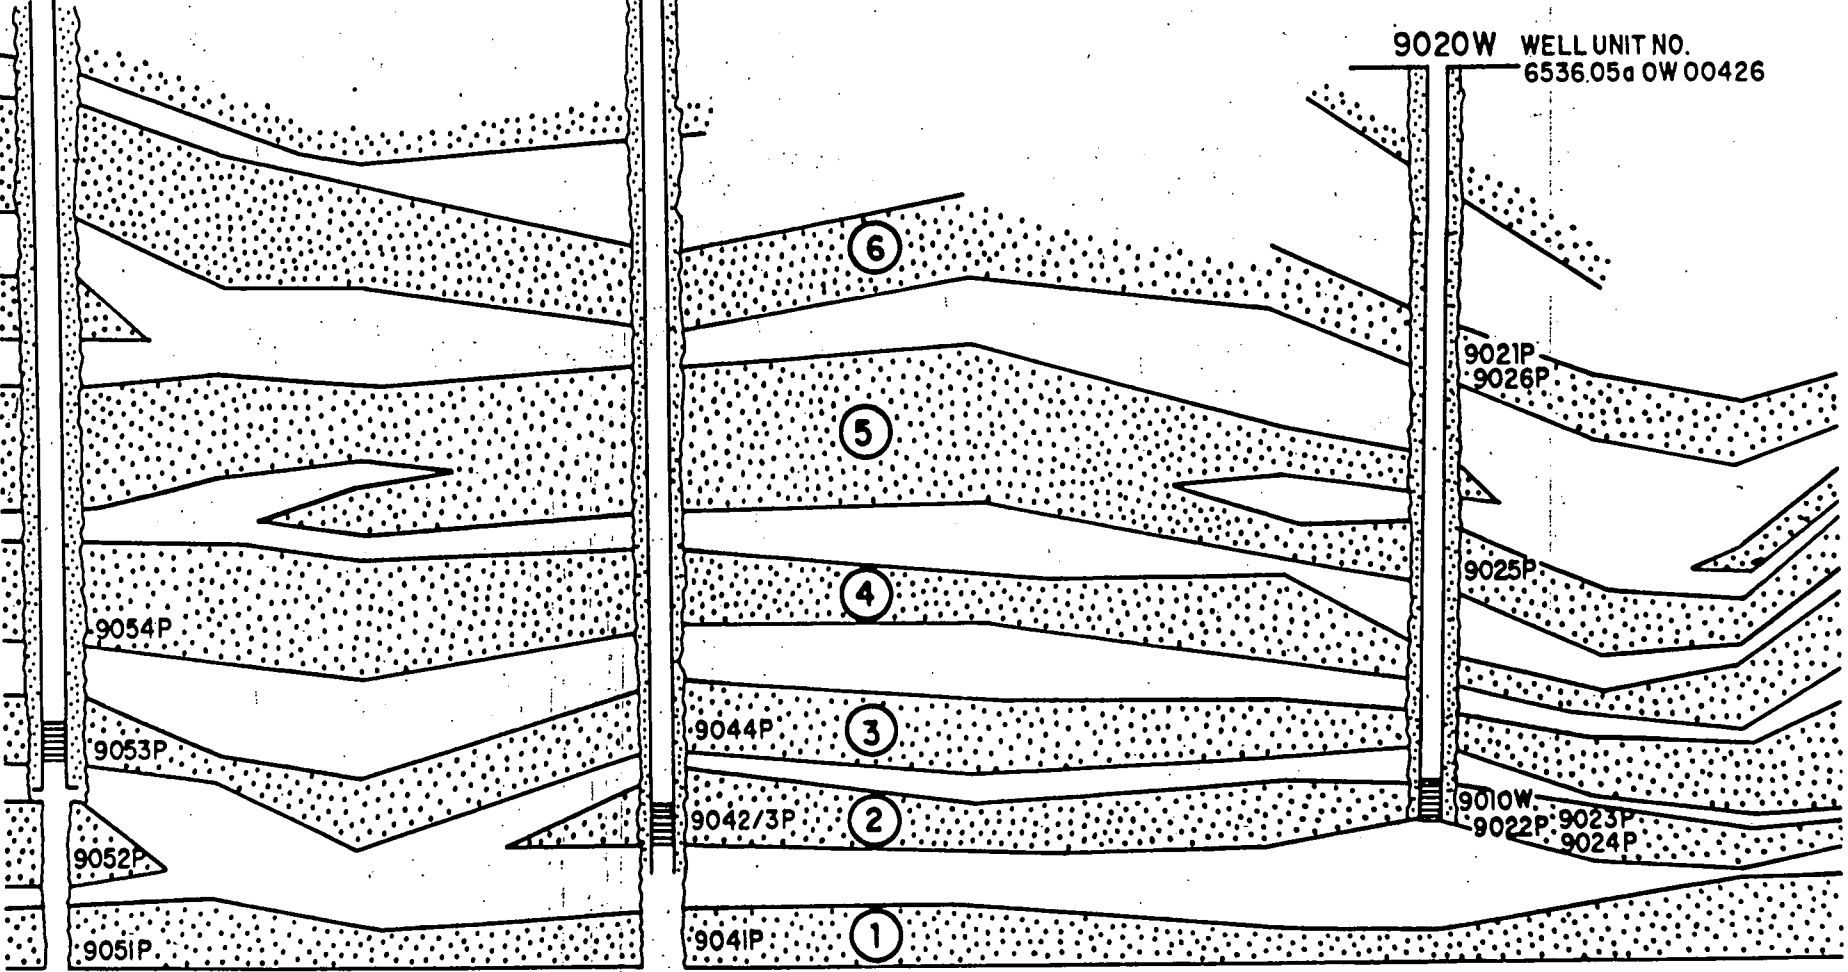

REFERENCE

- W Production well (9050 – fifth production well drilled in upper series)
- 9044P Piezometer monitoring effect of 9040W on 'SAND' member 3
- ⑥ 6th. 'SAND' member above highest exploitable coal seam
- See text for 'AQUIFER IDENTIFICATION'

Gravel packing  
For all SADME Well Unit No.s. see appendix 6

FIG. 2

DEPARTMENT OF MINES AND ENERGY  
SOUTH AUSTRALIA  
LEIGH CREEK COALFIELD LOBE B GROUNDWATER INVESTIGATION  
PROVISIONAL CORRELATION OF SAND MEMBERS


COMPILED	D.A.	SCALE	PLAN NUMBER
DRAWN	G.B.	DATE	25 JUN 84
CHECKED			S17431

LEIGH CREEK COALFIELD LOBBE GROUNDWATER INVESTIGATION  
 9010W WELL UNIT NO. 65360500W00254  
 AIRLIFT TEST 10CT 82



DEPARTMENT OF MINES AND ENERGY  
 SOUTH AUSTRALIA

(SECTION) NMDWDRAW = P

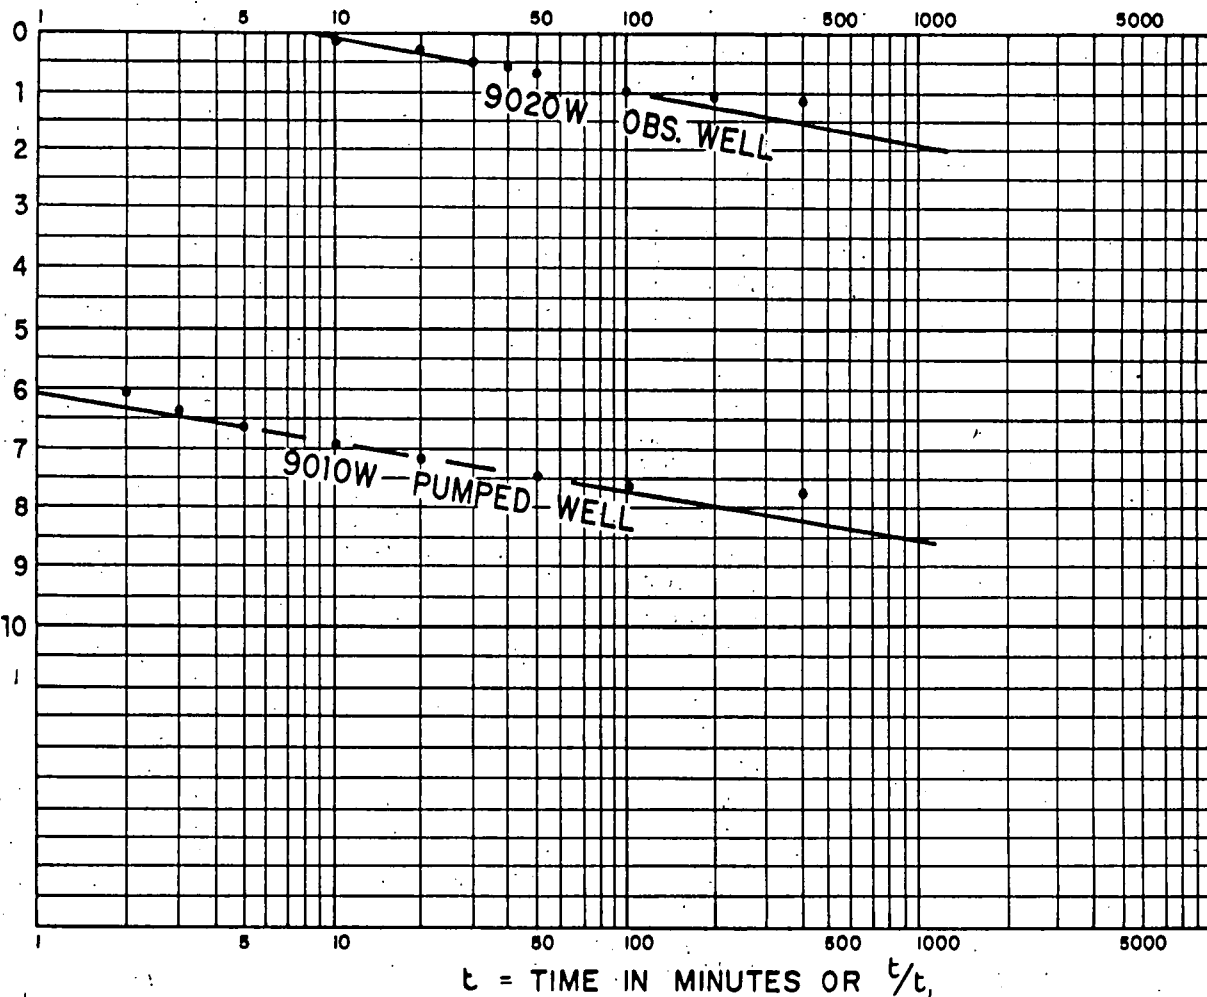

$t = \text{TIME IN MINUTES OR } t/t$

### DATA

Q	$\Delta d$	$t_0$	r
9010W 3.7L/s 320m <sup>3</sup> /d	0.8m		
9020W 320m <sup>3</sup> /d	0.88m	7mins	96m

Figure 3

For all SADME Well Unit No.s. see appendix 6

PROJECT No. 9010W  
 PRODUCTION/OBSERVATION WELL  
 INTERVAL TESTED  
 From 48 m. to 63 m.  
 HOLE DEPTH 94 m.  
 AQUIFER THICKNESS ? m.  
 DEPTH OF PUMP INTAKE AIRLIFT m.  
 DEPTH OF WATER LEVEL  
 AT TEST START 6.17 m.  
 AVAILABLE DRAWDOWN — m.

### JACOB EQUATIONS\*

$$T = \frac{0.183 \times Q}{\Delta d} \quad \text{in which}$$

T = Transmissivity (m.<sup>3</sup>/day / m.)

Q = Pumping rate (m.<sup>3</sup>/day)

$\Delta d$  = Drawdown per log cycle (m.)

$$S = \frac{2.25 \times T t_0}{1440 r^2} \quad \text{in which}$$

S = Storage coefficient

$t_0$  = Zero drawdown time (minutes)

r = Distance to Observation Well (m.)

### CALCULATIONS

9010W

$$T = \frac{0.183 \times 320}{0.8} \\ = 73 \text{ m}^3/\text{d/m}$$

9020W (OBS. WELL) r=96m


$$T = \frac{0.183 \times 320}{0.88} \quad S = \frac{2.25 \times 66 \times 7}{96 \times 96 \times 1440} \\ = 66 \text{ m}^3/\text{d/m} \quad = 7.8 \times 10^{-5}$$

\* Check applicability of this method

COMPILED  
 D.A.B.D.E.  
 DRAWN  
 G.B.  
 DATE  
 27 JUN 84  
 CHECKED  
 SCALE  
 PLAN NUMBER  
 S17432

(SET/CM) NMOODWAD =  $\rho$ 

Figure 4

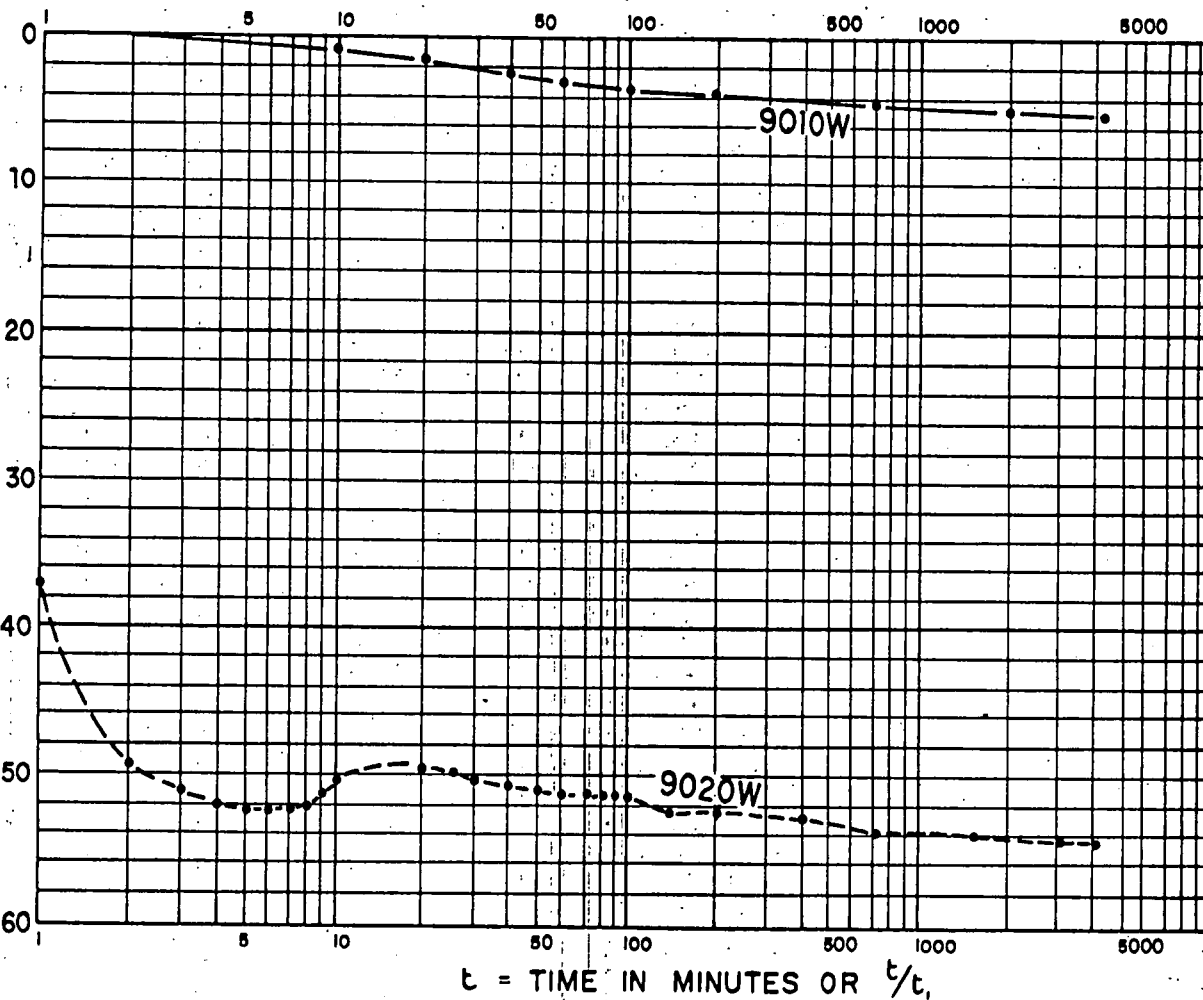 $t = \text{TIME IN MINUTES OR } t/t_0$ DATACALCULATIONS

PROJECT No. 9020W  
 PRODUCTION/OBSERVATION WELL  
 INTERVAL TESTED

From ..... m. to ..... m.  
 HOLE DEPTH ..... m.  
 AQUIFER THICKNESS ..... m.  
 DEPTH OF PUMP INTAKE ..... m.  
 DEPTH OF WATER LEVEL  
 AT TEST START ..... m.  
 AVAILABLE DRAWDOWN ..... m.

JACOB EQUATIONS\*

$$T = \frac{0.183 \times Q}{\Delta d} \quad \text{in which}$$

$T$  = Transmissivity ( $\text{m}^3/\text{day}/\text{m}.$ )

$Q$  = Pumping rate ( $\text{m}^3/\text{day}$ )

$\Delta d$  = Drawdown per log cycle (m.)

$$S = \frac{2.25 \times T t_0}{1440 r^2} \quad \text{in which}$$

$S$  = Storage coefficient

$t_0$  = Zero drawdown time (minutes)

$r$  = Distance to Observation Well (m.)

 $\Delta d$  = RESIDUAL DRAWDOWN (METRES)

For all SADME Well Unit No s see appendix 6

\* Check applicability of this method

LEIGH CREEK COALFIELD LOBE B GROUNDWATER INVESTIGATION  
 9020W WELL UNIT NO. 65360500W00426  
 PUMP TEST 21 NOV 82  
 SEMI-LOG PLOT

COMPILED D.E.B.D.A.	SCALE R.C.D.O.	DATE DATE
DRAWN G.B.	SCALE	DATE
CHECKED 27 JUN 84	PLAN NUMBER S17434	

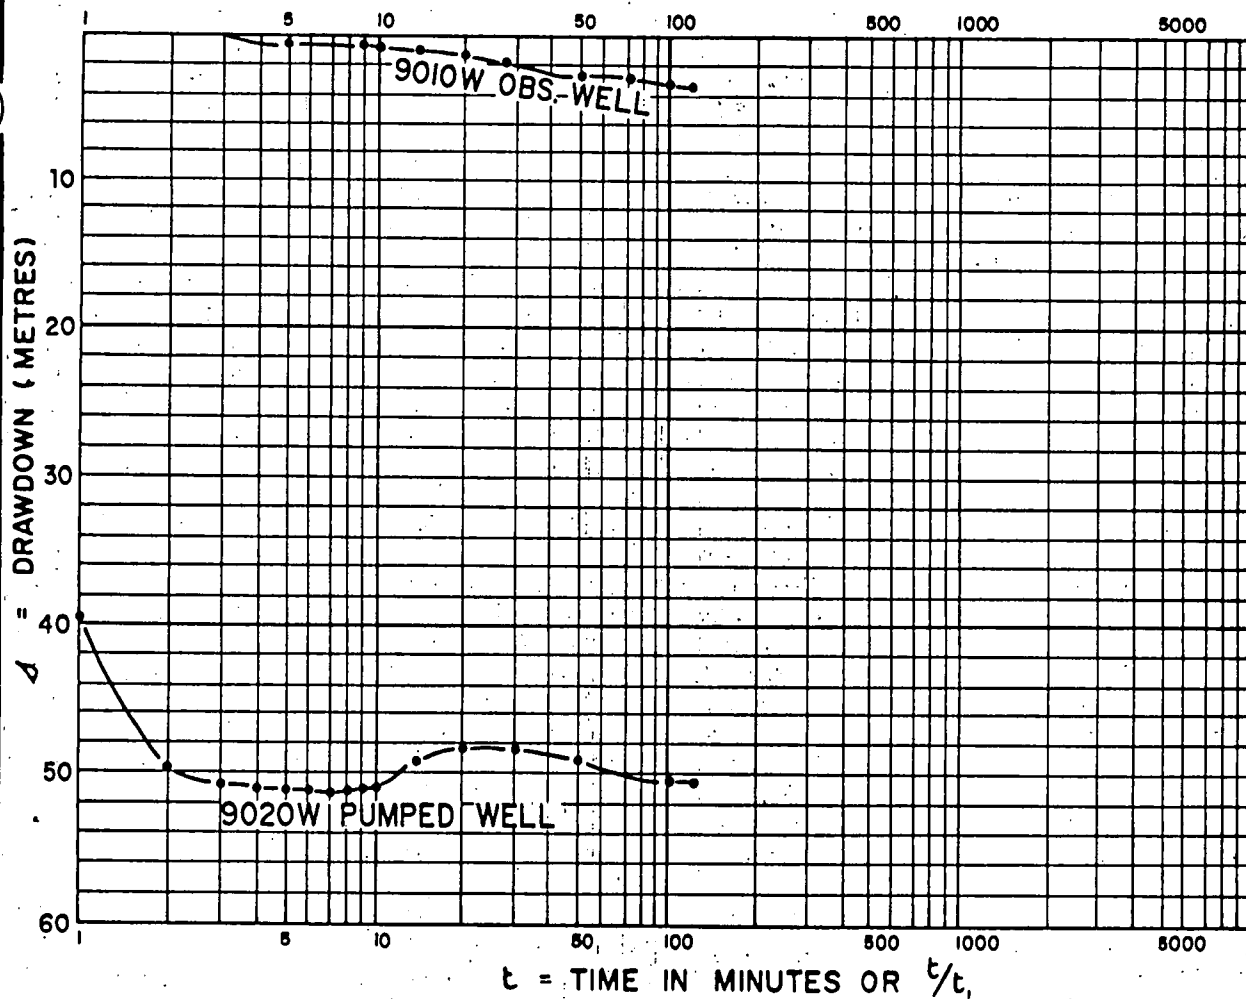


Figure 5

For all SADME Well Unit Nos see appendix 6

PROJECT No 9020W  
 PRODUCTION/OBSERVATION WELL  
 INTERVAL TESTED

From ..... m. to ..... m.  
 HOLE DEPTH ..... m.  
 AQUIFER THICKNESS ..... m.  
 DEPTH OF PUMP INTAKE ..... m.  
 DEPTH OF WATER LEVEL  
 AT TEST START ..... m.  
 AVAILABLE DRAWDOWN ..... m.

### JACOB EQUATIONS\*

$$T = \frac{0.183 \times Q}{\Delta d} \text{ in which}$$

T = Transmissivity (m<sup>3</sup>/day/m.)

Q = Pumping rate (m<sup>3</sup>/day)

$\Delta d$  = Drawdown per log cycle (m.)

$$S = \frac{2.25 \times T t_0}{1440 r^2} \text{ in which}$$

S = Storage coefficient

$t_0$  = Zero drawdown time (minutes)

r = Distance to Observation Well (m.)

### CALCULATIONS

### DATA


Q  $\Delta d$   $t_0$  r

DEPARTMENT OF MINES AND ENERGY  
 SOUTH AUSTRALIA  
 LEIGH CREEK COALFIELD LOBE B GROUNDWATER INVESTIGATION  
 9020W WELL UNIT NO. 65360560W00426  
 PUMP TEST 21 JAN 83  
 SEMI-LOG PLOT

COMPILED D.E.B.D.A.	SCALE PLAN NUMBER
DRAWN G.B.	DATE 27 JUN 84
CHECKED	S17433

\* Check applicability of this method

DEPARTMENT OF MINES AND ENERGY SOUTH AUSTRALIA		COMPILED DE BDA
LEIGH CREEK COALFIELD LOBE B GROUNDWATER INVESTIGATION 9020W WELL UNIT NO. 6536050W00426		DRAWN G.B.
PUMP TEST 21 JAN 83 LOG-LOG PLOT		DATE 28 JUN 84
FIG...6		SCALE 1:1000
PLAN NUMBER S17435		DATE m/y

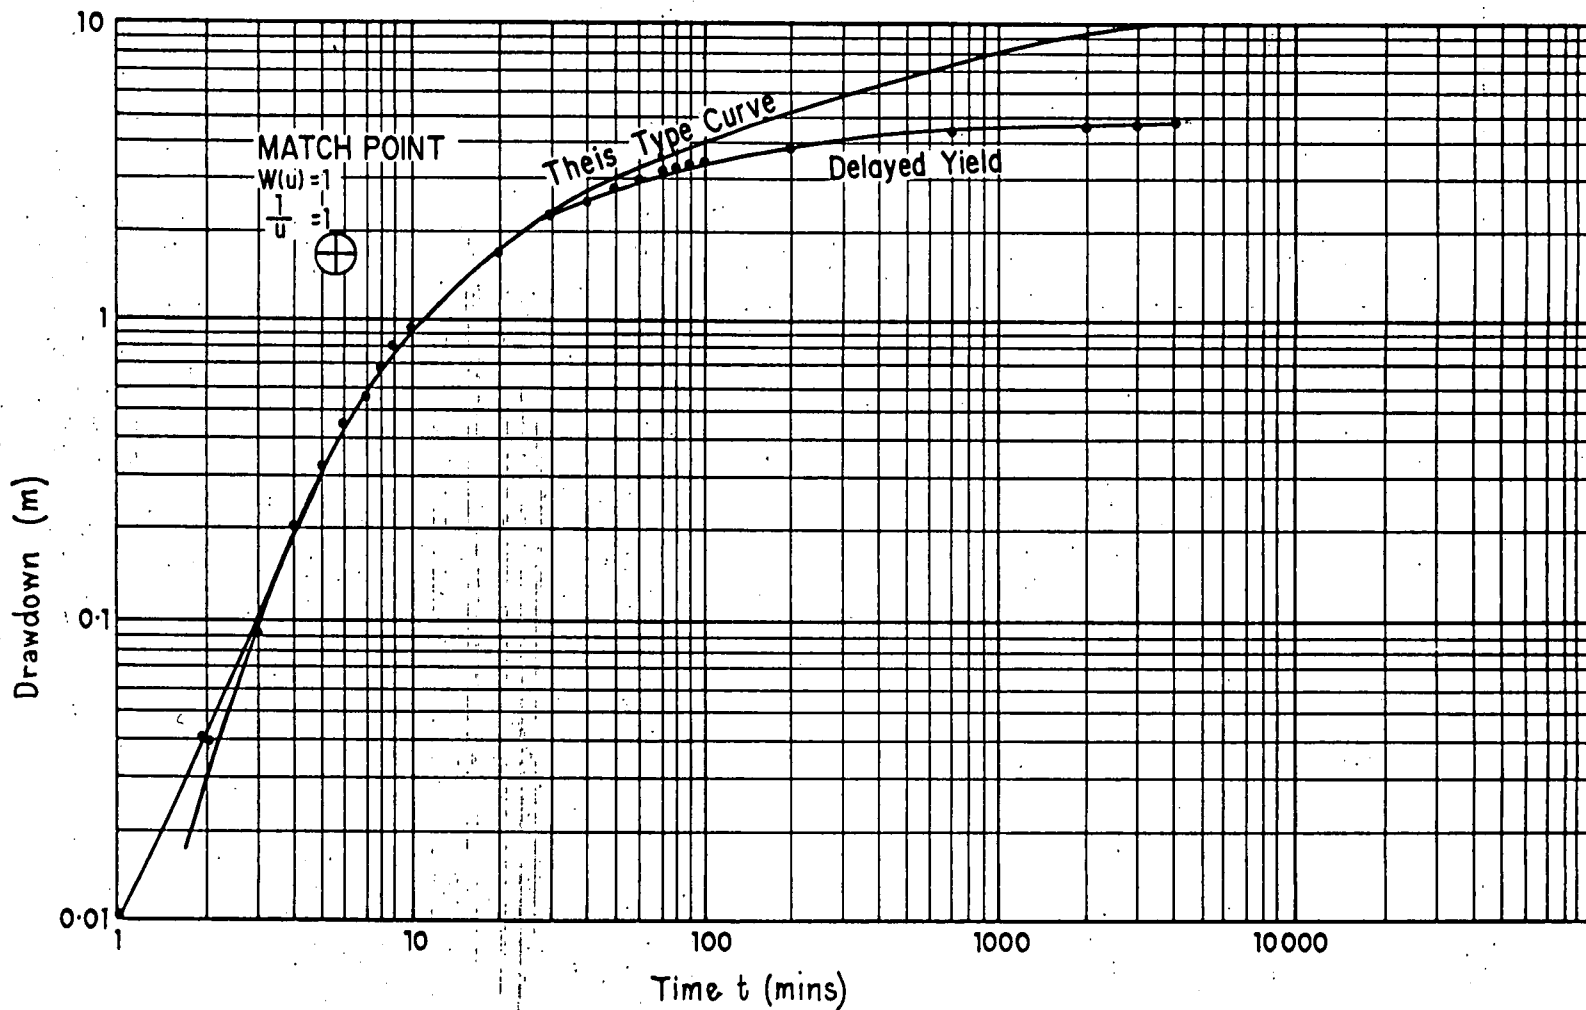

WELL No. \_\_\_\_\_  
 TYPE OF PUMP \_\_\_\_\_  
 DISCHARGE STARTED AT \_\_\_\_\_ ON \_\_\_\_\_  
 DISCHARGE STOPPED AT \_\_\_\_\_ ON \_\_\_\_\_  
 INTERVAL TESTED \_\_\_\_\_ m. to \_\_\_\_\_ m.  
 HOLE DEPTH \_\_\_\_\_ m.

### CALCULATIONS

$Q = 778 \text{ m}^3/\text{day}$


EARLY TIME MATCH POINT  $W_u = 1$   $s = 1.75 \text{ m}$

$$\frac{1}{u} = 1 \quad t = 5.5 \text{ mins}$$

$$T = \frac{Q W(u)}{4 \pi s} = \frac{778 \times 1}{4 \pi \times 1.75} = 35 \text{ m}^3/\text{day}/\text{m}$$

$$S = \frac{4 T t}{r^2} = \frac{4 \times 35 \times 5.5}{97 \times 97 \times 1440} = 5.7 \times 10^{-5}$$



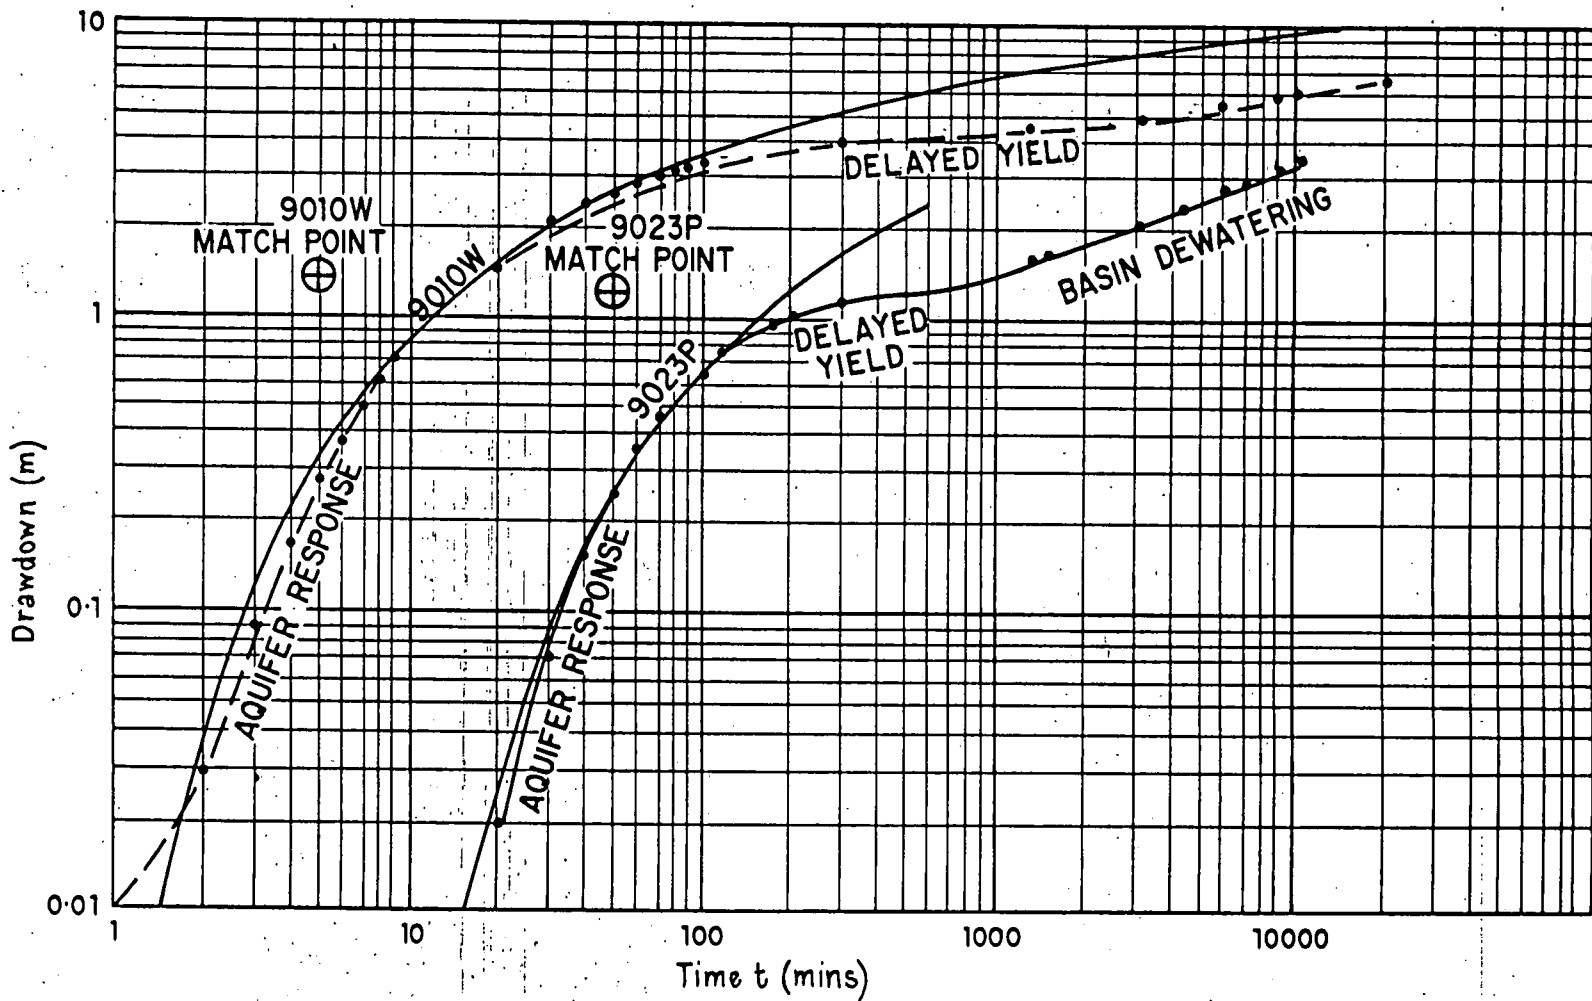

### CALCULATIONS

WELL No. ....

TYPE OF PUMP .....

DISCHARGE STARTED AT ..... ON .....

DISCHARGE STOPPED AT ..... ON .....

INTERVAL TESTED ..... m. to ..... m.

HOLE DEPTH ..... m.

9010W  $r = 97\text{m}$   
 Early t Match Point  
 $W(u) = 1$   $s = 1.5\text{m}$   
 $\frac{1}{u} = 1$   $t = 5\text{mins}$

$$T = \frac{778}{4\pi \times 1.5} = 41 \text{ m}^3/\text{day}/\text{m}$$

$$S = \frac{4 \times 41 \times 5}{97 \times 97 \times 1440} = 6 \times 10^{-3}$$

9023P  $r = 180\text{m}$   
 Early t Match Point  
 $W(u) = 1$   $s = 1.2\text{m}$   
 $\frac{1}{u} = 1$   $t = 52\text{mins}$

$$T = \frac{778}{4\pi \times 1.2} = 52 \text{ m}^3/\text{day}/\text{m}$$

$$S = \frac{4 \times 52 \times 52}{180 \times 180 \times 1440} = 2.3 \times 10^{-4}$$

For all SADME Well Unit Nos see appendix 6

FIG. 8

DEPARTMENT OF MINES AND ENERGY  
SOUTH AUSTRALIA

LEIGH CREEK COALFIELD LOBE B GROUNDWATER INVESTIGATION  
9020W WELL UNIT NO 65360500W00426 PUMP TEST  
12 MAY 83

LOG-LOG PLOT

COMPILED  
D.E.B.D.A.  
DRAWN  
G.B.  
DATE  
28 JUN 84  
CHECKED


SCALE  
PLAN NUMBER  
S17437

LEIGH CREEK COALFIELD LOBE B GROUNDWATER INVESTIGATION  
9010W WELL UNIT NO 65360500W00254 DRAWDOWN  
12 MAY 83

COMPILED DE.B.D.A.	DRAWN G.B.	DATE 28 JUN 84	CHECKED
SCALE 1:500	PLAN NUMBER S17438		

(S.E.T.R.E.M.) N.M.W.O.D.W.A.R.D. = P

Figure 9

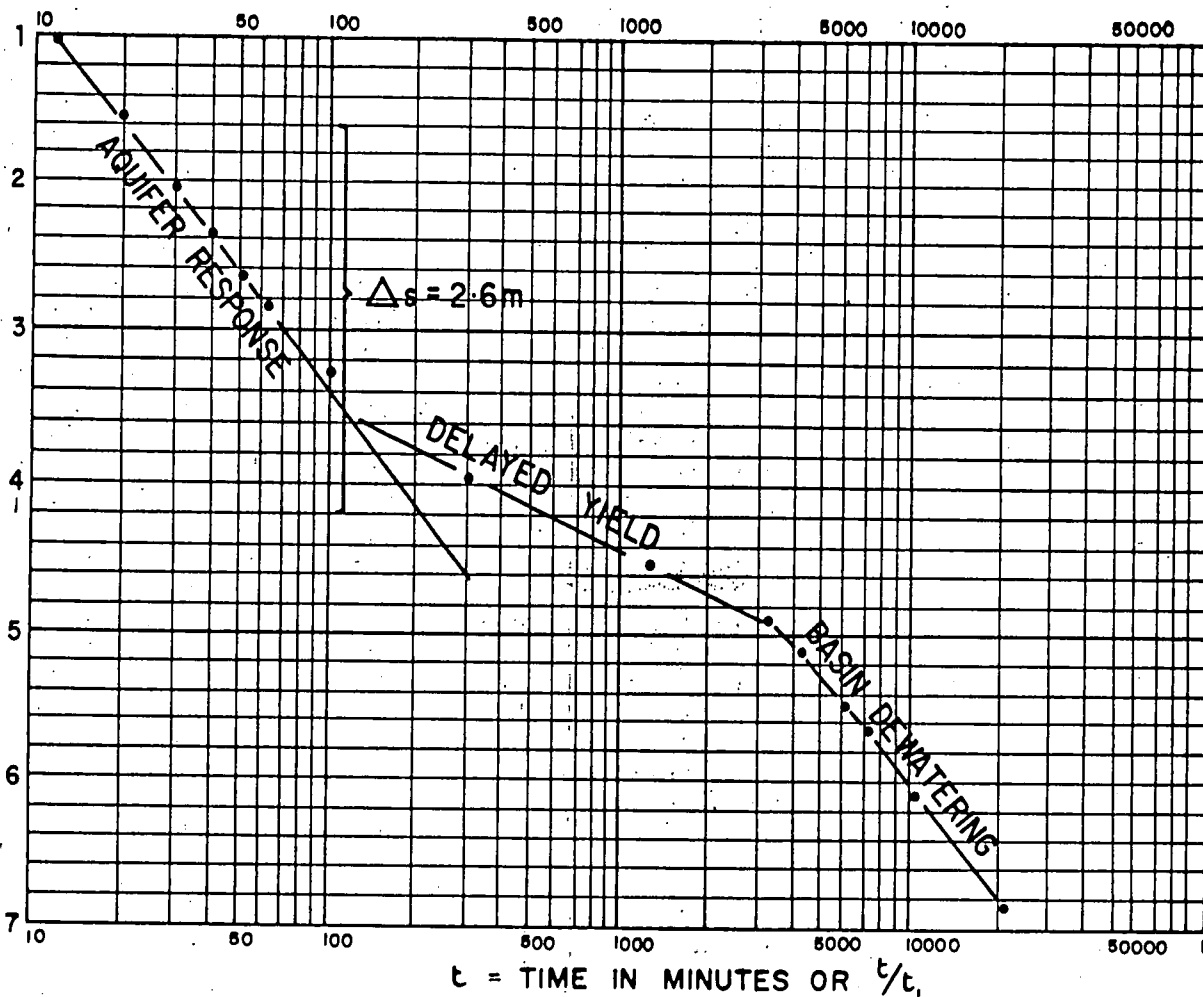

DATA

Q 778m<sup>3</sup>/d  
Δs 2.6  
t<sub>0</sub>

CALCULATIONS

T Early t =  $\frac{0.183 \times 778}{2.6}$   
= 55m<sup>3</sup>/d/m

PROJECT No. 9010W  
PRODUCTION/OBSERVATION WELL  
INTERVAL TESTED  
From ..... m. to ..... m.  
HOLE DEPTH ..... m.  
AQUIFER THICKNESS ..... m.  
DEPTH OF PUMP INTAKE ..... m.  
DEPTH OF WATER LEVEL  
AT TEST START 6.89 m.  
AVAILABLE DRAWDOWN ..... m.


JACOB EQUATIONS\*

$T = \frac{0.183 \times Q}{\Delta s}$  in which  
T = Transmissivity (m.<sup>3</sup>/day/m.)  
Q = Pumping rate (m.<sup>3</sup>/day)  
Δs = Drawdown per log cycle (m.)  
 $S = \frac{2.25 \times T t_0}{1440 r^2}$  in which  
S = Storage coefficient  
t<sub>0</sub> = Zero drawdown time (minutes)  
r = Distance to Observation Well (m.)

27/7/83 SWL 11.69  
12/5/83 SWL 6.89  
Basin dewatered depth 4.80 m

\* Check applicability of this method



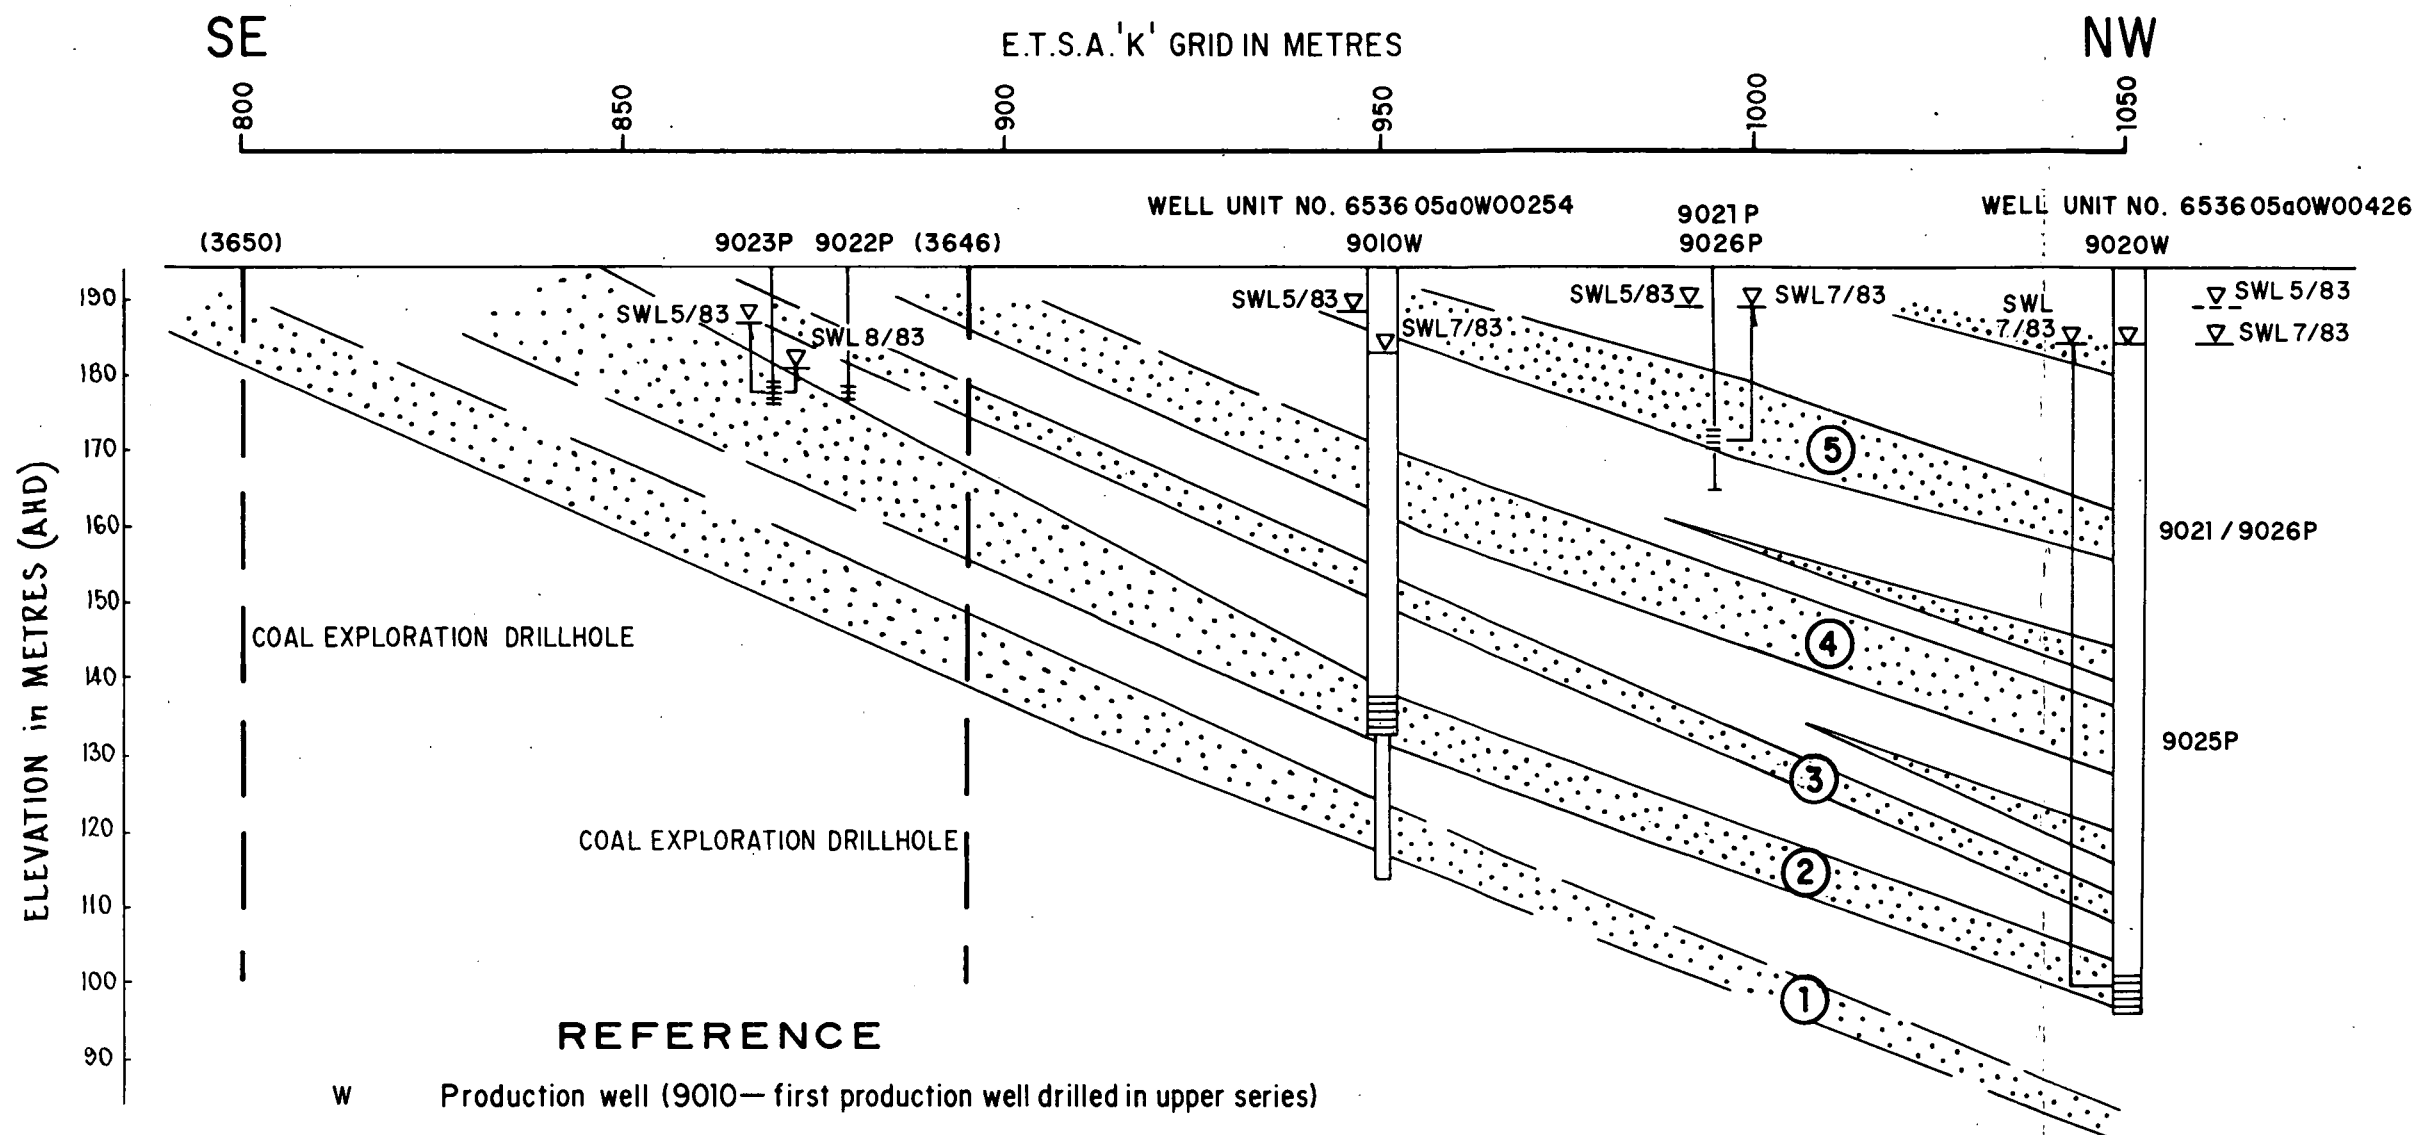

### REFERENCE



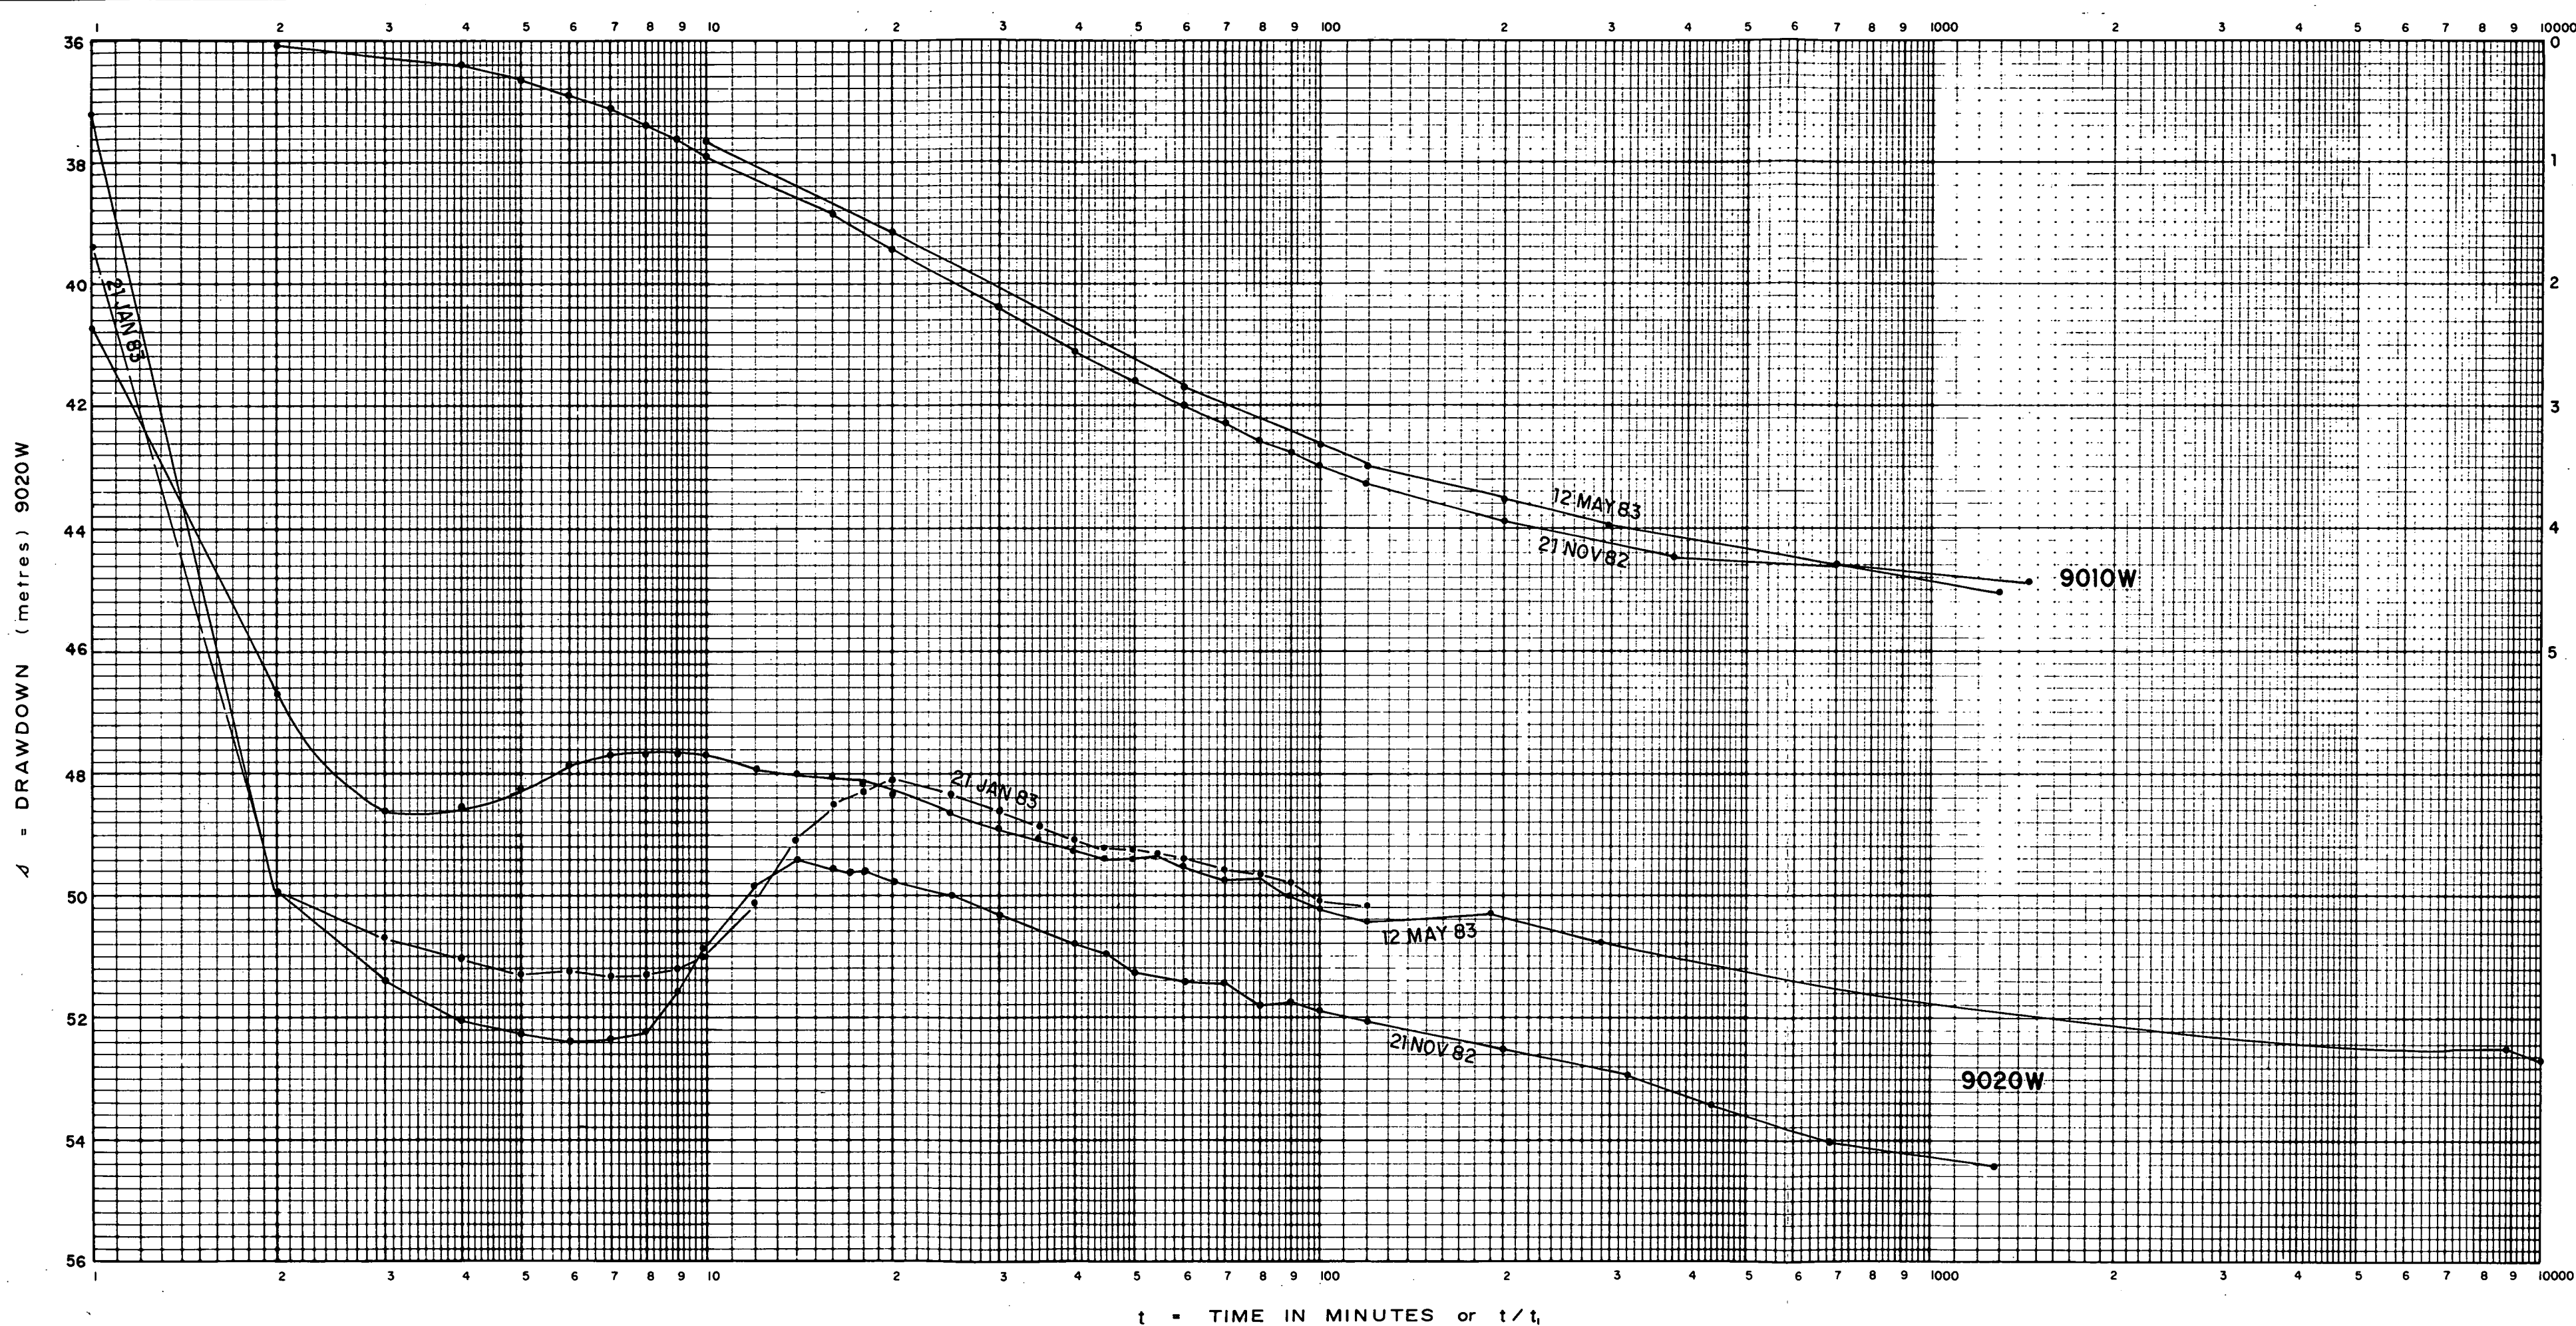
- W Production well (9010— first production well drilled in upper series)
- 9026P Piezometer monitoring effect of 9020W on 'SAND' member 5
- SWL7/83 ▽ Static Water Level at July 1983
-  2nd. 'SAND' member above highest exploitable coal seam
- For all SADME Well Unit Nos see appendix 6

FIG....10

 <b>DEPARTMENT OF MINES AND ENERGY SOUTH AUSTRALIA</b> LEIGH CREEK COALFIELD LOBE B GROUNDWATER INVESTIGATION <b>GENERALISED SECTION U/24 SITE</b>	COMPILED D.E. & D.A.	<i>W. D. O.</i> 22/11/85 C.D.O. DATE
	DRAWN G.B.	SCALE
	DATE 29 JUN 84	PLAN NUMBER
	CHECKED	84-275



WELL UNIT No. ....  
REFERENCE POINT ..... m above ground  
AQUIFER from ..... to ..... m  
INTERVAL TESTED from ..... to ..... m

TYPE OF PUMP .....  
LENGTH OF TEST .....  
DEPTH PUMP INTAKE ..... m  
DEPTH WATER LEVEL  
AT START OF TEST ..... m  
AVAILABLE DRAWDOWN ..... m

#### EQUATIONS

$$T = \frac{0.183 \times Q}{\Delta s} \quad S = \frac{2.25 \times T t_0}{r^2}$$

In which

T = Transmissivity (m<sup>3</sup>/day/m)  
Q = Pumping rate (m<sup>3</sup>/day)  
Δs = Drawdown per log cycle (m)  
S = Storage Coefficient  
t<sub>0</sub> = Zero drawdown time (mins.)  
r = Distance to observation well (m)  
1 day = 8.64 x 10<sup>4</sup> secs

#### DATA

Q      Δs      t<sub>0</sub>      r

#### CALCULATIONS

For all SADME Well Unit Nos' see appendix 6

Figure 11

		DEPARTMENT OF MINES AND ENERGY SOUTH AUSTRALIA	
LEIGH CREEK COALFIELD LOBE B GROUNDWATER INVESTIGATION		COMPILED D.E. S.D.A.	<i>W. D. D.</i> <i>W.D.</i> DATE
9020W WELL UNIT NO. 6536050W00426		DRAWN G.B.	SCALE
EARLY TIME RESPONSE		DATE 11 JUL 84	PLAN NUMBER 84-276
		CHECKED	


LEIGH CREEK COALFIELD LOBE B GROUNDWATER INVESTIGATION  
9020W WELL UNIT NO. 653605d0W00426  
DISTANCE VERSUS DRAWDOWN TEST 24 JUL 83

**DEPARTMENT OF MINES AND ENERGY  
SOUTH AUSTRALIA**



$s$  = DRAWDOWN ( METRES )

### RADIUS OF 9020W

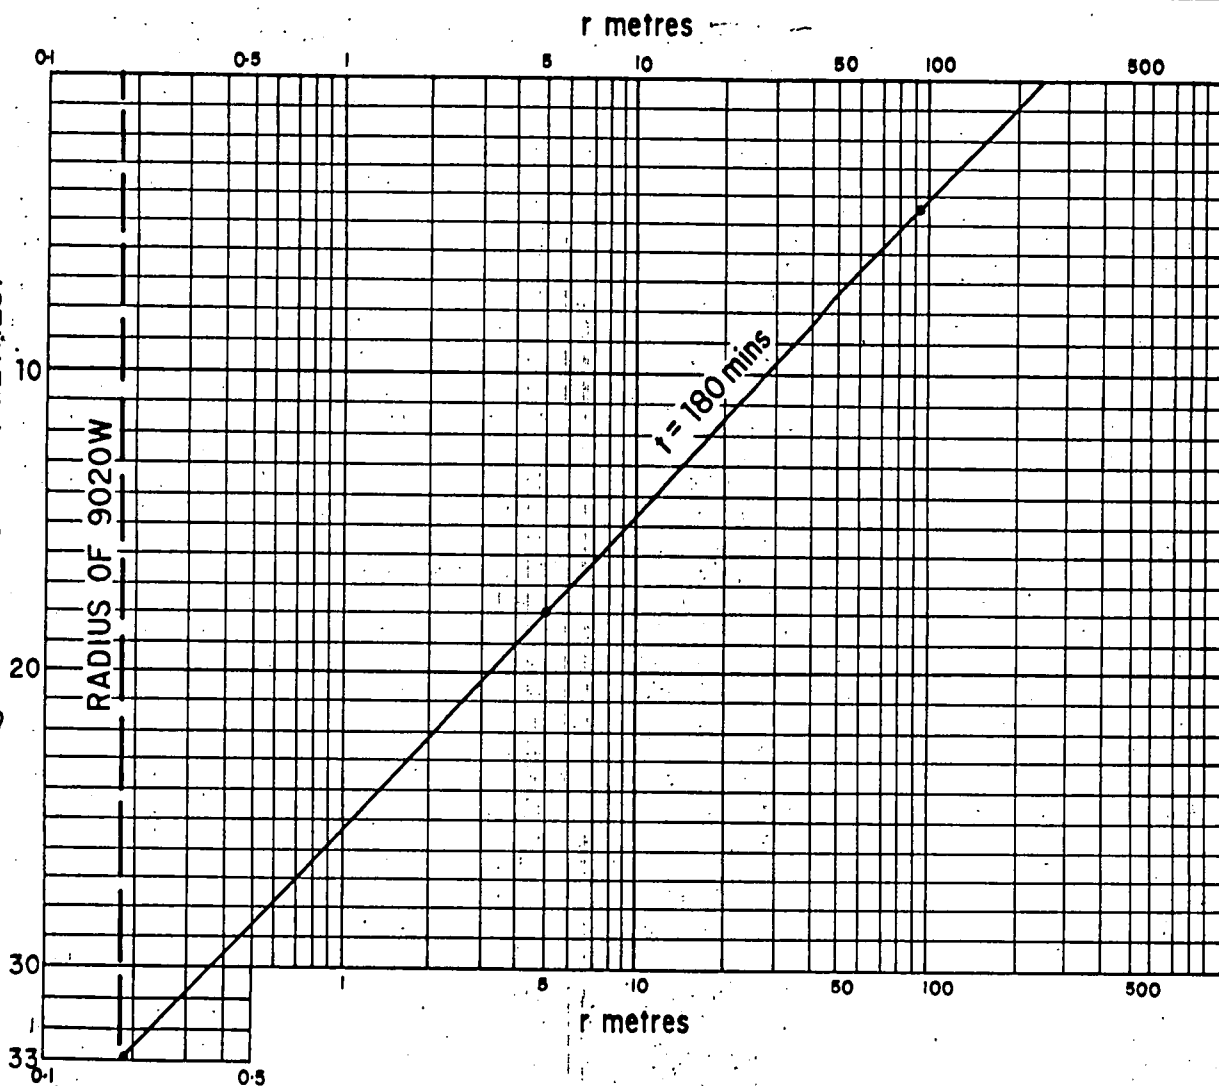

## DATA

## CALCULATIONS

PROJECT No. 9020W  
 PRODUCTION/OBSERVATION WELL  
 INTERVAL TESTED

From \_\_\_\_\_ m. to \_\_\_\_\_ m.  
HOLE DEPTH \_\_\_\_\_ m.  
AQUIFER THICKNESS \_\_\_\_\_ m.  
DEPTH OF PUMP INTAKE \_\_\_\_\_ m.  
DEPTH OF WATER LEVEL  
AT TEST START \_\_\_\_\_ m.  
AVAILABLE DRAWDOWN \_\_\_\_\_ m.

# JACOB EQUATIONS\*

$$T = \frac{0.366 \times Q}{\Delta \phi} \quad \text{in which}$$

T = Transmissivity (m.<sup>3</sup>/day/m.)

$Q$  = Pumping rate ( $\text{m}^3/\text{day}$ )

 $\Delta s$  = Drawdown per log cycle (m.)

$$S = \frac{2.25 \times T_{10}}{1440 r^2} \quad \text{in which}$$

**S = Storage coefficient**

to = Zero drawdown time (minutes)

**r = Distance to Observation Well (m.)**

 $s = \text{RESIDUAL DRAWDOWN (METRES)}$ 

**Figure 12**

For all SADME Well Unit No's see appendix 6

\* Check applicability of this method

**COMPILED  
D.E.B.D.A.**

**DRAW**  
**6.B.**

DATE  
29 JUN

**CHECKED**

DATE 07/08

**SCALE**

PLAN NUMBER


517439

9024P & 9025P WELL UNIT NO. 65360500W00319 & 320  
RESPONSE 26 JUL 83 & 9 AUG 83

LEIGH CREEK COALFIELD LOBE B GROUNDWATER INVESTIGATION

DEPARTMENT OF MINES AND ENERGY  
SOUTH AUSTRALIA

Δ4206 (METRES) NWDOWN = Δ

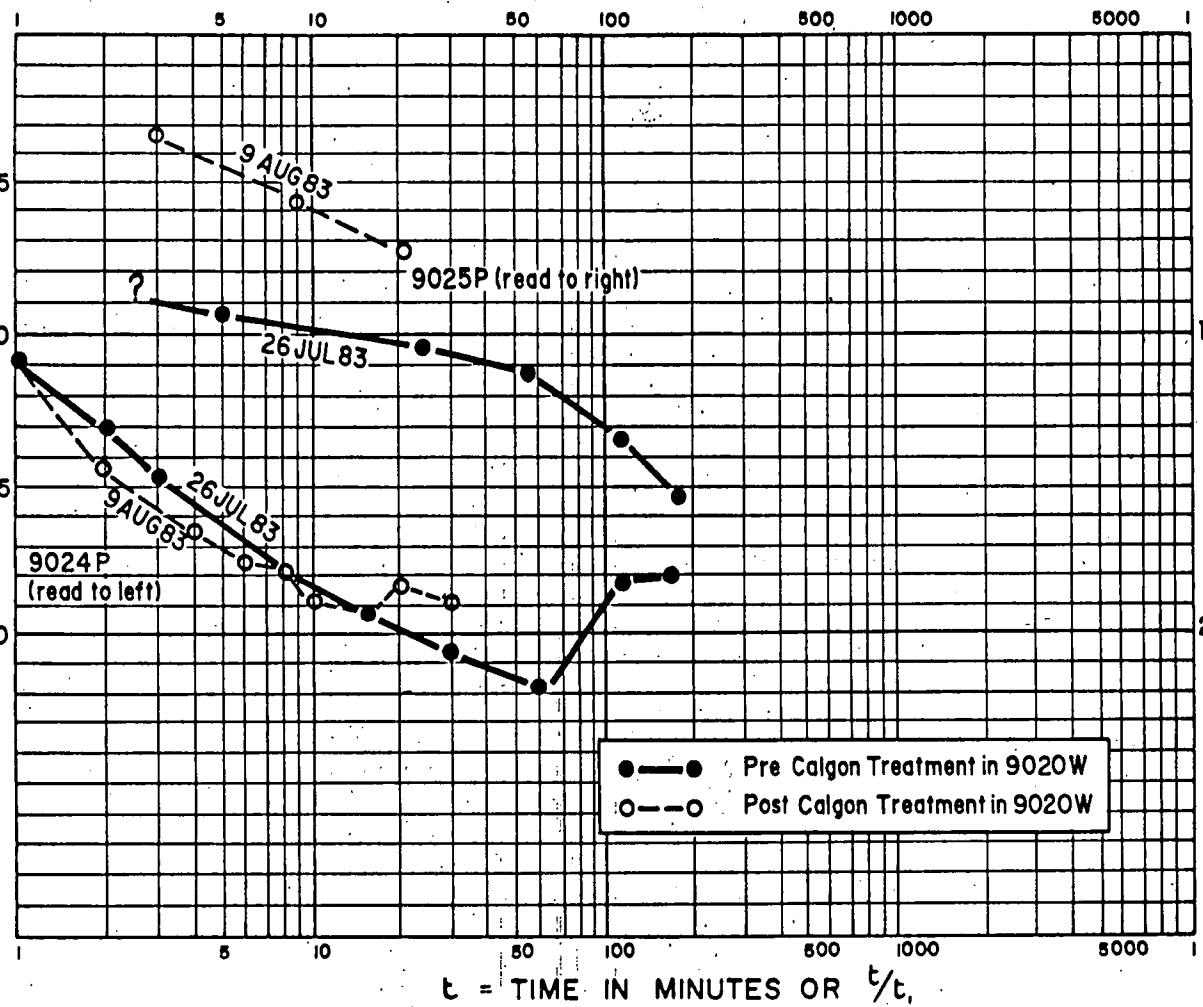

t = TIME IN MINUTES OR t/t<sub>0</sub>

DATA

CALCULATIONS

PROJECT No. 9024P & 9025P  
PRODUCTION/OBSERVATION WELL  
INTERVAL TESTED From .....m. to .....m.  
HOLE DEPTH.....m.  
AQUIFER THICKNESS.....m.  
DEPTH OF PUMP INTAKE.....m.  
DEPTH OF WATER LEVEL  
AT TEST START .....m.  
AVAILABLE DRAWDOWN.....m.

JACOB EQUATIONS\*

$$T = \frac{0.183 \times Q}{\Delta\Delta} \quad \text{in which}$$

T = Transmissivity (m.<sup>3</sup>/day/m.)  
Q = Pumping rate (m.<sup>3</sup>/day)  
ΔΔ = Drawdown per log cycle (m.)

$$S = \frac{2.25 \times T t_0}{1440 r^2} \quad \text{in which}$$

S = Storage coefficient  
t<sub>0</sub> = Zero drawdown time (minutes)  
r = Distance to Observation Well (m.)

Figure 13

For all SADME Well Unit No's see appendix 6

\* Check applicability of this method

COMPILED D.E.B.D.A.	SCALE f.c.d.o.	DATE 29 JUN 84	PLAN NUMBER S17440
DRAWN G.B.		CHECKED	


S

N

WELL UNIT NO  
65376rOW00598(PROJECTED)  
9041P

9043/4P

9040W

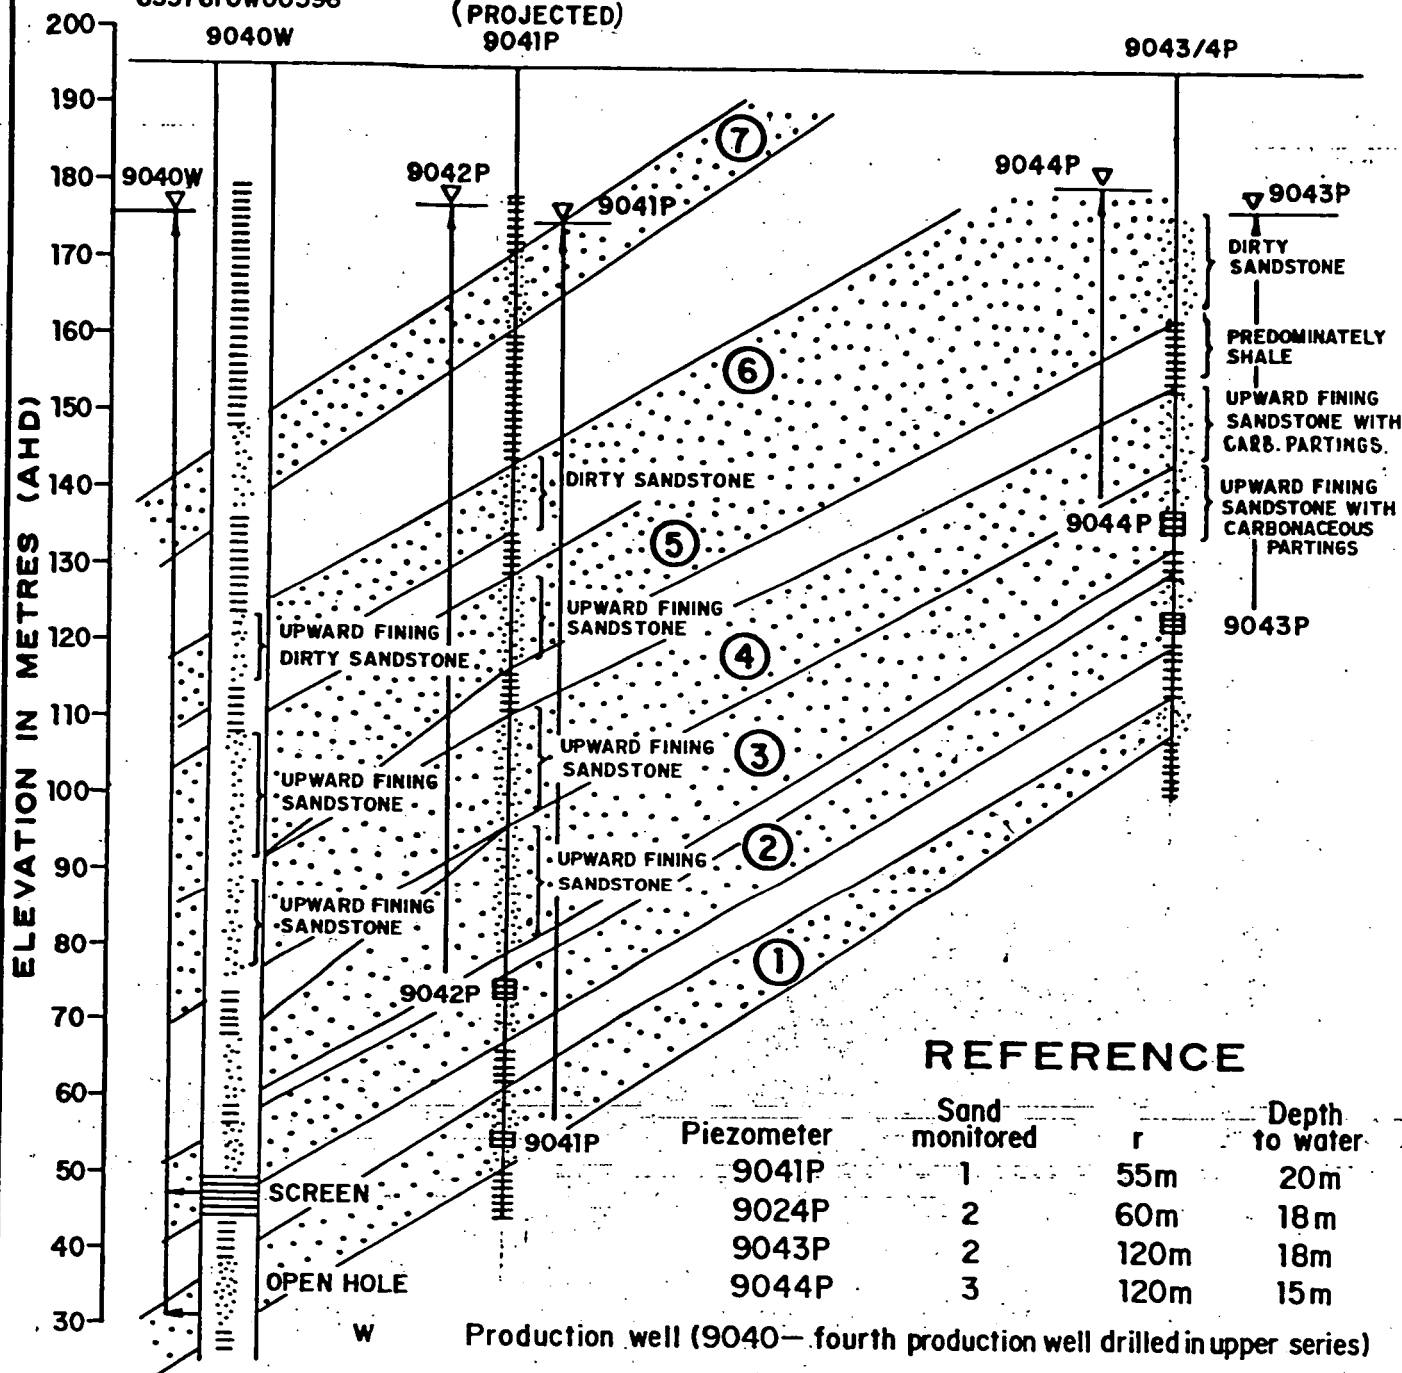

Production well (9040— fourth production well drilled in upper series)

Piezometer monitoring effect of 9040W on 'SAND' member 3

2nd 'SAND' member

For all SADME Well Unit Nos see appendix 6

9044P

②

SCALE

METRES 20 0 20 40 METRES

FIG....14

DEPARTMENT OF MINES AND ENERGY  
SOUTH AUSTRALIA

LEIGH CREEK COALFIELD LOBE B GROUNDWATER INVESTIGATION

GENERALISED SECTION U/25 SITE

COMPILED  
D.E. & D.A.

CD O DATE

DRAWN  
G.B.

SCALE 1:1000

DATE  
2 JUL 84


PLAN NUMBER

CHECKED

S17441

DEPARTMENT OF MINES AND ENERGY  
SOUTH AUSTRALIA  
LEIGH CREEK COALFIELD LOBE B GROUNDWATER INVESTIGATION  
OBSERVATION WELLS 9041P, 9042P  
AIRLIFTING 9040W WELL UNIT NO.65374610W00598

(SHEET NO) NW040W = P

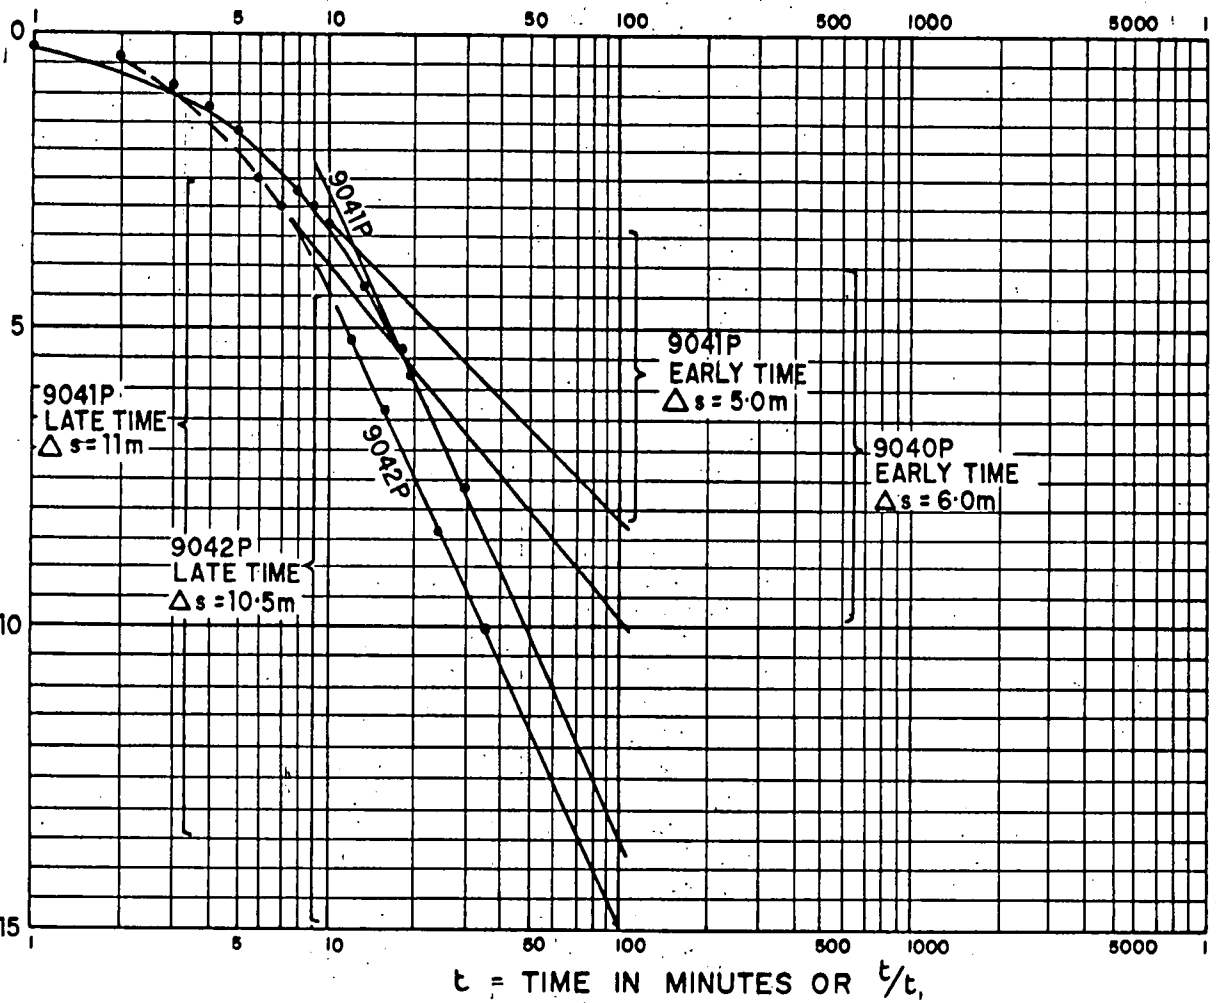

Δs = RESIDUAL DRAWDOWN (METRES)

PROJECT No. 9040W  
PRODUCTION/OBSERVATION WELL  
INTERVAL TESTED From .....m. to .....m.  
HOLE DEPTH .....m.  
AQUIFER THICKNESS .....m.  
DEPTH OF PUMP INTAKE .....m.  
DEPTH OF WATER LEVEL AT TEST START .....m.  
AVAILABLE DRAWDOWN .....m.

**JACOB EQUATIONS\***

$$T = \frac{0.183 \times Q}{\Delta s} \text{ in which}$$

$T$  = Transmissivity ( $m^3/day/m$ )  
 $Q$  = Pumping rate ( $m^3/day$ )  
 $\Delta s$  = Drawdown per log cycle ( $m$ )

$$S = \frac{2.25 \times T t_0}{1440 r^2} \text{ in which}$$

$S$  = Storage coefficient  
 $t_0$  = Zero drawdown time (minutes)  
 $r$  = Distance to Observation Well ( $m$ )

**DATA**

Q	Δs	t <sub>0</sub>
9040W 3456m <sup>3</sup> /d		

**CALCULATIONS**

SAND1 9041P	$T = \frac{0.183 \times 1728}{5} = 63m^3/day/m$	* BOUNDARY AT 10 MINS.
SAND1 LATE TIME	$T = \frac{0.183 \times 1728}{11} = 29m^3/day/m$	
SAND2 9042P	$T = \frac{0.183 \times 1728}{6} = 53m^3/day/m$	* BOUNDARY AT 8 MINS
SAND2 LATE TIME	$T = \frac{0.183 \times 1728}{10.5} = 30m^3/day/m$	

For all SADME Well Unit No's see appendix 6


\* Assumes Q 9040W = 40L/sec and each sand provides half of discharge. \* Check applicability of this method

Figure 15

COMPILED D.E.B.D.A.	DRAWN G.B.	DATE 3 JUL 84
SCALE 1:1000	PLAN NUMBER S17442	CHECKED

S


N

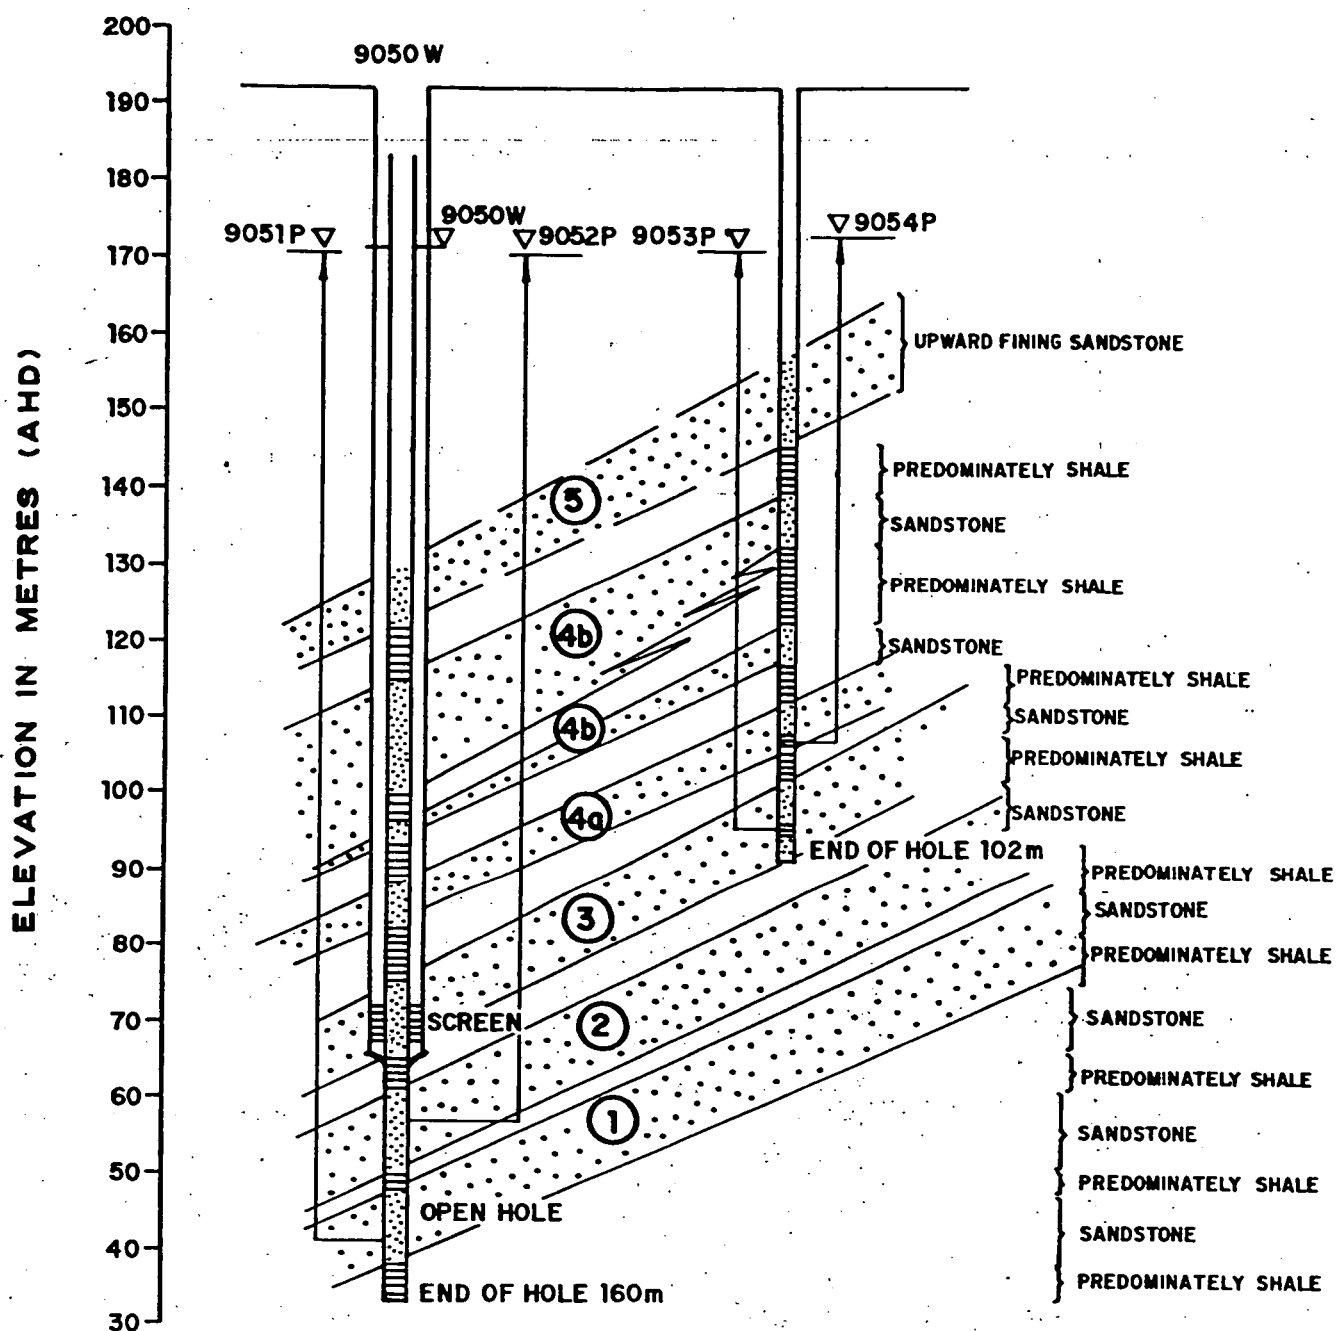


## REFERENCE

- W Production well (9050—fifth production well drilled in upper series.)
- 9051P Piezometer monitoring effect of 9050W on 'SAND' member 1
- ② 2nd 'SAND' member
- For all SADME Well Unit No's see appendix 6

FIG....16

 <b>DEPARTMENT OF MINES AND ENERGY SOUTH AUSTRALIA</b> LEIGH CREEK COALFIELD LOBBE GROUNDWATER INVESTIGATION <b>GENERALISED SECTION U/27 SITE</b>	COMPILED D.E.B.D.A.	W for CDO DATE
	DRAWN G.B.	SCALE
	DATE 5 JUL 84	PLAN NUMBER
	CHECKED	S17443

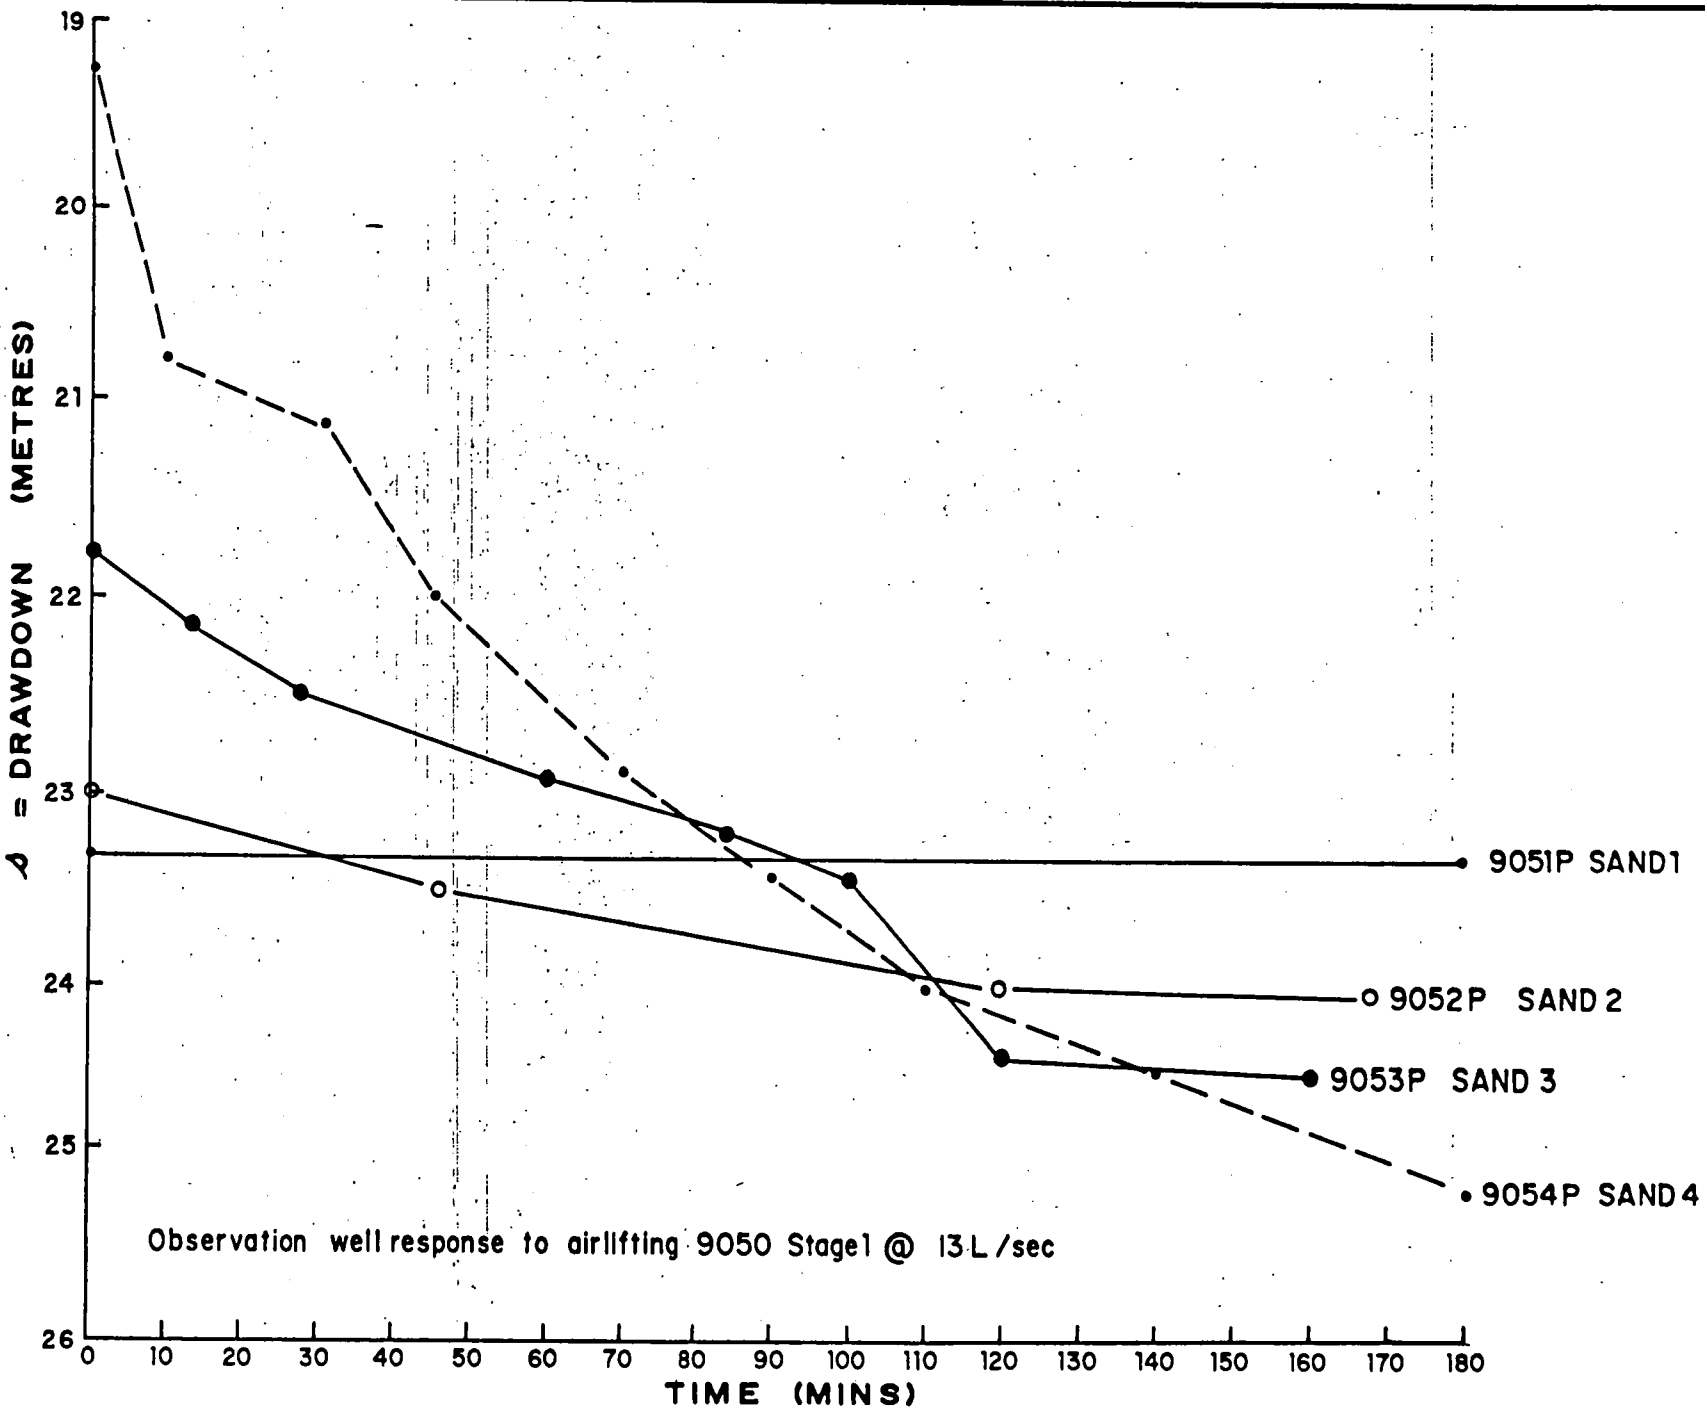




LEIGH CREEK COALFIELD LOBE B GROUNDWATER INVESTIGATION  
9050W WELL UNIT NO. 653747NOW00532  
STAGE 1 AIRLIFT  
SEMI-LOG PLOT



DEPARTMENT OF MINES AND ENERGY  
SOUTH AUSTRALIA

(SEMI-LOG) DRAWN = P

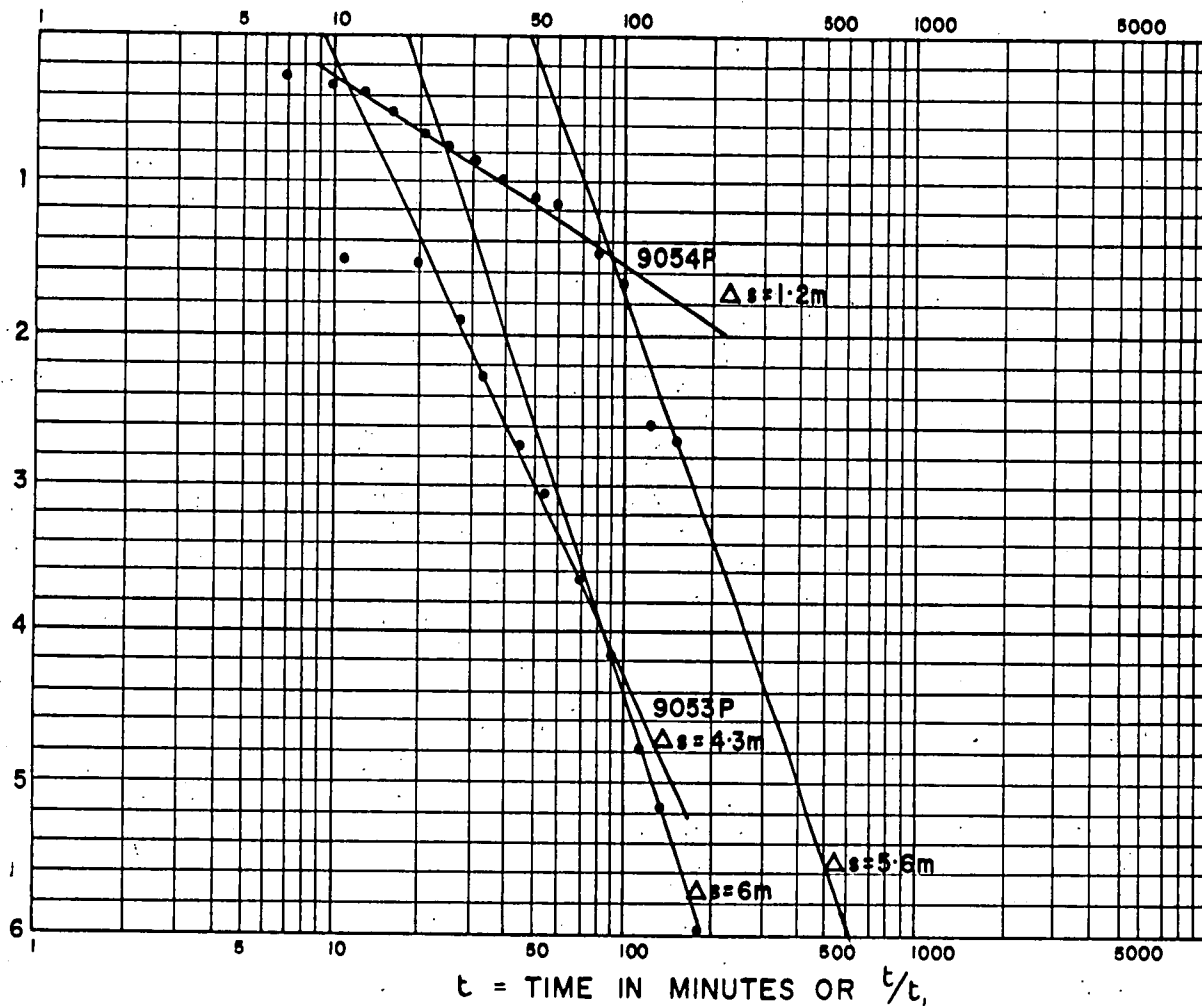

### DATA

Q = 13L/sec after 100 mins.  
Δs = 1.2m  
t₀ = 100 mins.  
r = 100m

### CALCULATIONS

FOR  $t > 100$  mins.

ASSUME: 6.4L/sec for SAND 3 ( $\Delta s = 6m$ )

5L/sec for SAND 4 ( $\Delta s = 5.6m$ )

1.6L/sec derived from SAND 2 via leakage through 3239

$$T \text{ SAND 3} = \frac{0.183 \times 550}{6} = 17 \text{ m}^3/\text{d}/\text{m}$$

$$T \text{ SAND 4} = \frac{0.183 \times 432}{5.6} = 14 \text{ m}^3/\text{d}/\text{m}$$

PROJECT No. 9050W  
PRODUCTION/OBSERVATION WELL  
INTERVAL TESTED

From .....m. to .....m.  
HOLE DEPTH .....m.  
AQUIFER THICKNESS .....m.  
DEPTH OF PUMP INTAKE .....m.  
DEPTH OF WATER LEVEL  
AT TEST START .....m.  
AVAILABLE DRAWDOWN .....m.

### JACOB EQUATIONS\*

$$T = \frac{0.183 \times Q}{\Delta s} \quad \text{in which}$$

T = Transmissivity ( $\text{m}^3/\text{day}/\text{m}$ )

Q = Pumping rate ( $\text{m}^3/\text{day}$ )

$\Delta s$  = Drawdown per log cycle (m.)

$$S = \frac{2.25 \times T t_0}{1440 r^2} \quad \text{in which}$$

S = Storage coefficient

t₀ = Zero drawdown time (minutes)

r = Distance to Observation Well (m.)

For all SADME Well Unit No's see appendix 6

\* Check applicability of this method

Figure 18

COMPILED D.E. & D.A.	DATE 4 JUL 84	CHECKED
DRAWN G.B.	SCALE	PLAN NUMBER
AS	1:1000	S17445
DATE 24/9/84		


LEIGH CREEK COALFIELD LOBBE B GROUNDWATER INVESTIGATION  
9050W WELL UNIT NO. 653747NOW00532  
STAGES 2 & 3 LINEAR SCALE PLOT

DEPARTMENT OF MINES AND ENERGY  
SOUTH AUSTRALIA

FIG. 19

OBSERVATION WELL WATER LEVEL  
METRES BELOW TOP OF CASTING

AIRLIFT Q (L/sec)

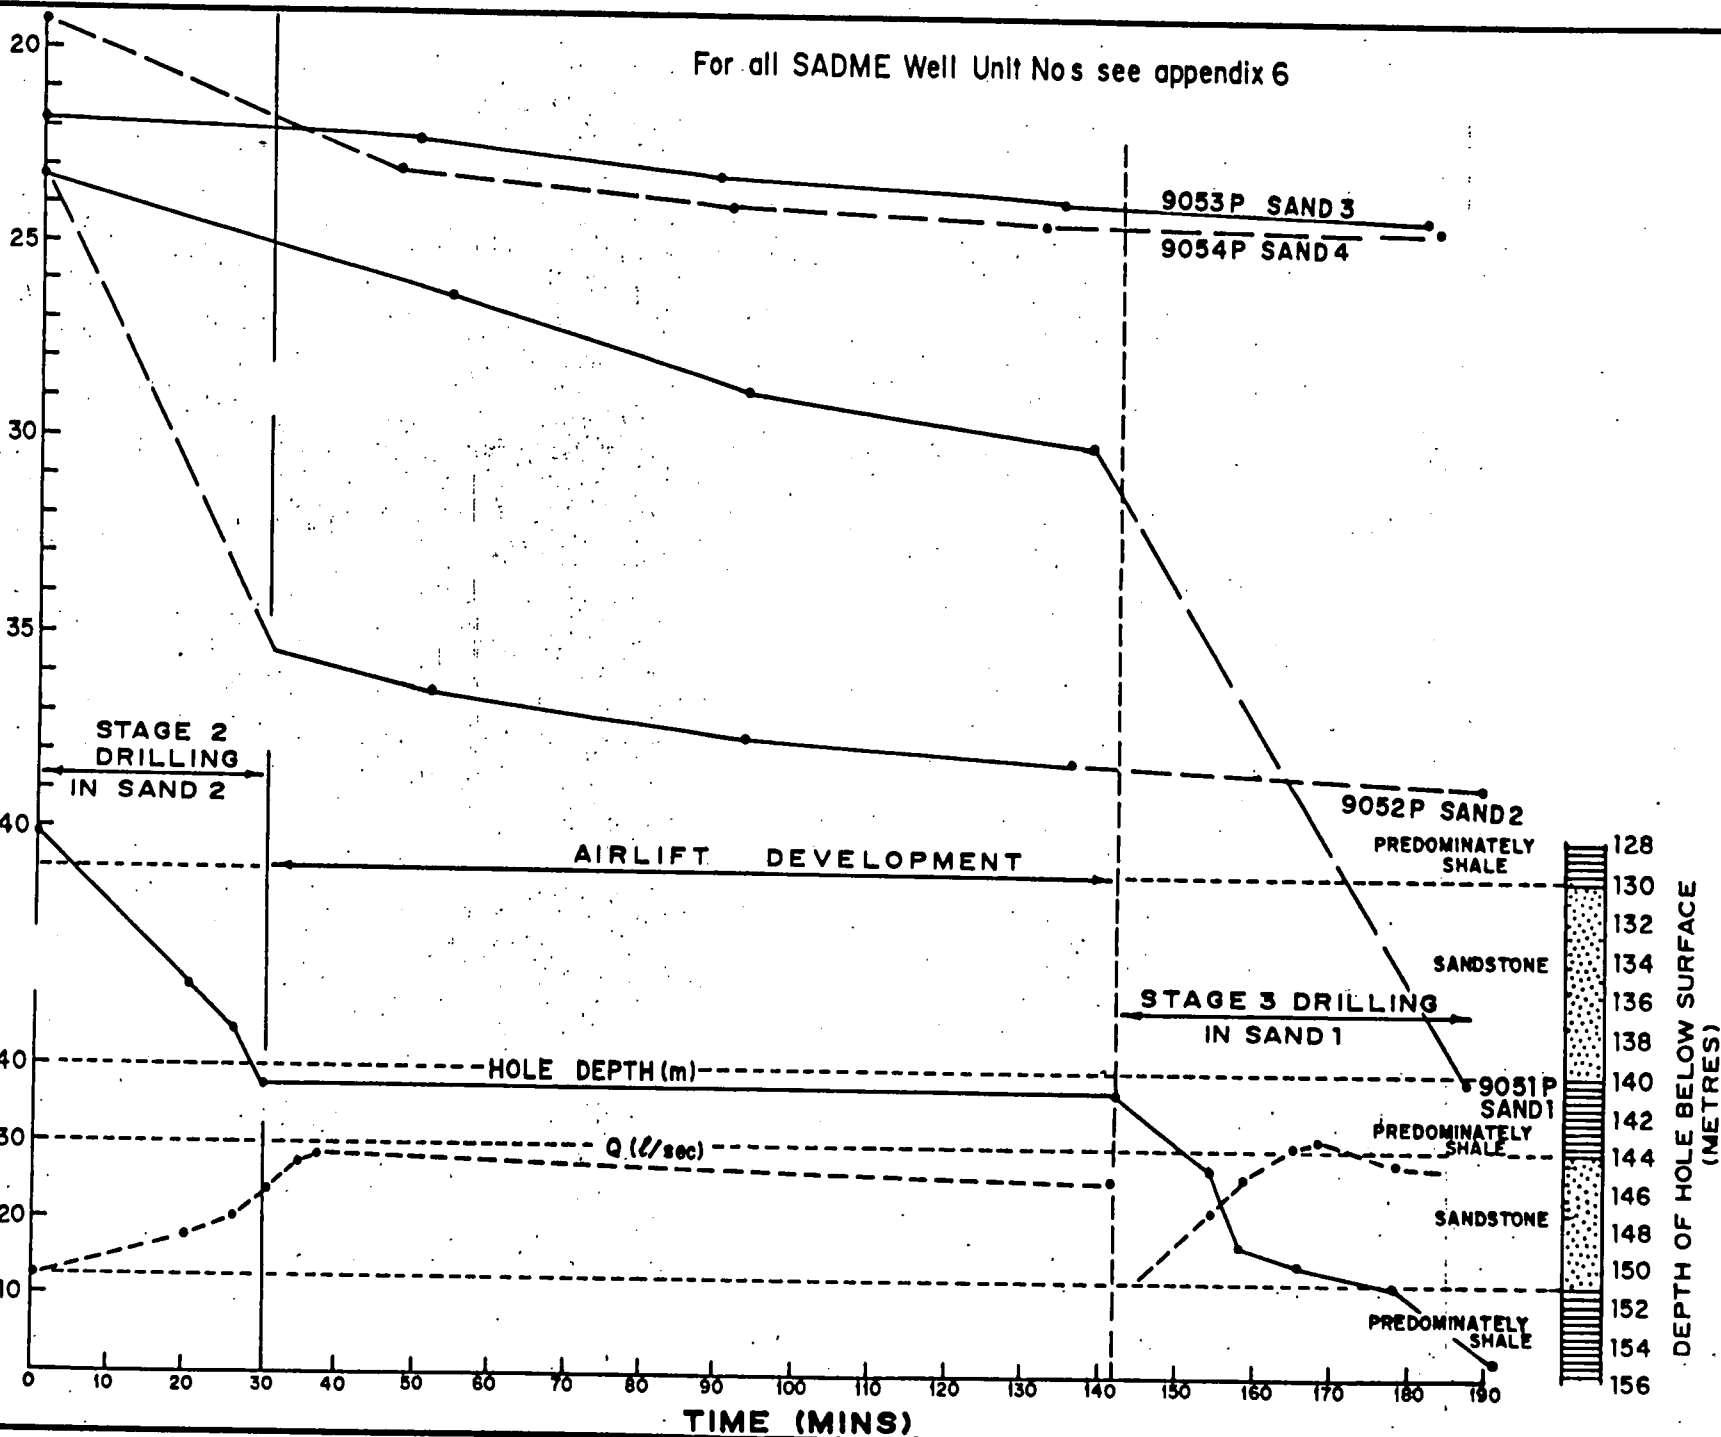

COMPILED D.E.B.D.A.	DATE 6 JUL 84	CHECKED
DRAWN G.B.	SCALE PLAN NUMBER	
S17446		

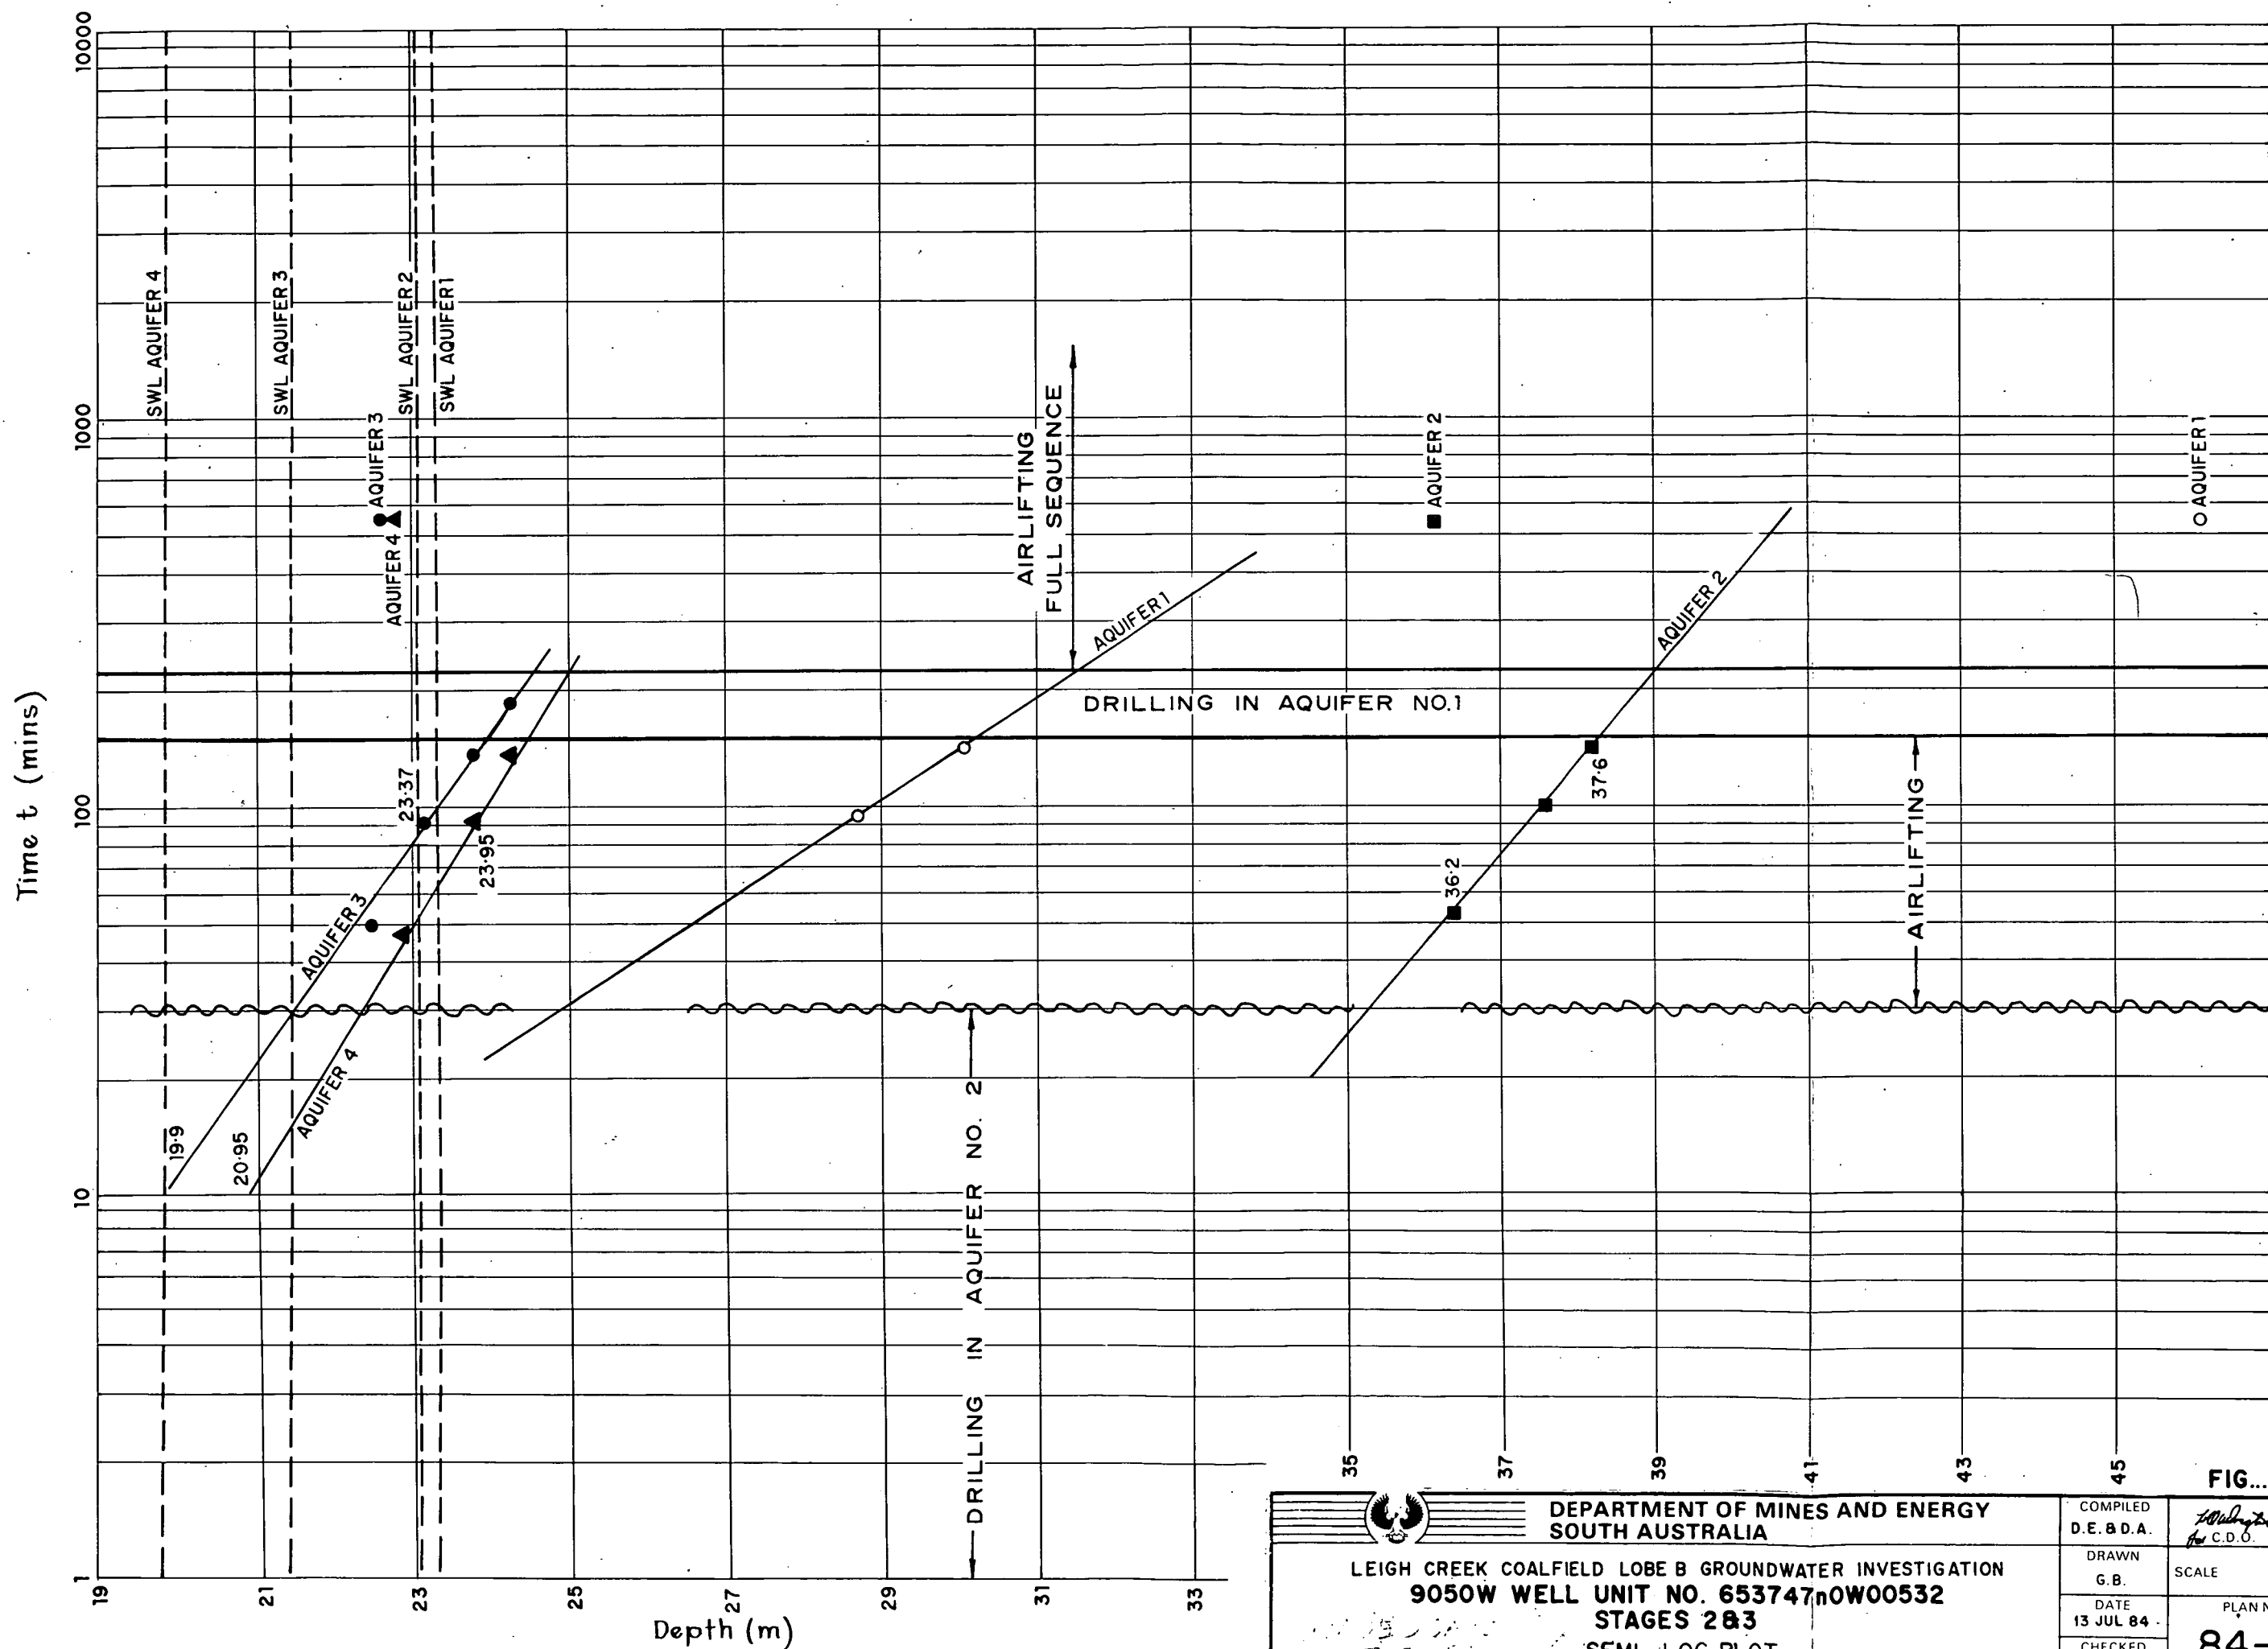


FIG...20

<p>DEPARTMENT OF MINES AND ENERGY SOUTH AUSTRALIA</p>		<p>COMPILED D.E. &amp; D.A.</p>	<p><i>W. D. D. A.</i> <i>21/11/84</i> for C.D.O. DATE</p>
<p>LEIGH CREEK COALFIELD LOBE B GROUNDWATER INVESTIGATION 9050W WELL UNIT NO. 653747nOW00532 STAGES 2&amp;3 SEMI-LOG PLOT</p>		<p>DRAWN G.B.</p>	<p>SCALE</p>
<p>DATE 13 JUL 84</p>		<p>CHECKED</p>	<p>PLAN NUMBER <b>84-277</b></p>

# E.T.S.A. CORED HOLE NO. 3239

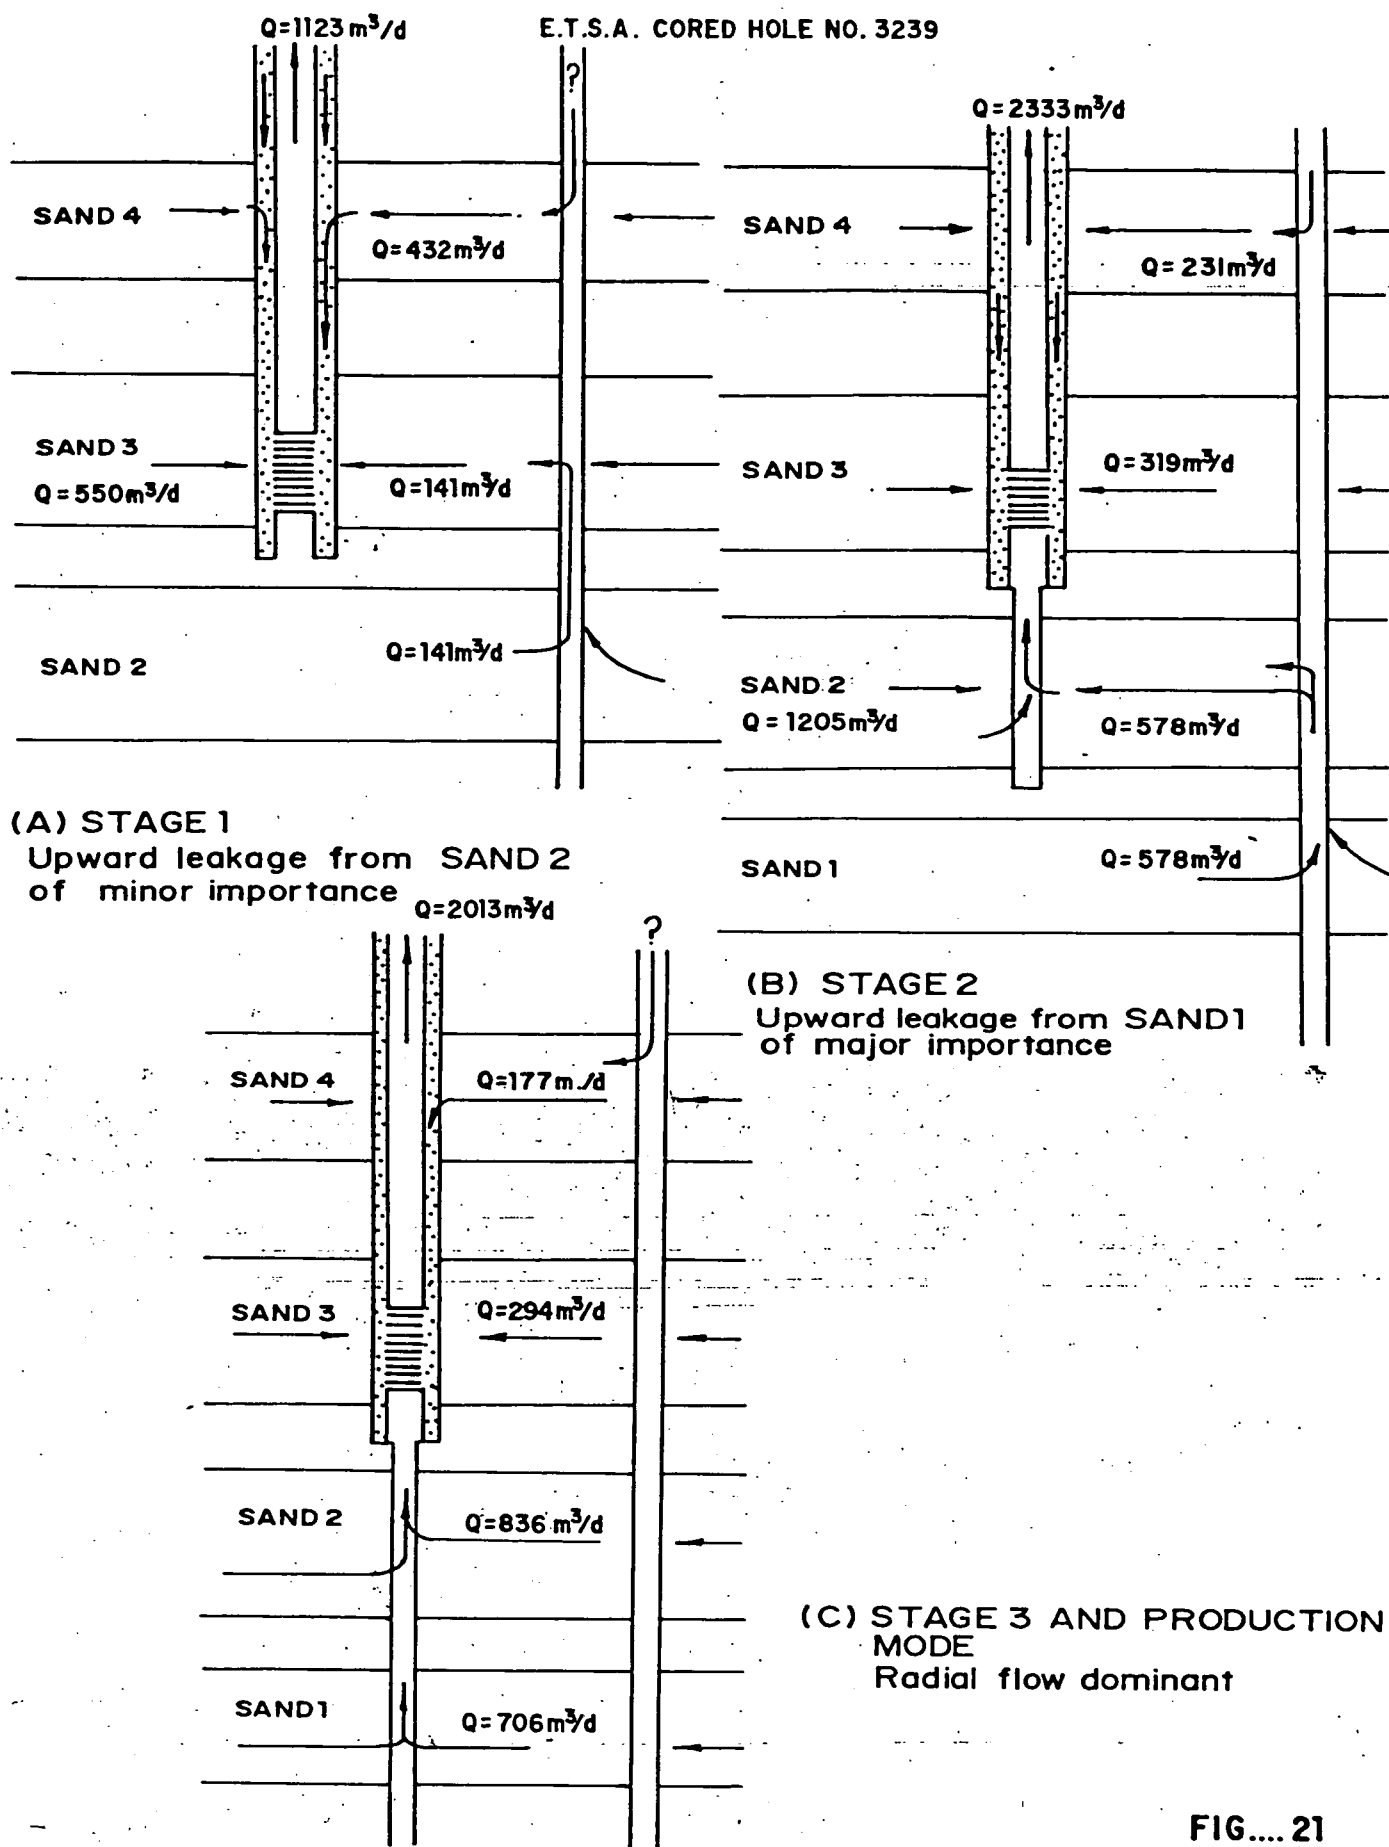


FIG.... 21



DEPARTMENT OF MINES AND ENERGY  
SOUTH AUSTRALIA

LEIGH CREEK COALFIELD LOBE B GROUNDWATER INVESTIGATION  
9050W WELL UNIT NO. 653747n0W00532  
BEHAVIOUR DURING CONSTRUCTION

COMPILED  
D.E. & D.A.

W C D O DATE

DRAWN  
G.B.

SCALE

DATE  
11 JUL 84

PLAN NUMBER

CHECKED

S17447

LEIGH CREEK COALFIELD LOBE B GROUNDWATER INVESTIGATION  
 9050W WELL UNIT NO. 653747n0W00532  
 PUMP TEST 29AUG83



DEPARTMENT OF MINES AND ENERGY  
 SOUTH AUSTRALIA


COMPILED  
 D.E. & D.A.  
 DRAWN  
 G.B.  
 DATE  
 13 JUL 84  
 CHECKED

PLAN NUMBER  
 S17448

SCALE  
 1:1000  
 DATE  
 2/1/84

(SERIES) NM000000 - P

FIG...22

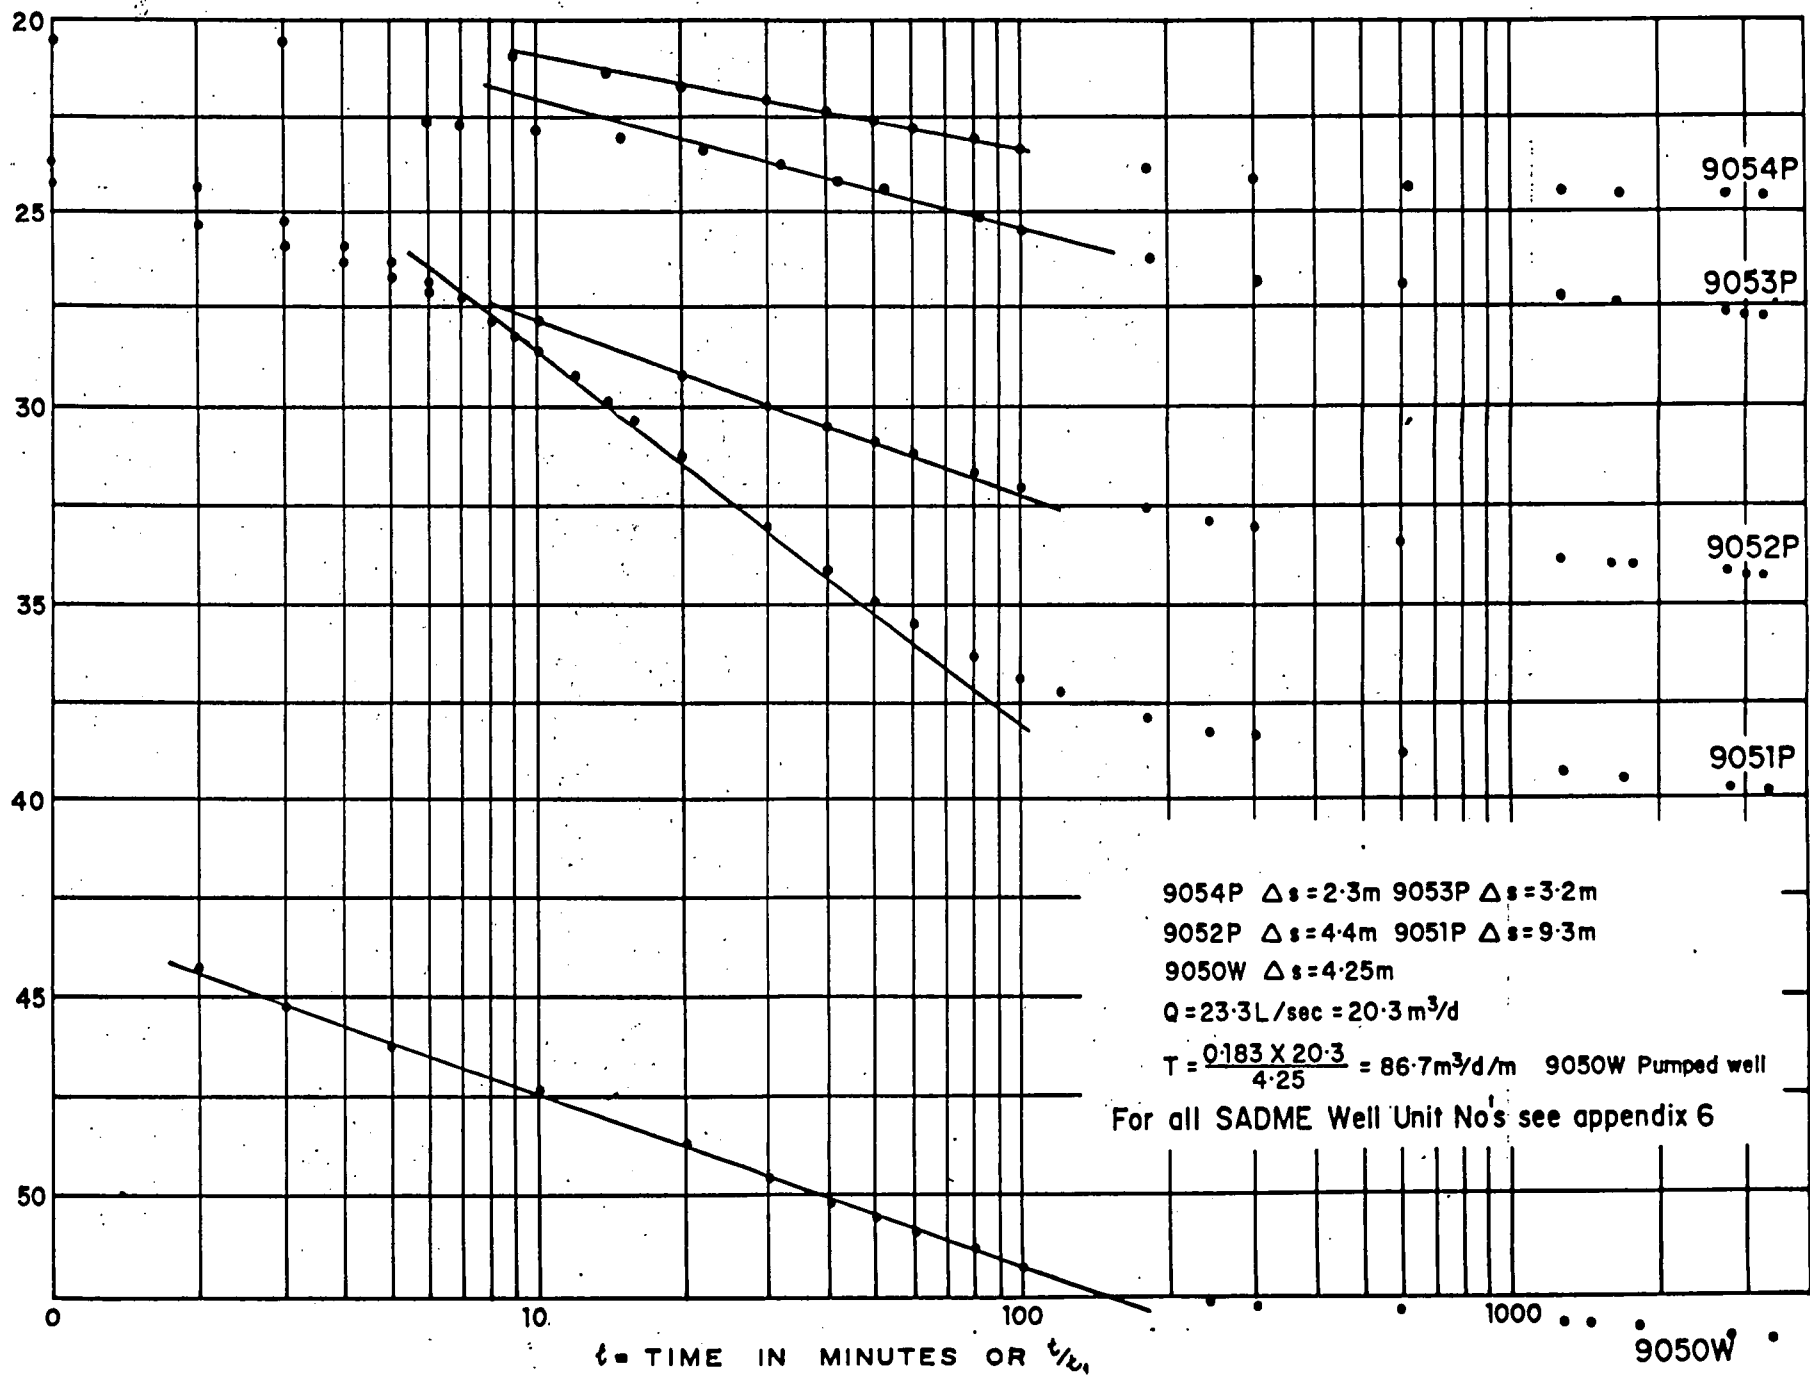

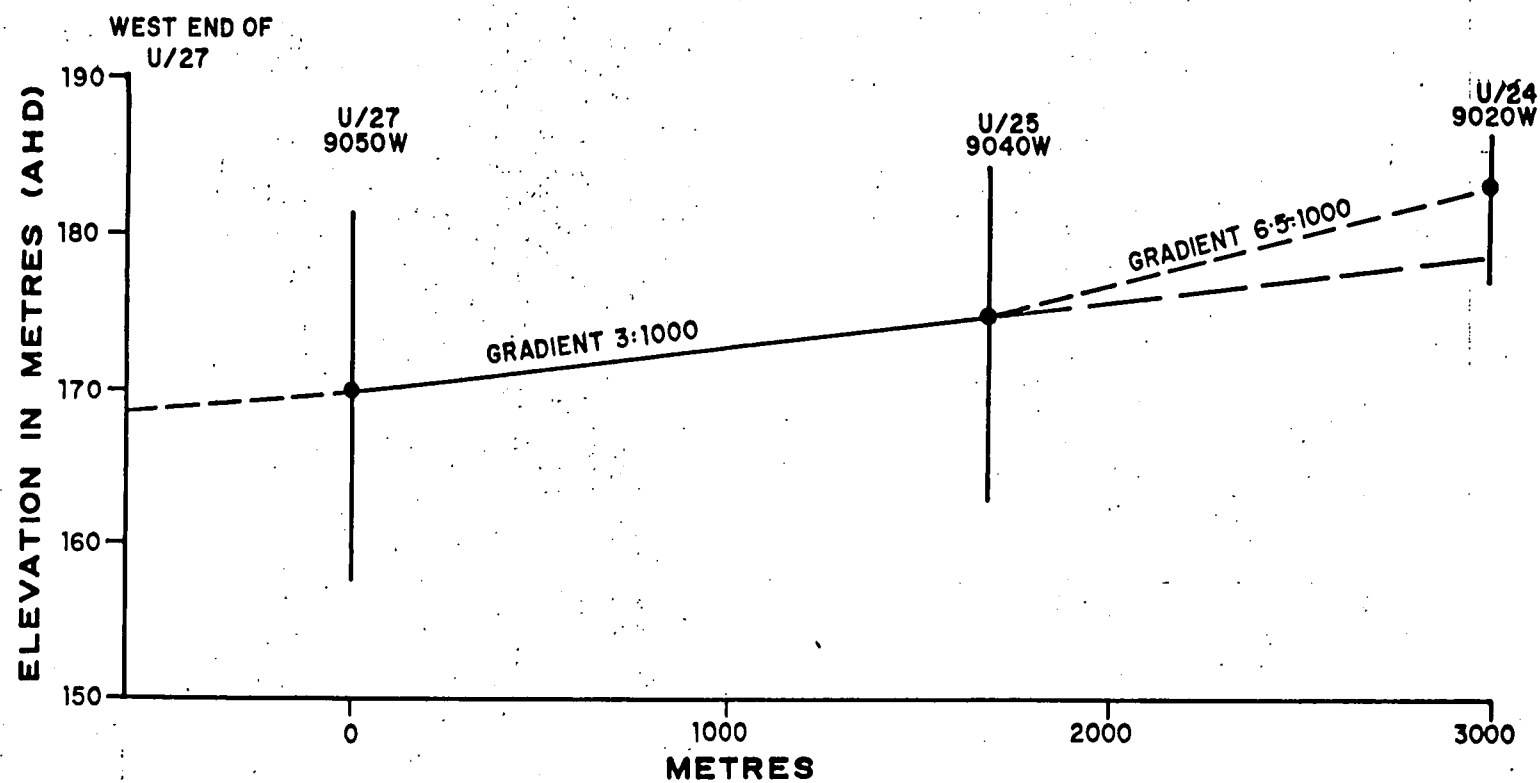


FIG....23

For all SADME Well Unit No's see appendix 6




DEPARTMENT OF MINES AND ENERGY  
SOUTH AUSTRALIA

LEIGH CREEK COALFIELD LOBBE GROUNDWATER INVESTIGATION

## POTENTIOMETRIC GRADIENT

COMPILED	D.E.B. D.A.	SCALE
DRAWN	G.B.	
DATE	4 JUL 84	PLAN NUMBER
CHECKED		S17449

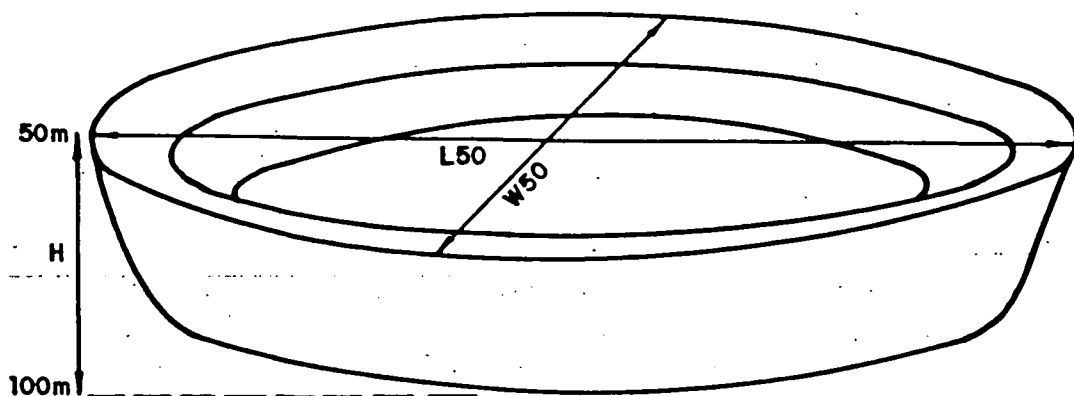

$$\text{Volume of water contained} = \text{Volume sand} \times 0.2 = 2H \left( \frac{L50 + L100}{2} + \frac{W50 + W100}{2} \right) \times 0.2 \times \text{Sand thickness}$$

### SIMPLE GEOMETRIC APPROXIMATION OF BASIN


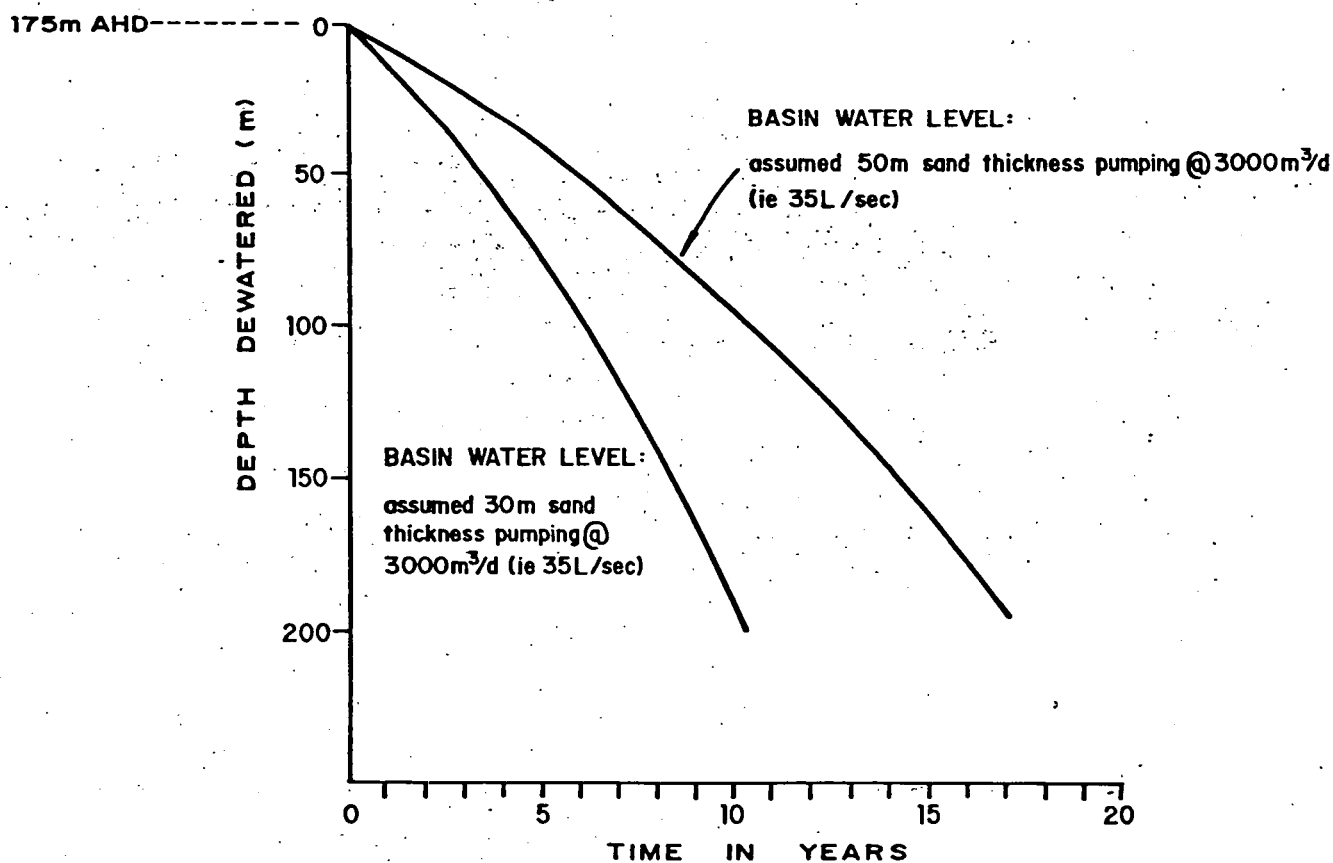



FIG....24


	DEPARTMENT OF MINES AND ENERGY SOUTH AUSTRALIA		COMPILED D.E. & D.A.	for CDO DATE
	LEIGH CREEK COALFIELD LOBE B GROUNDWATER INVESTIGATION		DRAWN G.B.	SCALE
	SIMPLE BASIN MODEL		DATE 12 JUL 84	PLAN NUMBER
			CHECKED	S17450

APPENDIX 1

		<u>Plan No.</u>
U/24 Site Well Locations		S17451
Composite log	9010W	82-335
	9020W	83-504
	9024/5P	83-503
	9026P	83-513
Summary Cuttings Logs	9010W	
	9020W	
	9021P	
	9022P	
	9023P	
	9024/5P	
	9026P	

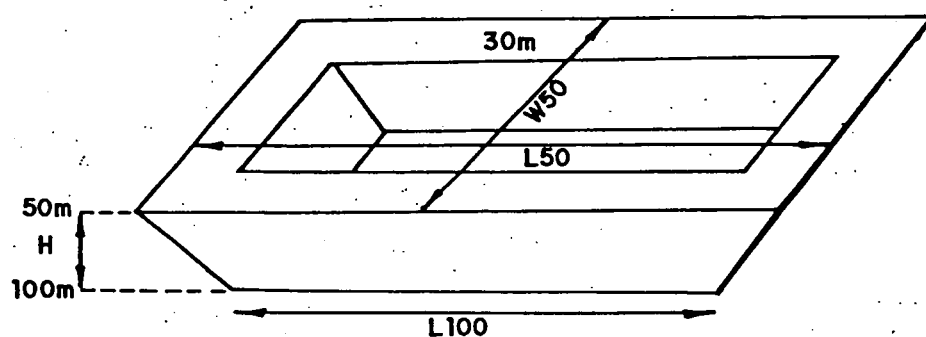


For all SADME Well Unit Nos see appendix 6

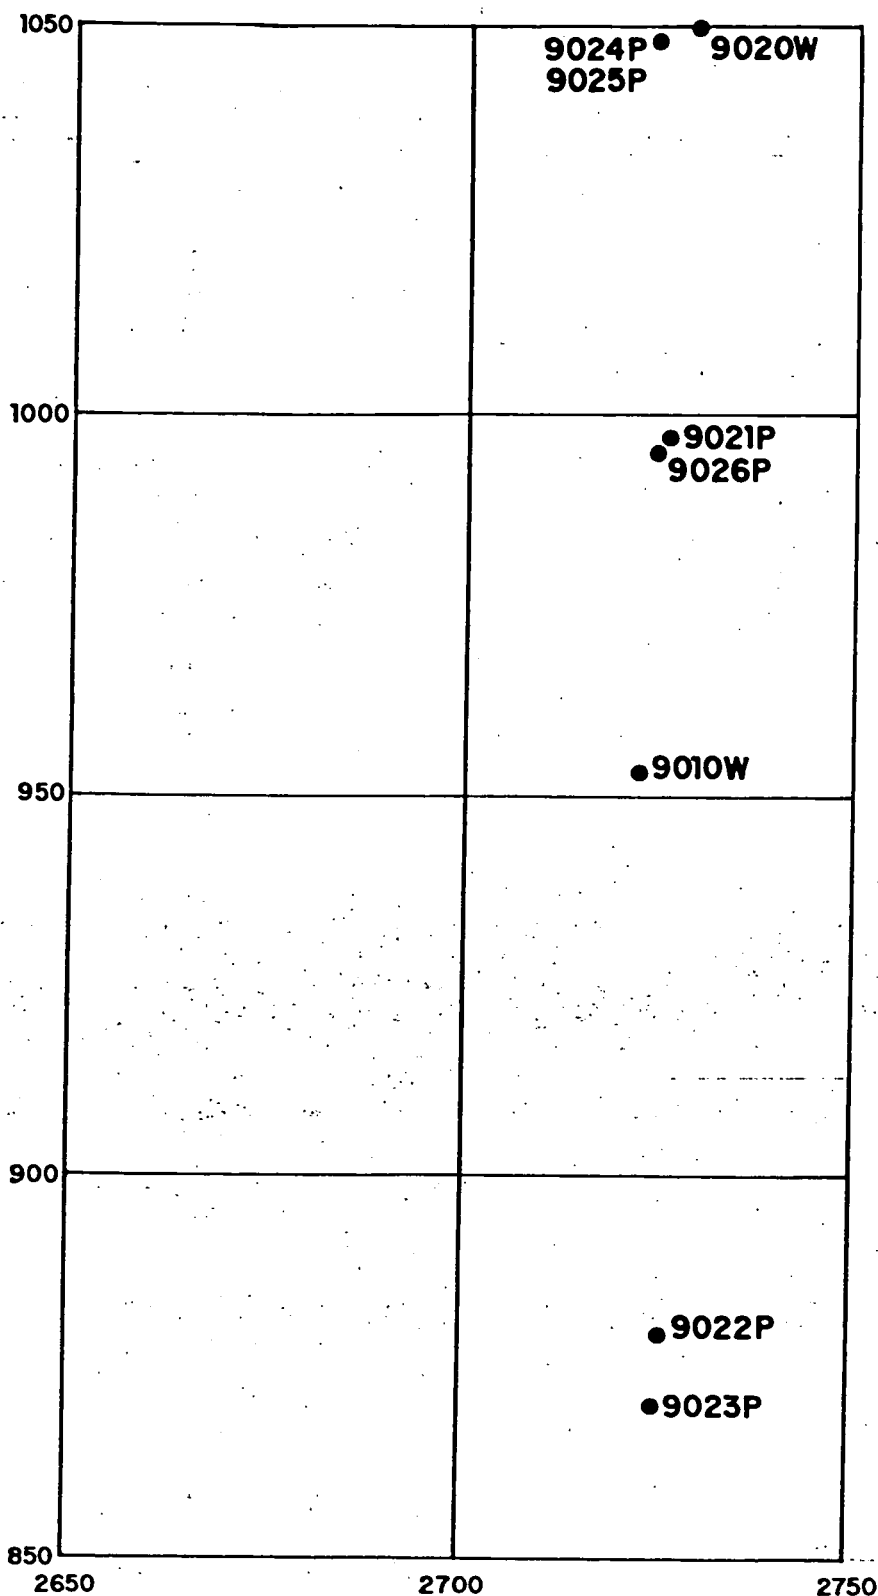

METRES 20 0 20 40 METRES

# APPENDIX 1

 <p>DEPARTMENT OF MINES AND ENERGY SOUTH AUSTRALIA</p>	COMPILED D.E. & D.A.		5 fcd o	DATE
	DRAWN G.B.		SCALE 1:1000	
	DATE 19 JUL 84		PLAN NUMBER	
	CHECKED		S17451	

LEIGH CREEK COALFIELD LOBE B GROUNDWATER INVESTIGATION

U/24 SITE WELL LOCATIONS

E.T.S.A. 'K' GRID

DEPARTMENT OF MINES & ENERGY - SOUTH AUSTRALIA  
ENGINEERING DIVISION

## COMPOSITE WELL LOG - GROUNDWATER

HOLE No. H.O.B. 1

UNIT/STATE No.  
6536 05a 0W 00254

PERMIT No. 10530

FOLDER No.

DRG. No. 82 - 335

## CONSTRUCTION DETAILS

DRILLING TECHNIQUE: ROTARY  
CIRCULATION: MUD  
START: 20/5/82  
FINISH: 22/5/82  
TOTAL DEPTH: 94 mPROJECT LEIGH CREEK INDUSTRIAL WATER SUPPLY - LOBE B  
UPPER SERIES DRILLING

LOCATION S.E. CORNER OF LOBE B

SECTION HUNDRED

CO-ORDINATES EAST K 2722.8 m

NORTH 953.5 m

LOGGED BY D. R. EDWARDS

REFERENCE ELEV. Top of PVC. 194.72 DATE 20/5/82

SURFACE ELEV. TRACED BY A.D.

DATUM metres A.H.D. DATE 6th July 1982

TYPE OF LOG	16 IN. NORMAL	64 IN. NORMAL	6 FT. LATERAL	S.P.	POINT RESISTIVITY	NEUTRON	GAMMA RAY	TEMPERATURE	DENSITY
DATE OF RUN				20/5/82	20/5/82	20/5/82	20/5/82	20/5/82	20/5/82
FIRST READING (m)				94	94	94	92.4	94	57
LAST READING (m)				5	5	2	0.8	1.6	1
INTERVAL MEASURED(m)				89	89	92.5	91.6	92.4	56
CASING: LOGGER (m)									
CASING: DRILLER (m)									
DEPTH REACHED (m)				94	94	94	92.4	94	94
BOTTOM: DRILLER (m)				94	94	94	94	94	94
MUD TYPE				Geofluid + Biogel	Geofluid + Biogel	Geofluid + Biogel	Geofluid + Biogel	Geofluid + Biogel	Geofluid + Biogel
MUD RESISTIVITY									
RECORDED BY				G. CREWS	G. CREWS	G. CREWS	(CENTURY GEOPHYSICAL Co.)		

## WELL SYMBOLS

## CONSTRUCTION LOG

Casing seal

Casing shoe

Wire wound screen

Slotted casing

Cemented Interval

Gravel packed Interval

## HYDROGEOLOGICAL LOG

Core Interval

Aq Aquifer

Cb Confining bed

T Transmissivity m<sup>2</sup>/day m<sup>-1</sup>

S Storage Coefficient/Specific Yield



θ Porosity

K Hydraulic conductivity m/day

DEPTH TO WATER(m)	DEPTH TO S.W.L.(m)	YIELD	TOTAL DISSOLVED SOLIDS
		m <sup>3</sup> /day	mg/litre
46.2 m	6 m	180	10,000
		Method of Test	Analysis W No.
		Air Lifting	W/4032 / 82

REMARKS: LINATEX SEAL AT 43.5 m MAY BE INEFFECTIVE AS HOLE HAD TO BE DRILLED OVERSIZE TO ALLOW CASING ACCESS DOWN TO 63 m WHERE THERE IS A SOUTHERLY DEVIATION OF 2.3 METRES FROM VERTICAL.  
D40 - MESH SIZE PASSING 40% OF SAMPLE. D60 - MESH SIZE PASSING 60% OF SAMPLE.

## VERTICAL DEVIATION LOG

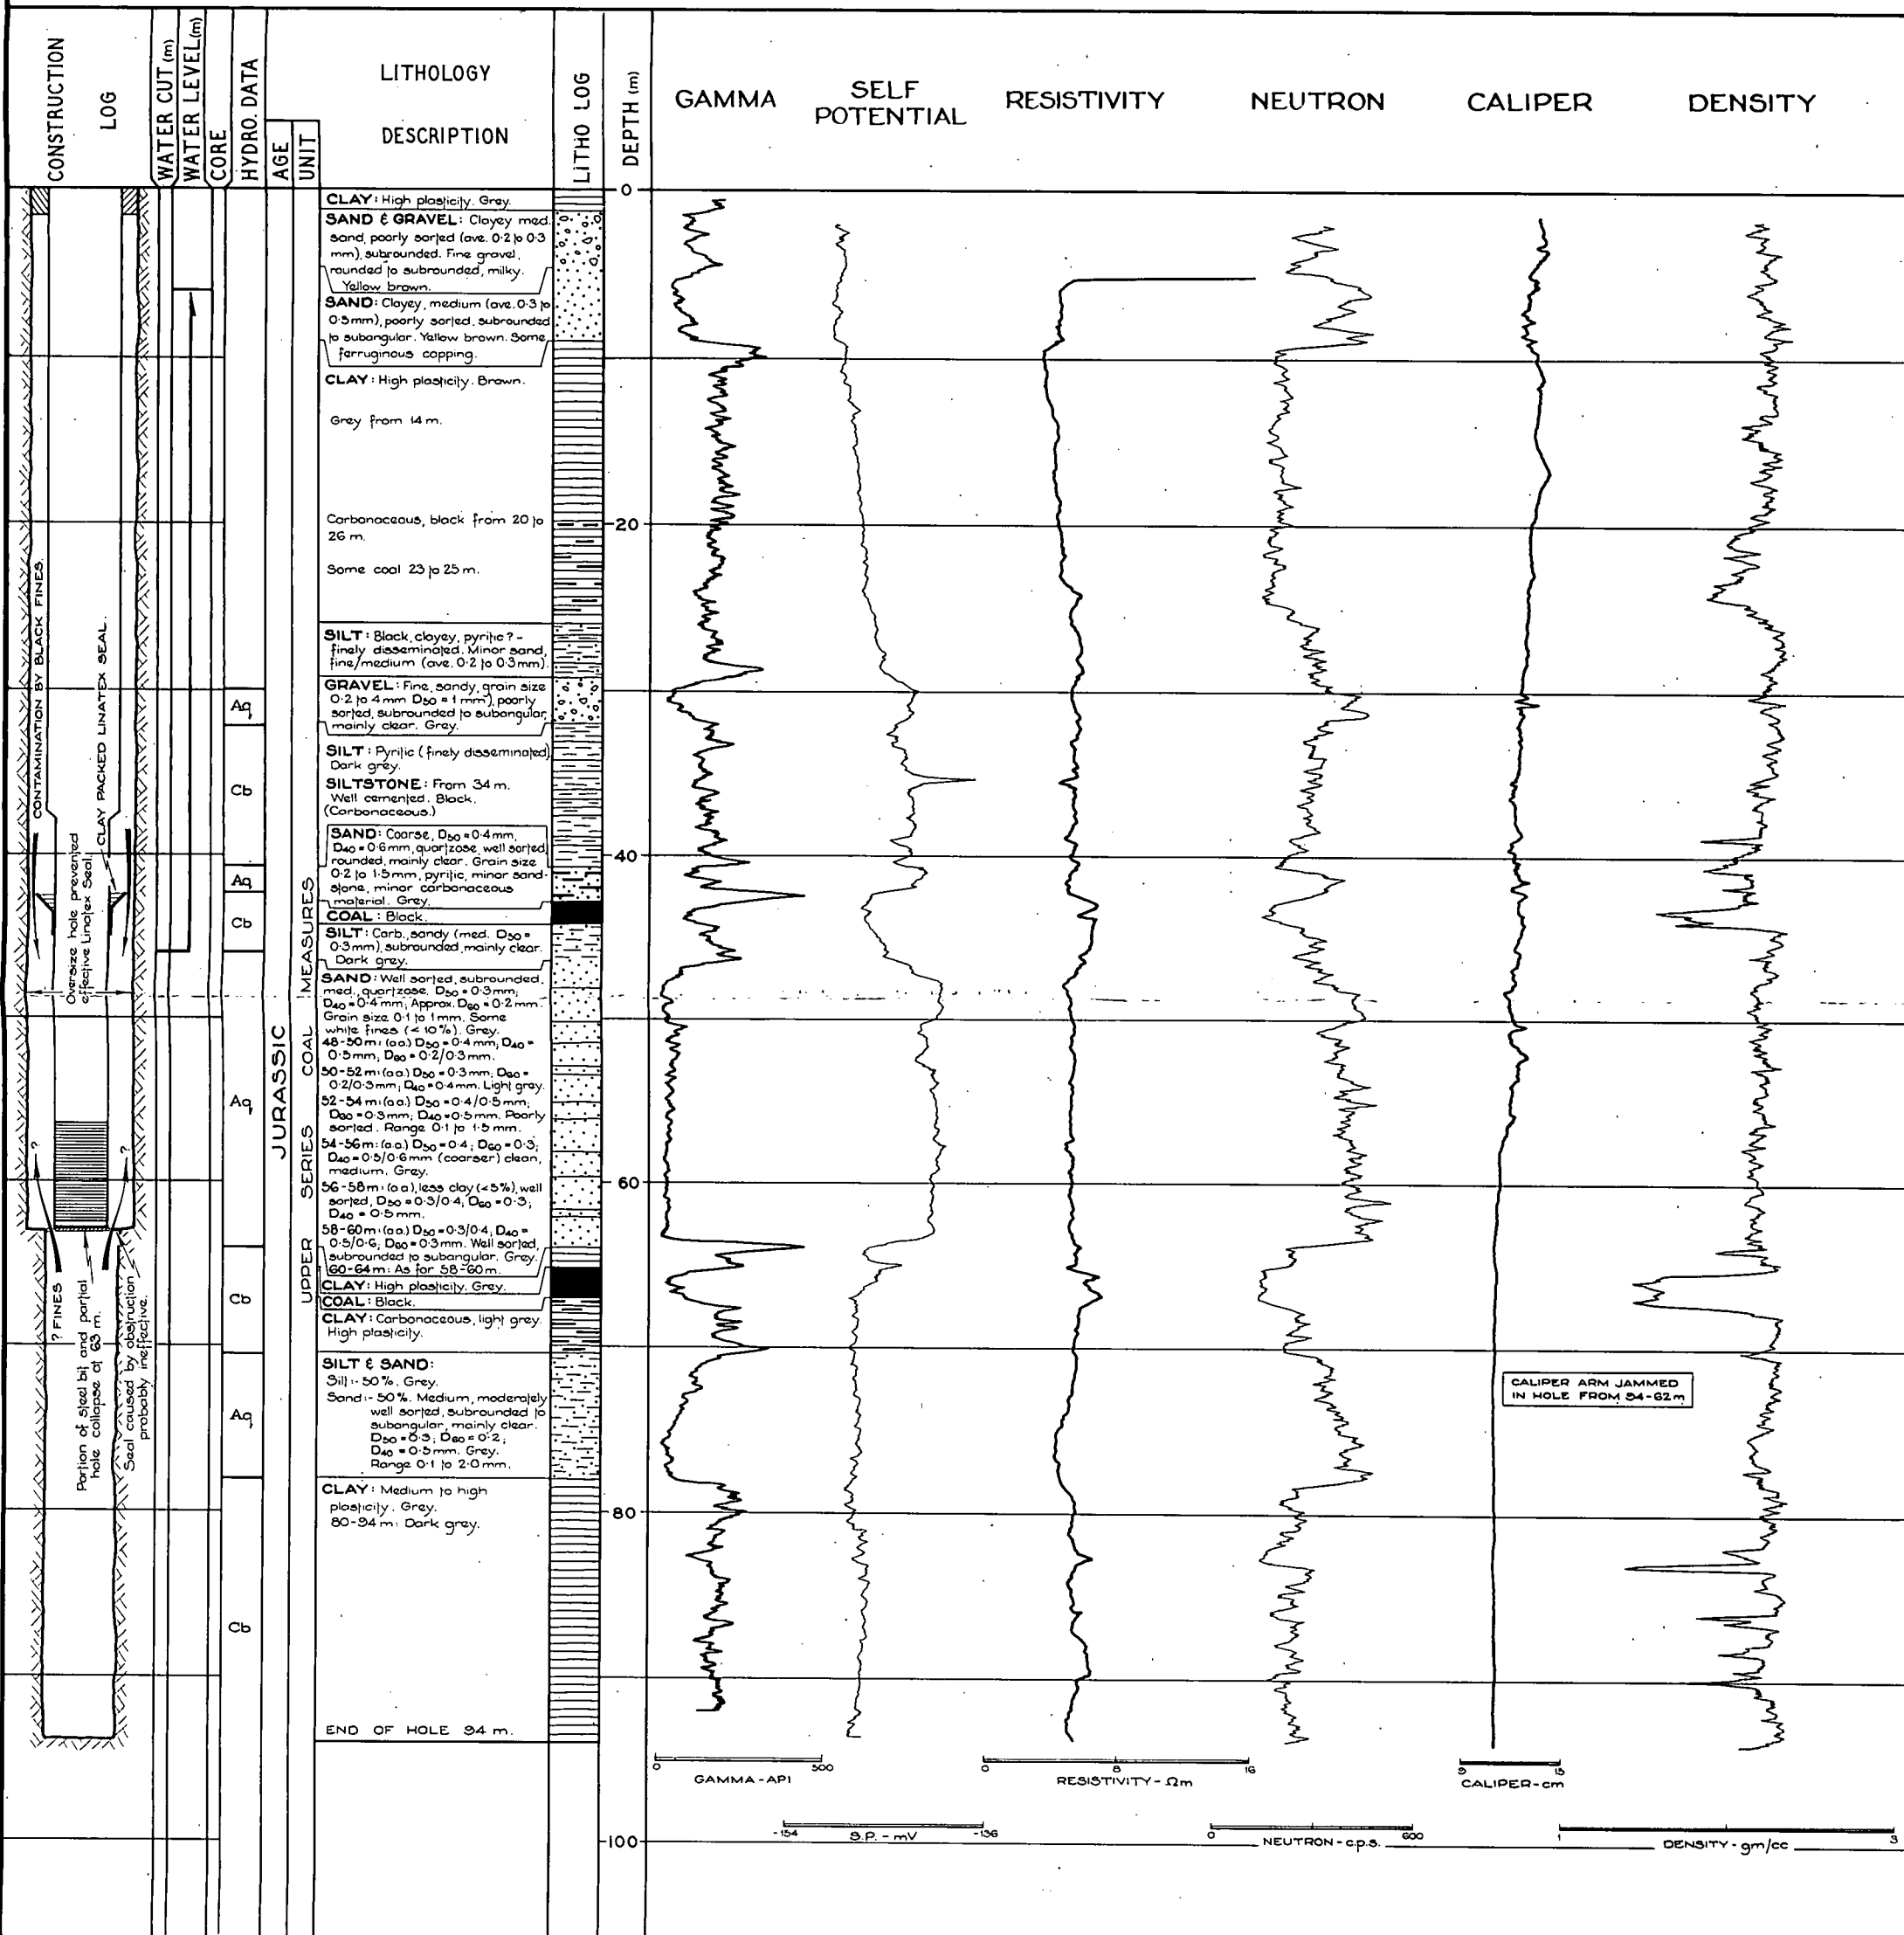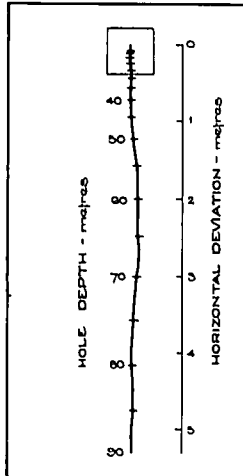

# COMPOSITE WELL LOG - GROUNDWATER

PROJECT: LOBE B UPPER SERIES DEWATERING

LOCATION: K2729.5 / 1050.4 (PRODUCTION WELL) . . . . .

SECTION: ..... HUNDRED: .....

REFERENCE ELEV. 194.54 m A.H.D. LOGGED BY: D.R. Edwards

## LOG SYMBOLS

1 CASING SEAL

 WIREWOUND SCREEN

### SLOTTED CASING

|| || GRAVEL PACKED INTERVAL

K HYDRAULIC CONDUCTIVITY  
(m/day Estimated)

E.T.S.A. WELL No. 9020 W

## CONSTRUCTION DETAILS

CONSTRUCTION DETAILS

DRILLING TECHNIQUE: ROTARY MUD

CIRCULATION: water

START: 22/9/82 FINISH: 28/9/82 TOTAL DEPTH: 108m


	mm.	FROM (m)	TO (m)
HOLE DIAMETER	350	0	3.2
	311	3.2	80
	381	1 90	98
	311	98	105.8
	128	105.8	106
CASING DIAMETER	330	0	3.2
	195	+0.27	91.5
	195	97.5	104.28
	Class 12 P.V.C.		(sump)
	SCREEN DETAILS	316 stainless steel (1mm aperture)	91.5

TYPE OF LOG	16 in. NORMAL	64 in. NORMAL	6ft. LATERAL	SELF POTENT.	POINT RESIST.	NEUTRON	GAMMA	DENSITY
DATE OF RUN						22/9/82	22/9/82	
FIRST READING						108	108	
LAST READING						0	0	
RECORDED BY						A.Young	A.Young	

DEPTH TO WATER	TOTAL DISSOLVED SOLIDS		DATE
	mg/L	Analysis No.	
7m	10,000 (approx.)		

REMARKS: SITE 1

0-75 m. Gravel packed w/ local material.  
75-105.8 m. Gravel packed w/ sand (1.2-1.7 mm diam.).  
Cement plug 0-2 m

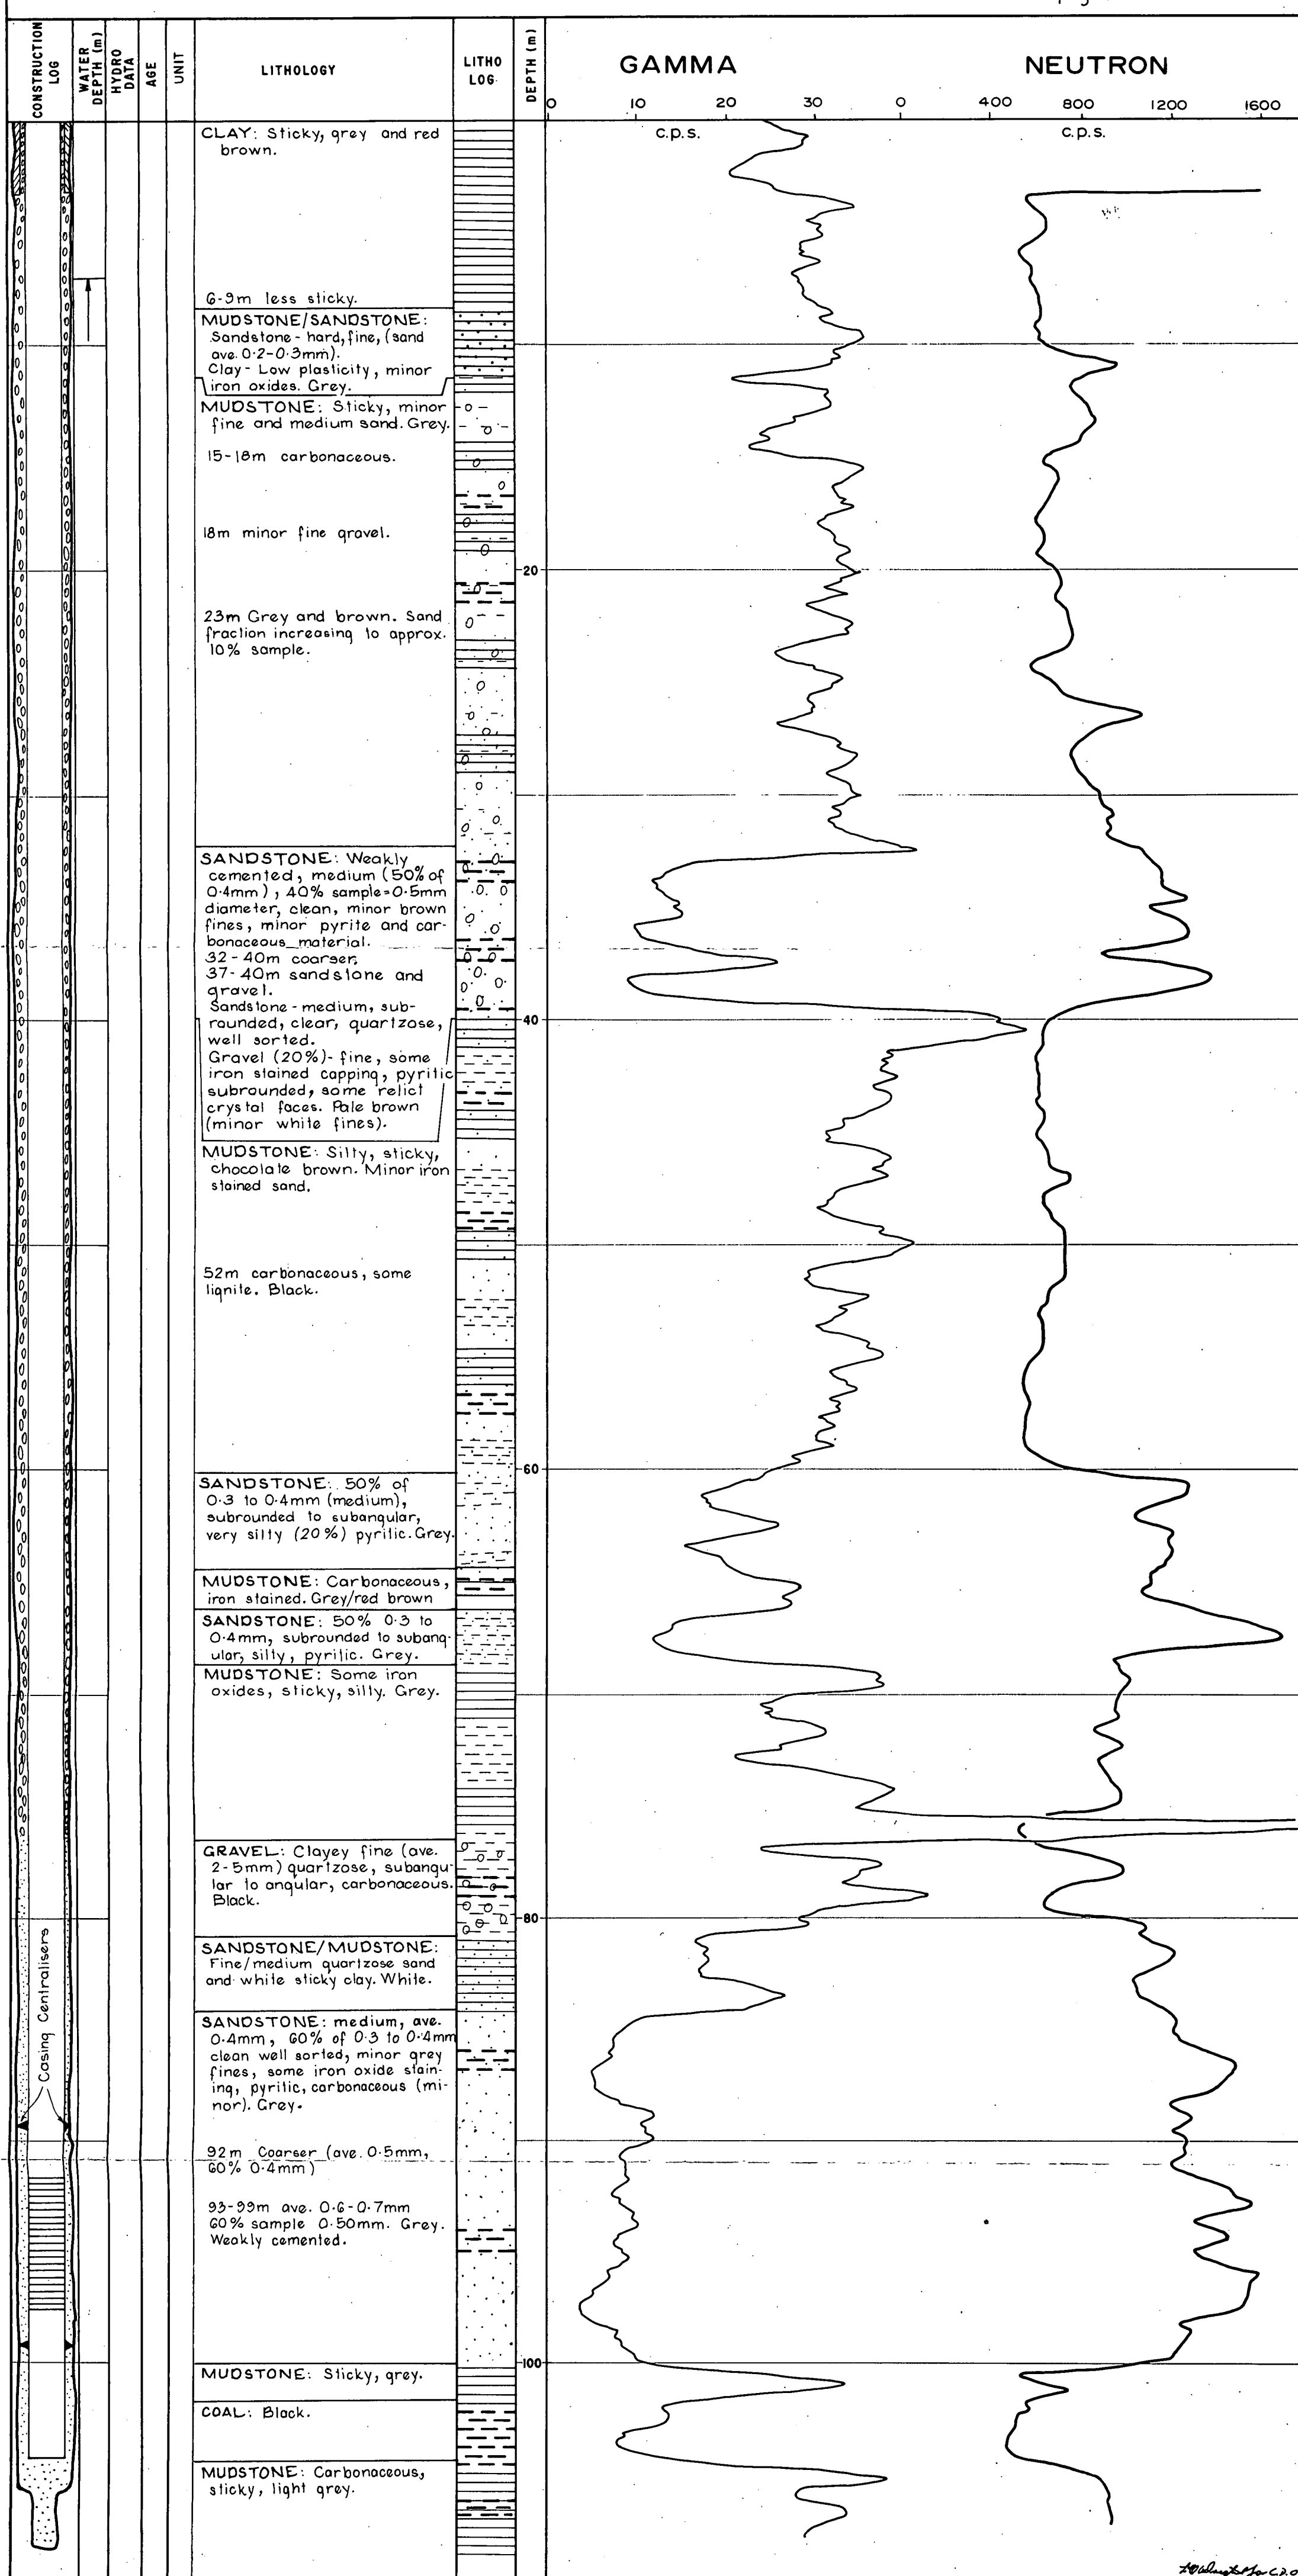

COMPOSITE WELL LOG - GROUNDWATER

PROJECT: LEIGH CREEK LOBE B UPPER SERIES DEWATERING  
LOCATION: K 2724-G1/1048-79 (5m Radius from 9020W)  
SECTION: HUNDRED  
REFERENCE ELEV. 194.48-9024P m A.H.D. LOGGED BY: D.R. EDWARDS  
194.60-9025P

LOG SYMBOLS

CASING SEAL  
WIREWOUND SCREEN  
SLOTTED CASING  
GRAVEL PACKED INTERVAL  
HYDRAULIC CONDUCTIVITY (m/day, Estimated)


E.T.S.A. WELL N° 9024P  
9025P

CONSTRUCTION DETAILS			
DRILLING TECHNIQUE: ROTARY MUD RESISTIVITY:			
CIRCULATION: MUD			
START: 23-7-83 FINISH: 23-7-83 TOTAL DEPTH: 106m			
HOLE DIAMETER	mm.	FROM (m)	TO (m)
	150	0	106
CASING DIAMETER	50 Class 12 P.V.C.	+0.2	106 (9024P)
	50 Class 12 P.V.C.	+0.35	76 (9025P)
	Linatex Seal at 96m - Cement 96-76m (9024P) (9025P) Linatex Seal at 66m - Cement 66-45m Suregel 45-0m		
SCREEN DETAILS	3mm Slots	98	100 (9024P)
	3mm Slots	68	70 (9025P)

TYPE OF LOG	16in. NORMAL	64in. NORMAL	6ft. LATERAL	SELF POTENT.	CALIPER	NEUTRON	GAMMA	DENSITY
DATE OF RUN						23-7-83		
FIRST READING					105.8	106	106	106
LAST READING					0	0	0.5	0
RECORDED BY						D.R. EDWARDS		

DEPTH TO WATER	TOTAL DISSOLVED SOLIDS		DATE
	mg/L	Analysis No.	
11-70 (r.o.c) 9024P	267.83		
10-70 (r.o.c) 9025P			

REMARKS: SITE: 1  
For Grain Size Analysis  
Interval m to m  
See plan No.

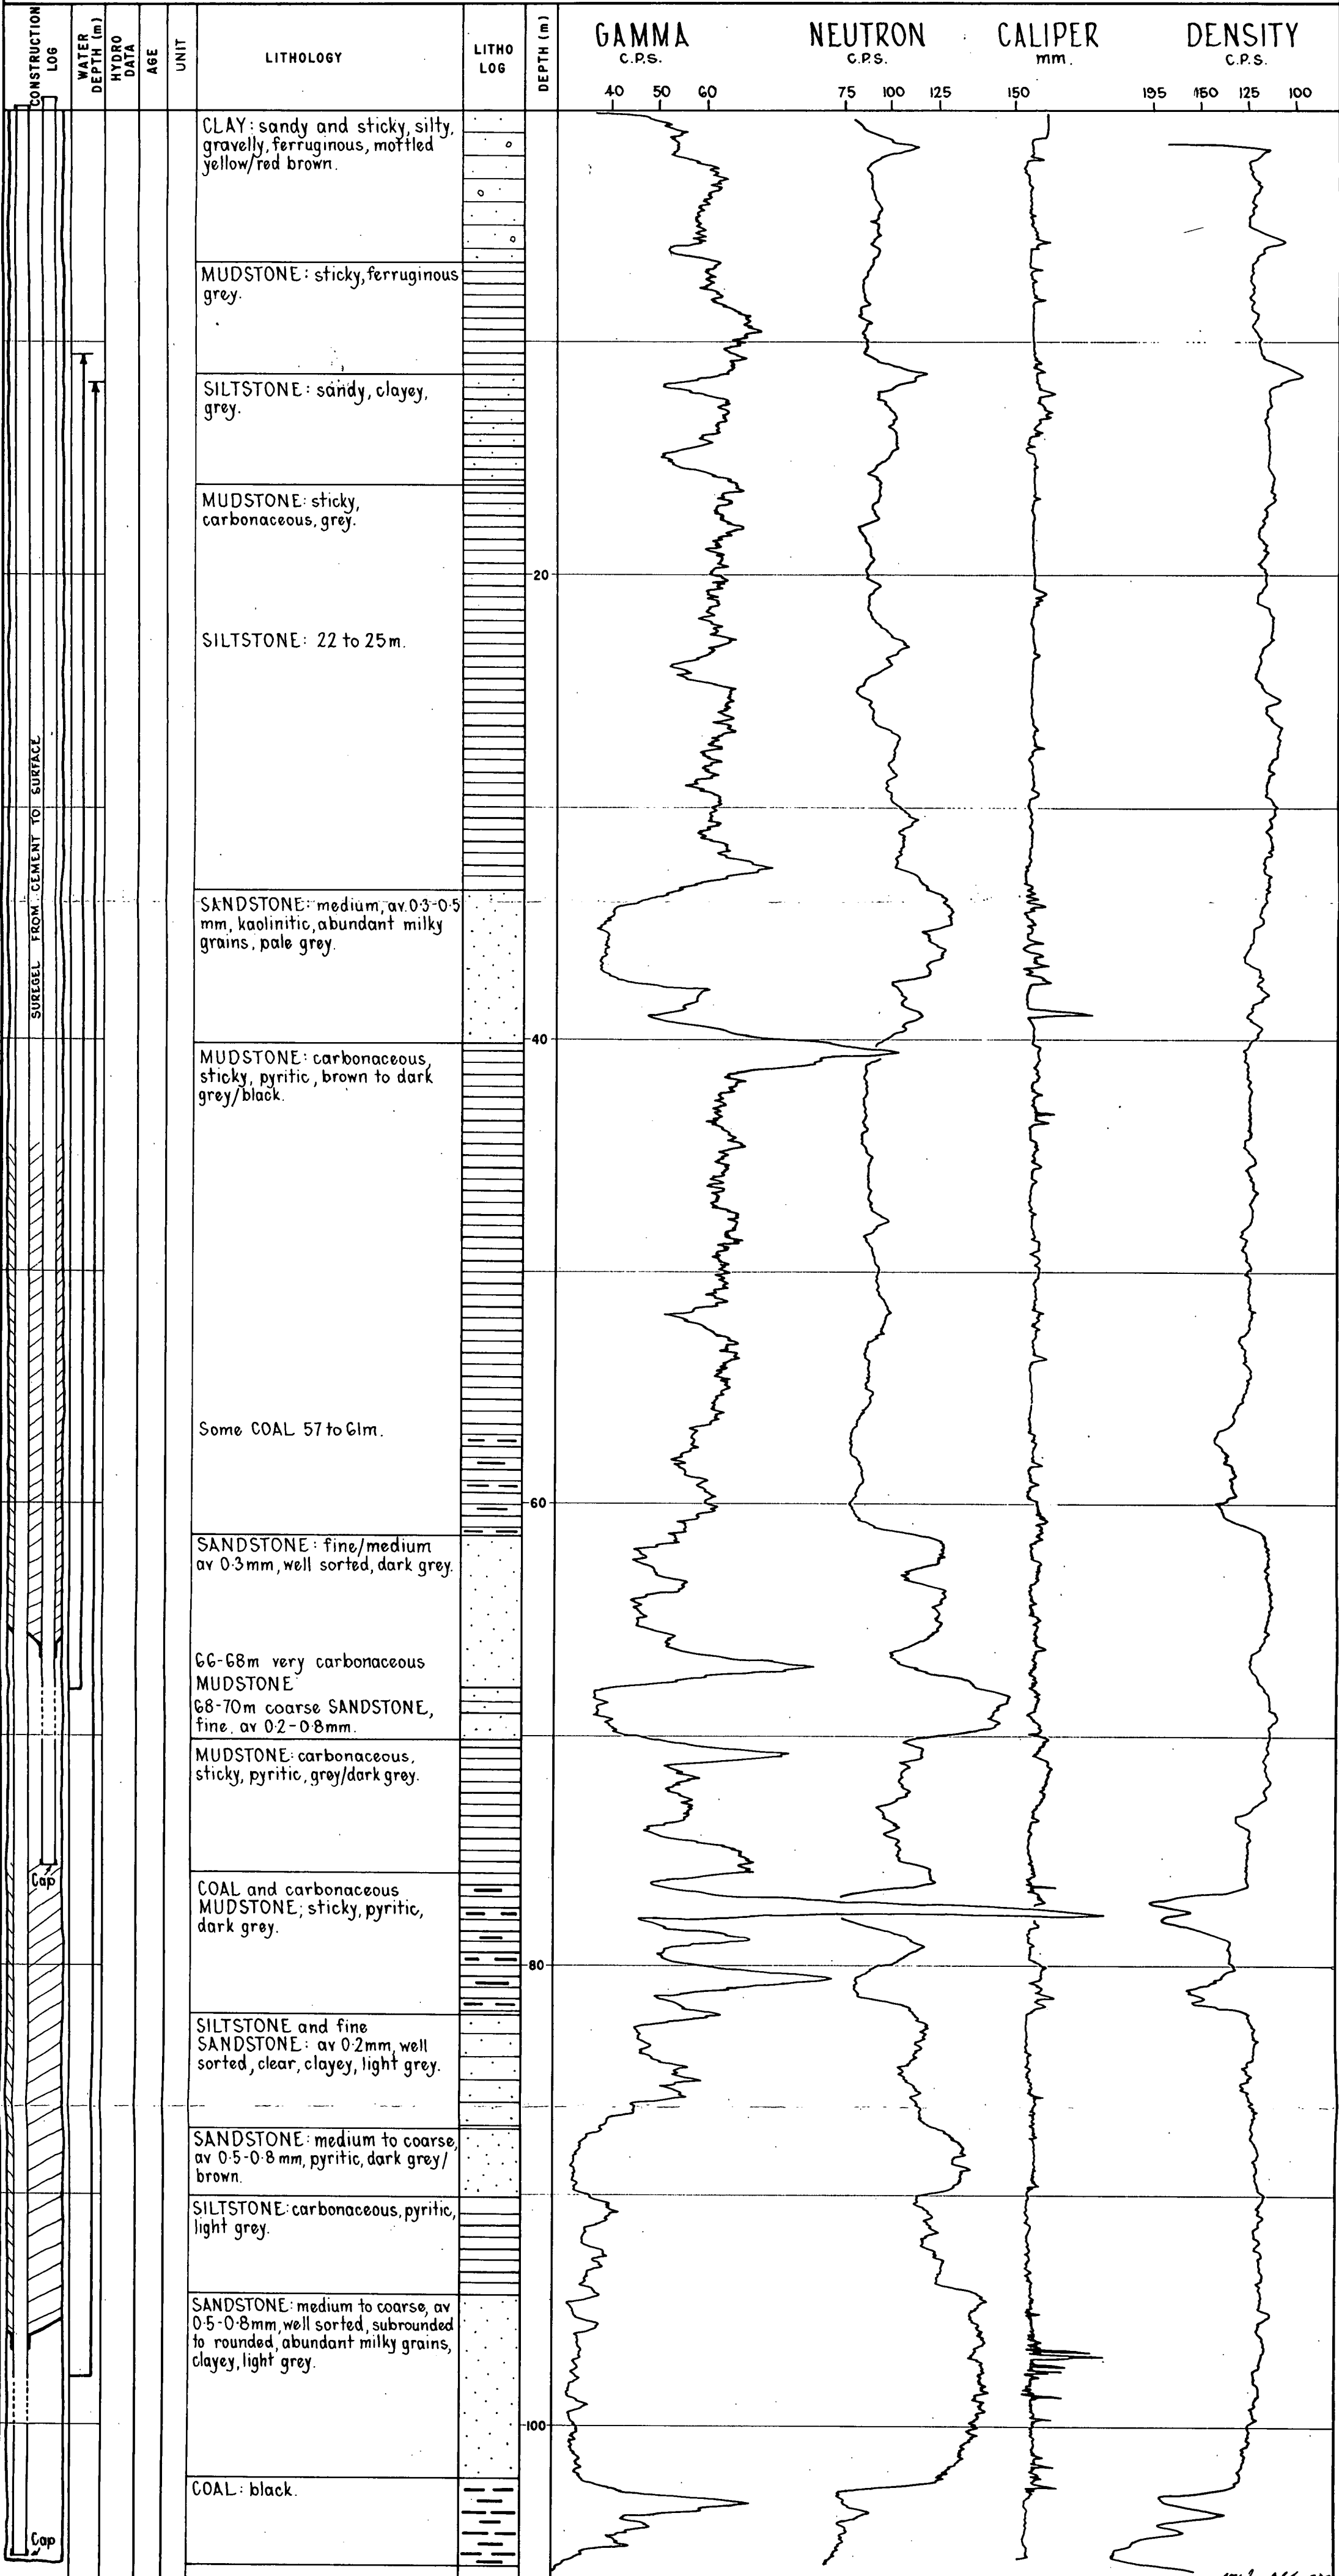

WELL UNIT No 653605a0W00300

PERMIT No. 92898

PLAN No. 83-513

ETSA WELL No. 9026 P

# COMPOSITE WELL LOG - GROUNDWATER

# LEIGH CREEK

PROJECT: LOBE B UPPER SERIES DEWATERING

LOCATION: K 2724.70/995.43 (55 m radius 9020 W)

SECTION: ..... HUNDRED: .....

REFERENCE ELEV. 194.60 m A.H.D.      LOGGED BY: D.R. Edwards

## LOG SYMBOLS

11 CASING SEAL

 WIREWOUND SCREEN

|| SLOTTED CASING

GRAVEL PACKED INTERVAL

K HYDRAULIC CONDUCTIVITY  
(m/day, Estimated)

## CONSTRUCTION DETAILS

DRILLING TECHNIQUE: ROTARY MUD  
CIRCULATION: AIR RESISTIVITY:

START: 24.7.83 FINISH: 24.7.83 TOTAL DEPTH: 30m.

HOLE DIAMETER	mm.	FROM (m)	TO (m)
	150	0	30
CASING DIAMETER	50	+ 0.32	30
	Class 12 PVC.		
SCREEN DETAILS	Slotted PVC	22	24
	3mm slots	Linatex Seal at 12m Cement 12m - Surface	

TYPE OF LOG	16 in. NORMAL	64 in. NORMAL	6 ft. LATERAL	SELF POTENT.	CALIPER	NEUTRON	GAMMA	DENSITY
DATE OF RUN					24/7/83		24/7/83	
FIRST READING					28		29	
LAST READING					1		0	
RECORDED BY					D.R.E.		D.R.E.	

DEPTH TO WATER	TOTAL DISSOLVED SOLIDS		DATE
	mg/L	Analysis No.	
G-42			
T.O.C.			
8/8/83			

REMARKS: SITE 1

CONSTRUCTION LOG	WATER DEPTH (m)	HYDRO DATA	AGE	UNIT	LITHOLOGY	LITHO LOG	DEPTH (m)	GAMMA	CALIPER
								c.p.s.	mm
					CLAY: Ferruginous, mottled gray and red-brown.				
					MUDSTONE: Sticky grey				
					SILTSTONE/SANDSTONE Fine sandstone, ave 0.1/ 0.2 mm, grey.				
					SANDSTONE: Medium ave. 0.5 mm, well sorted, clear, kaolinitic.  Some mudstone 19-21 m.  21-25 m coarse (ave. 0.6 to 0.8 mm). Grey brown.		20		
					MUDSTONE: Carbonaceous, sandy, silty. Grey brown.				



PROJECT: UPPER COAL SERIES DEWATERING LEIGH CREEK LOCATION OR COORDS: K2722.6/953.6 (100 m radius/ from 9020W) SEC.      HD.      EL Ref. Point (TOC) 194.73      m      Datum AHD								MINES DEPARTMENT — SOUTH AUSTRALIA ENGINEERING DIVISION <b>WATER WELL LOG</b>				HOLE NO: 9010W UNIT / STATE NO 6536-05aOW-254 RM PERMIT 10,530	
AQUIFER  SUMMARY:		DEPTH TO WATER CUT (m)	DEPTH TO STANDING WATER (m)	INTERVAL TESTED		SUPPLY			TOTAL DISSOLVED SOLIDS				
				From:	To:	kilolitres/day *	Test Length (hrs)	Method	milligrammes/litre	Analysis No:			
			6.4 (TOC) 25/5/82 11.69 (TOC) 25/7/83	56.5 aperture: 0.375 mm (ss. screen)	62.5	180		Air lifting	10,000 mg/l	W — 4032/82			
DEPTH (m)		GRAPHIC LOG	ROCK / SEDIMENT NAME	GEOLOGICAL DESCRIPTION			FORMATION / AGE	DEPTH COPE SAMPLE	CASING				
From	To								Dia (mm)	From (m)	To (m)		
0	4		CLAY sand & gravel	Ferruginous grey & yellow brown					100	+0.4	56.5		
4	12		Sandstone	Weakly cemented clayey, medium light brown					(class 12) Samp	62.5	63		
12	22		Mudstone*	Carbonaceous, high plasticity brown									
22	26		Coal	Black									
26	30		SILTSTONE	Sandy, clayey pyritic black									
30	32		GRAVEL	Fine, grey.									
32	42		SILTSTONE/ *SANDSTONE	Pyritic, carbonaceous grey/black (weakly cemented)									
42	46		Mudstone/Siltstone	Carbonaceous, sandy dark grey.									
46	63		SANDSTONE	Medium, pyritic, grey.									
63	74		Mudstone/Coal	Dark grey									
74	76		Siltstone/Sandstone	Medium, (weakly cemented) grey.									
76	94		Mudstone	Dark grey.									
REMARKS: SITE 1 (U24) (Previous No. HOB 1)      * NOTE: 110 l / day = 1000 gals / hr. (* Previously denoted as clay of sand)  (Now an observation well only)				DRILL TYPE: ROTARY			COMPLETED: 22/5/82						
				CIRCULATION: MUD			LOGGED BY: D. EDWARDS						
				SHEET 1 OF 1			DATE: 20/5/82						

PROJECT: UPPER COAL SERIES DEWATERING LEIGH CREEK

MINES DEPARTMENT — SOUTH AUSTRALIA  
ENGINEERING DIVISION

HOLE NO: 9020W

LOCATION OR COORDS: K 2729.5/1050.4 (Production Well)

## WATER WELL LOG

UNIT / STATE NO  
6536-05aOW-426SEC. MD. EL Surface 194.54 m  
EL Ref. Point (TOC) m Datum AHD

DM PERMIT 92196

AQUIFER  SUMMARY:	DEPTH TO WATER CUT (m)	DEPTH TO STANDING WATER (m)	INTERVAL TESTED		SUPPLY			TOTAL DISSOLVED SOLIDS
			From:	To:	kilolitres/day *	Test Length (hrs)	Method	milligrammes/litre
		6.76m(TOC) 21/1/83 11.04m (TOC) 8/8/83	91.5	97.5	765 aperture (approx.) 1 mm (ss. screen)	5 hours	Air lifting	10,700
								Analysis No: W — 4893/82

DEPTH (m)		GRAPHIC LOG	ROCK / SEDIMENT NAME	GEOLOGICAL DESCRIPTION	FORMATION / AGE	DEPTH COPE SAMPLE	CASING		
From	To						dia (mm)	From (m)	To (m)
0	7		CLAY	Sticky grey and red brown			200	+0.27	91.5
7	32		MUDSTONE	Sandy, carbonaceous, grey/brown			(class	97.5	104
32	40		SANDSTONE	Weakly cemented, pyritic, carbonaceous gravelly 37-40 m. Grey/pale brown (medium).			12 pvc).	(capped sump)	
40	60		MUDSTONE	Sticky, carbonaceous Grey Black.					
60	69		SANDSTONE & MUD- STONE	Medium sandstone av. 0.4 mm, carbonaceous sticky, pyritic, grey weakly cemented.					
69	76		/MUDSTONE	sticky, grey.					
76	81		GRAVEL/MUDSTONE	fine, carbonaceous, black.					
81	84		SANDST/MUDSTONE	fine, kaolinitic, white.					
84	100		SANDSTONE	Medium, weakly cemented pyritic, carbonaceous grey.					
100	102		MUDSTONE	Sticky grey.					
102	105		COAL	Black					
105	108		MUDSTONE	Carbonaceous, sticky, light grey.					

REMARKS: SITE 1 (U24)  
(Previous No. HOB 2)

\* NOTE: 110 l / day = 1000 gals / hr.

DRILL TYPE: ROTARYCOMPLETED: 28/9/82CIRCULATION: MUDLOGGED BY: D. EDWARDSSHEET 1 OF 1DATE: 22/9/82

PROJECT: UPPER COAL SERIES DEWATERING LOBE B		MINES DEPARTMENT — SOUTH AUSTRALIA ENGINEERING DIVISION					HOLE NO: 9021 P				
LOCATION OR COORDS: K 2726.1/997.0 (55m radius from 9020W)		WATER WELL LOG					UNIT / STATE NO 6536-5aOW-331				
SEC.	HD.	EL Surface EL Ref. Point 195.33 m		m Datum AHD		DM					
AQUIFER  SUMMARY:		DEPTH TO WATER CUT (m)	DEPTH TO STANDING WATER (m)	INTERVAL TESTED		SUPPLY		TOTAL DISSOLVED SOLIDS			
				From:	To:	kilolitres/day*	Test Length (hrs)	Method	milligrammes/litre	Analysis No:	
		16 m		16	18	(NOW ABANDONED).				W —	
DEPTH (m)		GRAPHIC LOG	ROCK / SEDIMENT NAME	GEOLOGICAL DESCRIPTION		FORMATION / AGE		DEPTH COPE SAMPLE	CASING		
From	To								Dia (mm)	From (m)	To (m)
0	6		CLAY	Ferruginous, sticky red brown.							
6	8		MUDSTONE	Sticky grey							
8	12		SILTSTONE/SANDSTONE	Grey (fine sandstone)							
12	16		MUDSTONE	Sticky, silty dark grey							
16	18		SANDSTONE	Medium (av. 0.5 mm) well sorted Kaolinitic pale grey.							
REMARKS: SITE 1 (U. 24)      * NOTE: 110 kl / day = 1000gals / hr. Previous No. "P1" (Adjacent to replacement piezo 9026 P). (ETSA piezo) (*Lithological correlated from adjacent 9026 P).						DRILL TYPE: Hammer		COMPLETED:			
						CIRCULATION: Air (ETSA Drilled)		LOGGED BY: NOT LOGGED*			
						SHEET..... 1 ... OF.... 1 .....		DATE:			



PROJECT: UPPER COAL SERIES DEWATERING LEIGH CREEK

MINES DEPARTMENT — SOUTH AUSTRALIA  
ENGINEERING DIVISION

HOLE NO: 9022P

LOCATION OR COORDS: K 2726.0/879.5 (170 m radius from

## WATER WELL LOG

UNIT / STATE NO  
6536-5aOW-332

SEC.

HD.

EL Surface 9020 W) . m

EL Ref. Point 195.69 (TOC) m Datum AHD

DM

AQUIFER  SUMMARY:	DEPTH TO WATER CUT (m)	DEPTH TO STANDING WATER (m)	INTERVAL TESTED		SUPPLY			TOTAL DISSOLVED SOLIDS
			From:	To:	kilolitres/day *	Test Length (hrs)	Method	milligrammes/litre Analysis No:
		12.30 m (TOC) 15/8/83						W —

DEPTH (m)		GRAPHIC LOG	ROCK / SEDIMENT NAME	GEOLOGICAL DESCRIPTION	FORMATION / AGE	DEPTH CORE SAMPLE	CASING		
From	To						Jia (mm)	From (m)	To (m)
				* Hole bottomed in same sandstone sequence as 9010/9020 W completions.					

REMARKS: SITE 1 (U 24)

\* NOTE: 110 kl / day = 1000gals / hr.

Previous No. "P2 ETSA piezo

DRILL TYPE: HAMMER

COMPLETED:

CIRCULATION: AIR (ETSA  
DRILLED)

LOGGED BY: \*NOT LOGGED

SHEET . . . . 1 . . . OF . . . 1 . . . . .

DATE:

PROJECT: UPPER COAL SERIES DEWATERING LOBE B LEIGH CREEK LOCATION OR COORDS: K2725.5/870.0 (180 m radius from 9020W) SEC.      HD.      EL Surface      EL Ref. Point 196.03 (TOC)      m      Datum AHD										MINES DEPARTMENT — SOUTH AUSTRALIA ENGINEERING DIVISION <b>WATER WELL LOG</b>										HOLE NO: 9023P UNIT / STATE NO 6536-5aOW-333 DM			
AQUIFER  SUMMARY:				DEPTH TO WATER CUT (m)		DEPTH TO STANDING WATER (m)		INTERVAL TESTED		SUPPLY			TOTAL DISSOLVED SOLIDS										
								From:      To:		kilolitres/day *		Test Length (hrs)		Method		milligrammes/litre		Analysis No:					
						12.70 m (TOC) 15/8/83												W —					
DEPTH (m)		GRAPHIC LOG	ROCK / SEDIMENT NAME		GEOLOGICAL DESCRIPTION						FORMATION / AGE		DEPTH CORE SAMPLE	CASING									
From	To													dia (mm)	From (m)	To (m)							
					* Hole bottomed in same sandstone sequence as 9010/9020 W completions.																		
REMARKS: SITE 1 (U-24) (Previous No. P3)										* NOTE: 110 kl / day = 1000gph / hr.										DRILL TYPE: Hammer		COMPLETED:	
																				CIRCULATION: AIR (ETSA DRILLED)		LOGGED BY: *NOT LOGGED	
																				SHEET . . . . 1 . . . OF . . . . 1 . . . .		DATE:	

PROJECT: UPPER COAL SERIES DEWATERING LOBE B LEIGH CREEK MINES DEPARTMENT — SOUTH AUSTRALIA  
ENGINEERING DIVISION

LOCATION OR COORDS: K 2724.6/1048.79 (5 m radius from 9020W)

EL Ref Point 194.48 (9024P)

EL Ref. Point 194.60 (9025P) m Datum AHD

SEC.

MD.

## WATER WELL LOG

HOLE NO: 9024 P  
9025 P

UNIT / STATE NO.  
6536-5002-319  
6536-5002-320  
BM PERMIT 92899

AQUIFER  SUMMARY:	DEPTH TO WATER CUT (m)	DEPTH TO STANDING WATER (m)	INTERVAL TESTED		SUPPLY			TOTAL DISSOLVED SOLIDS
			From:	To:	kilolitres/day *	Test Length (hrs)	Method	milligrammes/litre
								Analysis No:
		11.70 (TOC 9024P (26/7/83) 10.70 (TOC 9025 P	98 9024P 68 9025P	100 9024P 70 9025P	3mm/ slots pvc		AIR LIFTED	

DEPTH (m)		GRAPHIC LOG	ROCK / SEDIMENT NAME	GEOLOGICAL DESCRIPTION	FORMATION / AGE	DEPTH COPE SAMPLE	CASING		
From	To						dia (mm)	From (m)	To (m)
0	8		CLAY	Gravelly, sandy, ferruginous sticky mottled yellow & red brown		9024 P completion	50	+0.2	106
8	33		MUDSTONE & SILTSTONE	Sticky, carbonaceous, grey			12	98	100
33	40		SANDSTONE	Medium av. 0.3/0.5 mm, Kaolinitic light grey			pvc	seal at	
40	61		MUDSTONE	Carbonaceous, pyritic, sticky dark grey/black				96 m	
61	70		SANDSTONE	Fine/coarse (av. 0.3 to 0.8/2 mm) well sorted, dark grey.				cement	
70	76		MUDSTONE	Sticky, carbonaceous grey.		9025 P completion	50	+0.35	76
76	82		COAL/MUDSTONE	Black & dark grey.			12	68	70
82	87		SILTSTONE/ SANDSTONE	Carbonaceous, pyritic, light grey.			pvc	seal at	
87	90		SANDSTONE	Medium to coarse av. 0.5/0.8 pyritic dark grey/grown.				66 m	
90	94		SILTSTONE	Carbonaceous, pyritic, light grey.				cement	
94	102		SANDSTONE	Medium to coarse av. 0.5/0.8 mm well sorted clayey light grey.		9025 P completion		66	45
102	106		COAL	Black.				suregel	
							45	0	
							sump	70	76m

REMARKS: SITE 1 (U-24)  
(DUAL COMPLETION)

\* NOTE: 110 kl / day = 1000gals / hr.

DRILL TYPE: ROTARY

COMPLETED: 23/7/83

CIRCULATION: MUD

LOGGED BY: D.R. EDWARDS

SHEET 1 OF 1

DATE: 23/7/83

PROJECT: Upper Coal Series Dewatering Lobe B Leigh Creek MINES DEPARTMENT — SOUTH AUSTRALIA  
ENGINEERING DIVISION

LOCATION OR COORDS: K 2724.70/995.43 m (55.1 m radius from

EL Surface 194.32 (0) m 9020 W)

EL Ref. Point 194.60 (TOC) m Datum AHD

SEC.

HD.

## WATER WELL LOG

HOLE NO: 9026 P

UNIT / STATE NO

6536-5a W-300

DM PERMIT 92898

AQUIFER  SUMMARY:	DEPTH TO WATER CUT (m)	DEPTH TO STANDING WATER (m)	INTERVAL TESTED		SUPPLY			TOTAL DISSOLVED SOLIDS
			From:	To:	kilolitres/day *	Test Length (hrs)	Method	milligrammes/litre
		6.42 (TOC) 8-8-83	22	24 (3 mm slots).				

Analysis No:

W —

DEPTH (m)		GRAPHIC LOG	ROCK / SEDIMENT NAME	GEOLOGICAL DESCRIPTION	FORMATION / AGE	DEPTH COPE SAMPLE	CASING		
From	To						dia (mm)	From (m)	To (m)
0	6		CLAY	ferruginous mottled grey & red brown		3	50	+0.32	30
6	15		MUDSTONE & SILT- STONE			12	class		
15	25		SANDSTONE	medium to coarse av 0.5/0.8 mm, well sorted, clear, grey brown.			PVC (slots		
15	25			carbonaceous, sandy, silty, grey Brown.			22-24).		
25	30		MUDSTONE				LINATEX SEAL AT		
							12 m (cement		
							12-0).		

REMARKS: SITE 1 (U24)

\* NOTE: 110 kl / day = 1000 gals / hr.

DRILL TYPE: rotary

COMPLETED: 24/7/83

CIRCULATION: AIR

LOGGED BY: D. EDWARDS

SHEET 1 OF 1

DATE: 24/7/83

APPENDIX 2

Plan No.

U/25 Site: Well Location

S17452

Composite log

9030W

83-506

9040W

83-505

9041P

83-507

9042P

83-508

9043/4P

83-509

Summary Cuttings Logs



9040W

9041P


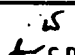
9042P

9043/4P

For all SADME Well Unit Nos see appendix 6

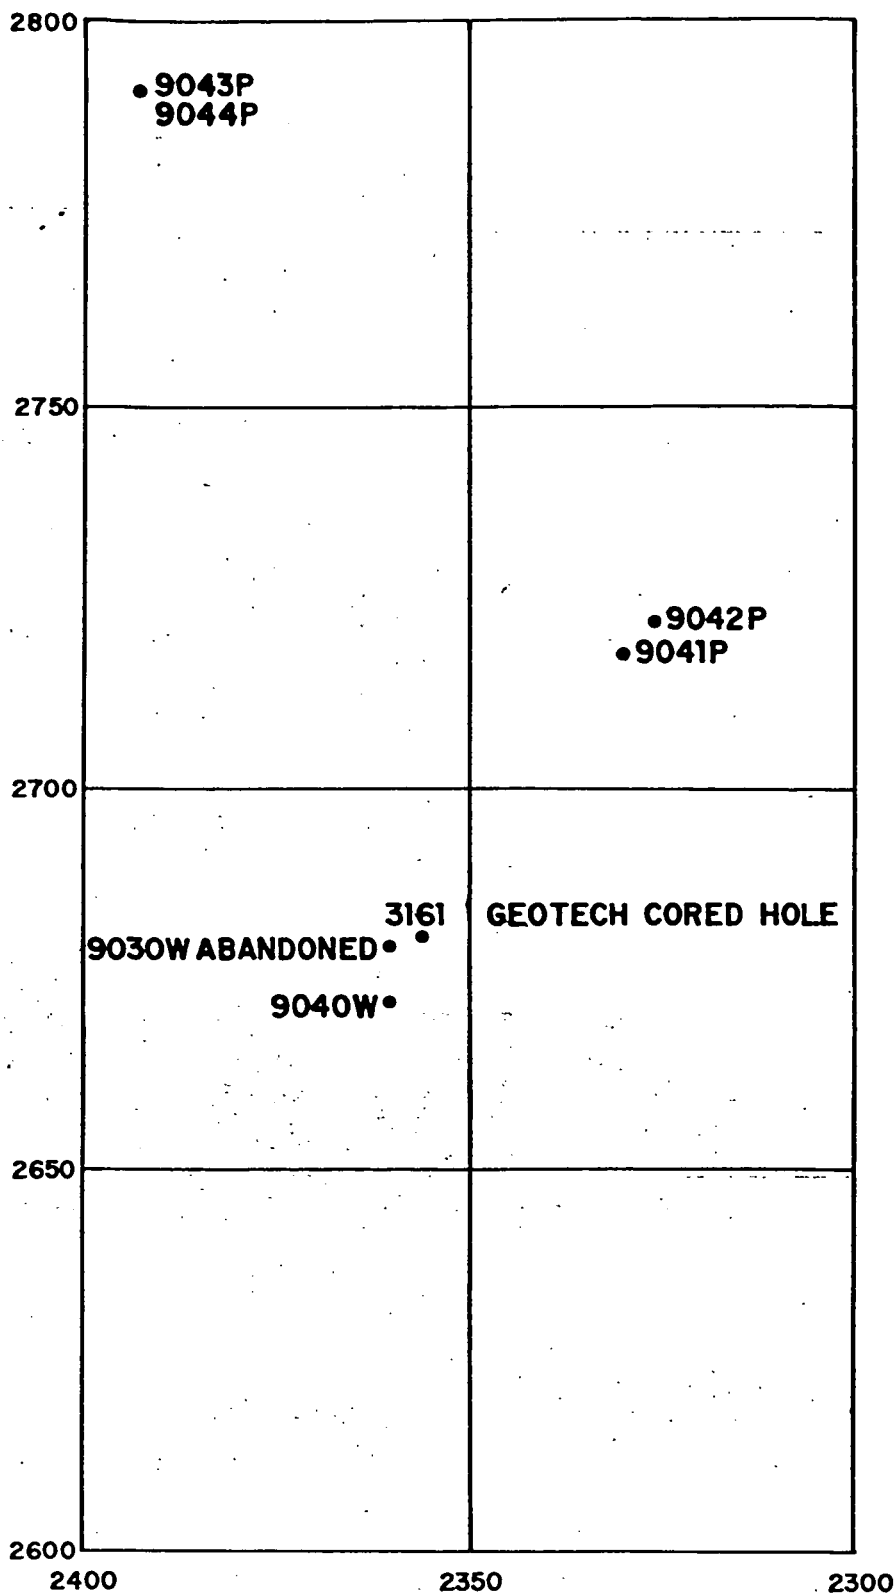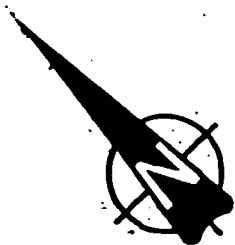

## APPENDIX 2

 <b>DEPARTMENT OF MINES AND ENERGY</b> <b>SOUTH AUSTRALIA</b>	COMPILED D.E.B.D.A.	 <i>24/7/85</i> <b>C.D.O.</b> DATE
	DRAWN G.B.	SCALE 1:1000
	DATE 19 JUL 84	PLAN NUMBER <b>S17452</b>
	CHECKED	

LEIGH CREEK COALFIELD LOBE B GROUNDWATER INVESTIGATION  
 U/25 SITE WELL LOCATIONS  
 E.T.S.A. 'K' GRID

COMPOSITE WELL LOG - GROUNDWATER

PROJECT: LEIGH CREEK LOBE B- UPPER SERIES DEWATERING

LOG SYMBOLS

LOCATION: 5 metres SW. of Cored Hole 3161

CASING SEAL

GRAVEL PACKED INTERVAL

SECTION: HUNDRED:

WIREWOUND SCREEN

HYDRAULIC CONDUCTIVITY  
(m/day, Estimated)

REFERENCE ELEV. m A.H.D. LOGGED BY: D.R.EDWARDS

SLOTTED CASING

CONSTRUCTION DETAILS  
DRILLING TECHNIQUE: ROTARY MUD  
CIRCULATION: MUD RESISTIVITY:  
START: 23-5-83 FINISH: 31-5-83 TOTAL DEPTH: 162m

HOLE DIAMETER	mm.	FROM (m)	TO (m)
	300 140	0 149	149 162


CASING DIAMETER	203 chemline 125 telescopic (chemline)	80-1 147 158	149 153 161 (capped)
--------------------	--	--------------------	----------------------------

SCREEN DETAILS	200 Rubber 115	0.4mm aperture-135 to 140m packer set at 147m 0.4mm aperture-153 to 158m (telescopic)
-------------------	----------------------	---

TYPE OF LOG	16in. NORMAL	64in. NORMAL	6ft. LATERAL	SELF POTENT.	POINT RESIST.	NEUTRON	GAMMA	DENSITY
DATE OF RUN							24-5-83	
FIRST READING							161	
LAST READING							0	
RECORDED BY							D.R. Edwards	

DEPTH TO WATER	TOTAL DISSOLVED SOLIDS		DATE
	mg/L	Analysis No.	
8m			
31-5-83	Hole collapsed and abandoned.		

REMARKS: SITE 2

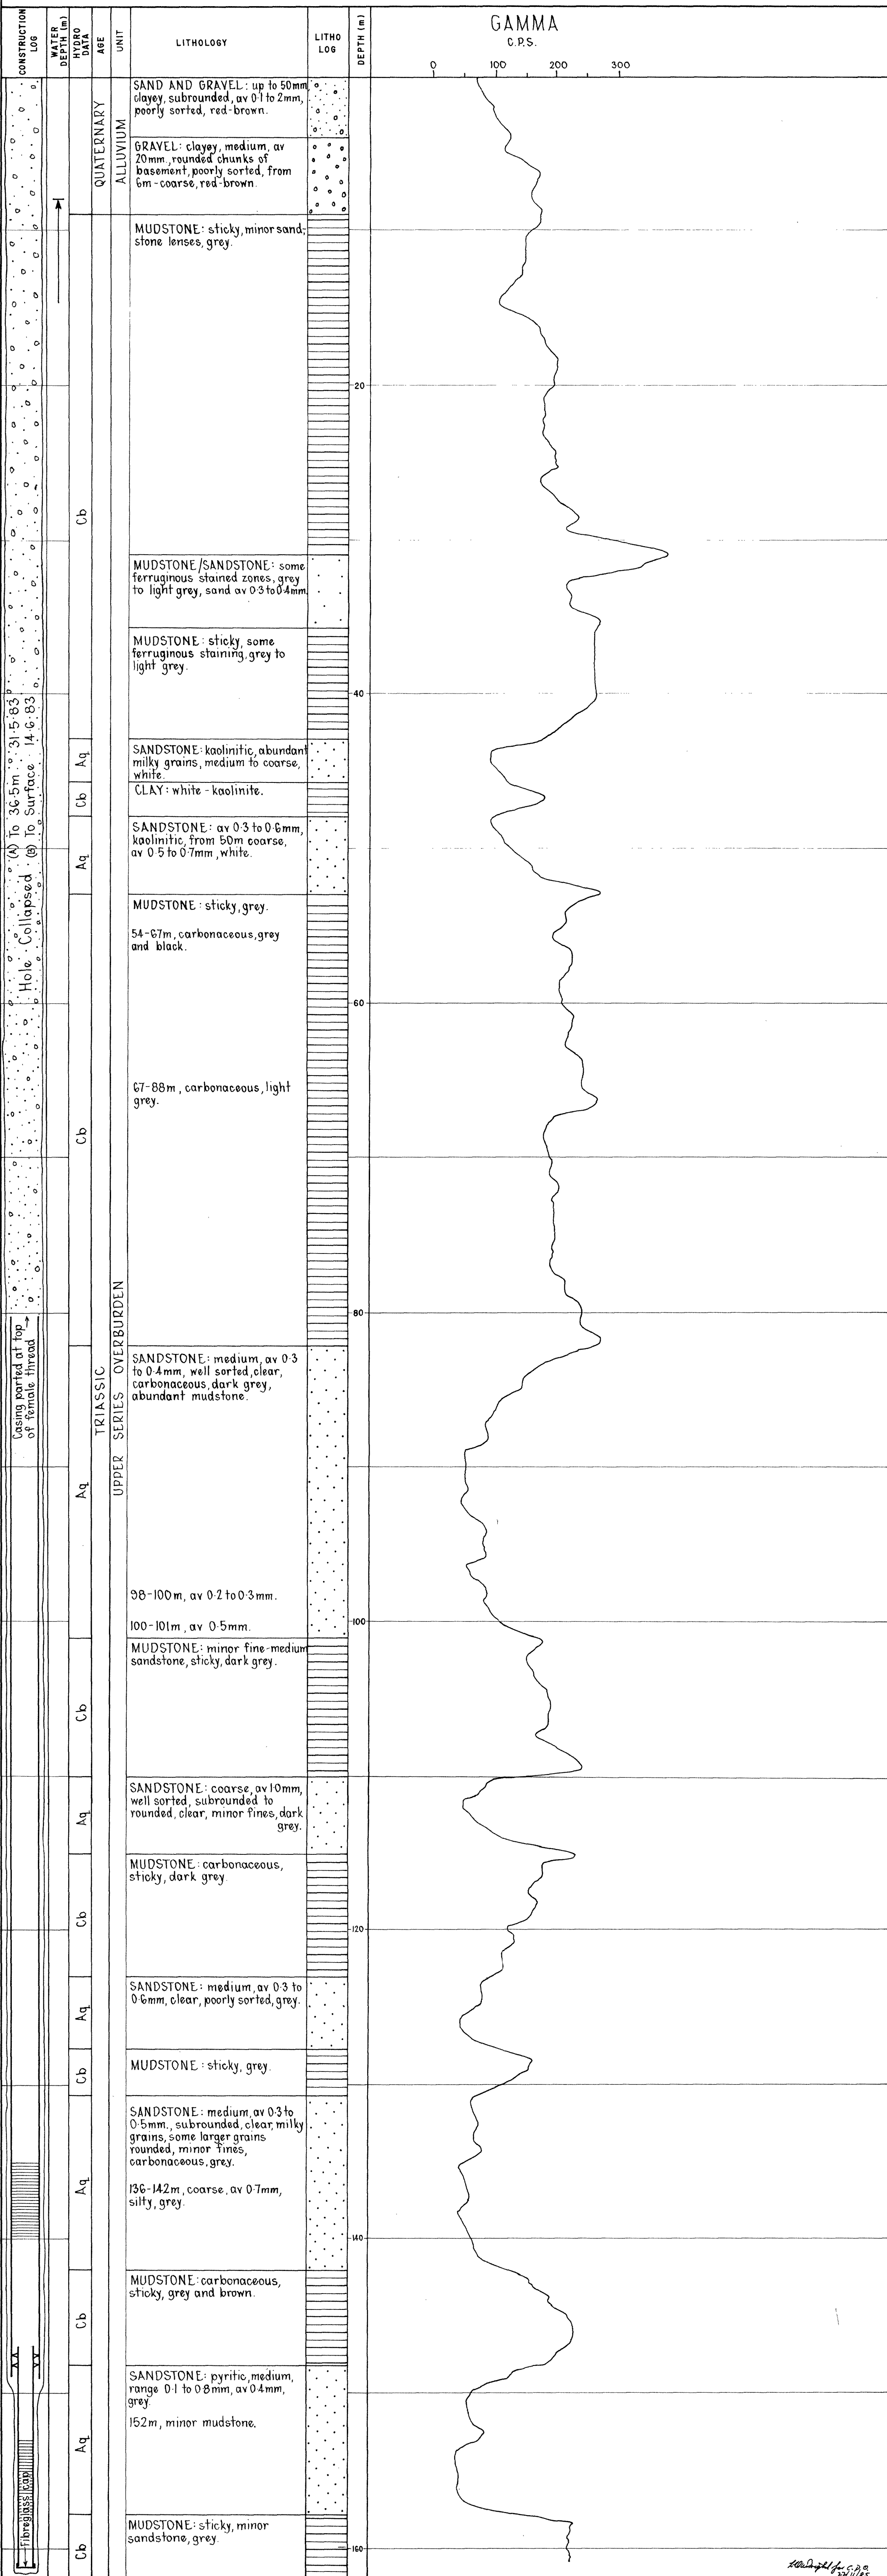





COMPOSITE WELL LOG - GROUNDWATER

WELL C53746r0W00578  
UNIT No.  
PERMIT No. 92791  
PLAN No. 83-507  
E.T.S.A. WELL No. 9041P

PROJECT: LEIGH CREEK LOBE B UPPER SERIES DEWATERING  
LOCATION: K2718-60/2330-52 (55m Radius from 9040W)  
SECTION: HUNDRED:  
REFERENCE ELEV. 95.65 (100m) A.H.D. LOGGED BY: D.R. EDWARDS

LOG SYMBOLS


CASING SEAL  
GRAVEL PACKED INTERVAL  
WIREWOUND SCREEN  
HYDRAULIC CONDUCTIVITY (m/day, Estimated)  
SLOTTED CASING

CONSTRUCTION DETAILS			
DRILLING TECHNIQUE: ROTARY MUD RESISTIVITY:			
CIRCULATION: MUD (HYDROPOL)			
START: 31-5-83. FINISH: 1-6-83. TOTAL DEPTH: 150m.			
HOLE DIAMETER	mm.	FROM (m)	TO (m)
	150	0	150
CASING DIAMETER	50 class 18 P.V.C.	+0.25m	149
	Linatex seal at 137m. Cement from 137m to 117m.		
SCREEN DETAILS	3mm slots	139	141
	(Gauze covered)		

TYPE OF LOG	16 in. NORMAL	64 in. NORMAL	6 ft. LATERAL	SELF POTENT.	POINT RESIST.	NEUTRON	GAMMA	DENSITY
DATE OF RUN						7-7-83	1-6-83	
FIRST READING						134.5	149	
LAST READING						1-3	0	
RECORDED BY						D.R. Edwards		

DEPTH TO WATER (T.O.C.) 21-7-83	TOTAL DISSOLVED SOLIDS		DATE
	mg/L	Analysis No.	
	15000		

REMARKS:  
SITE 2 (U25)

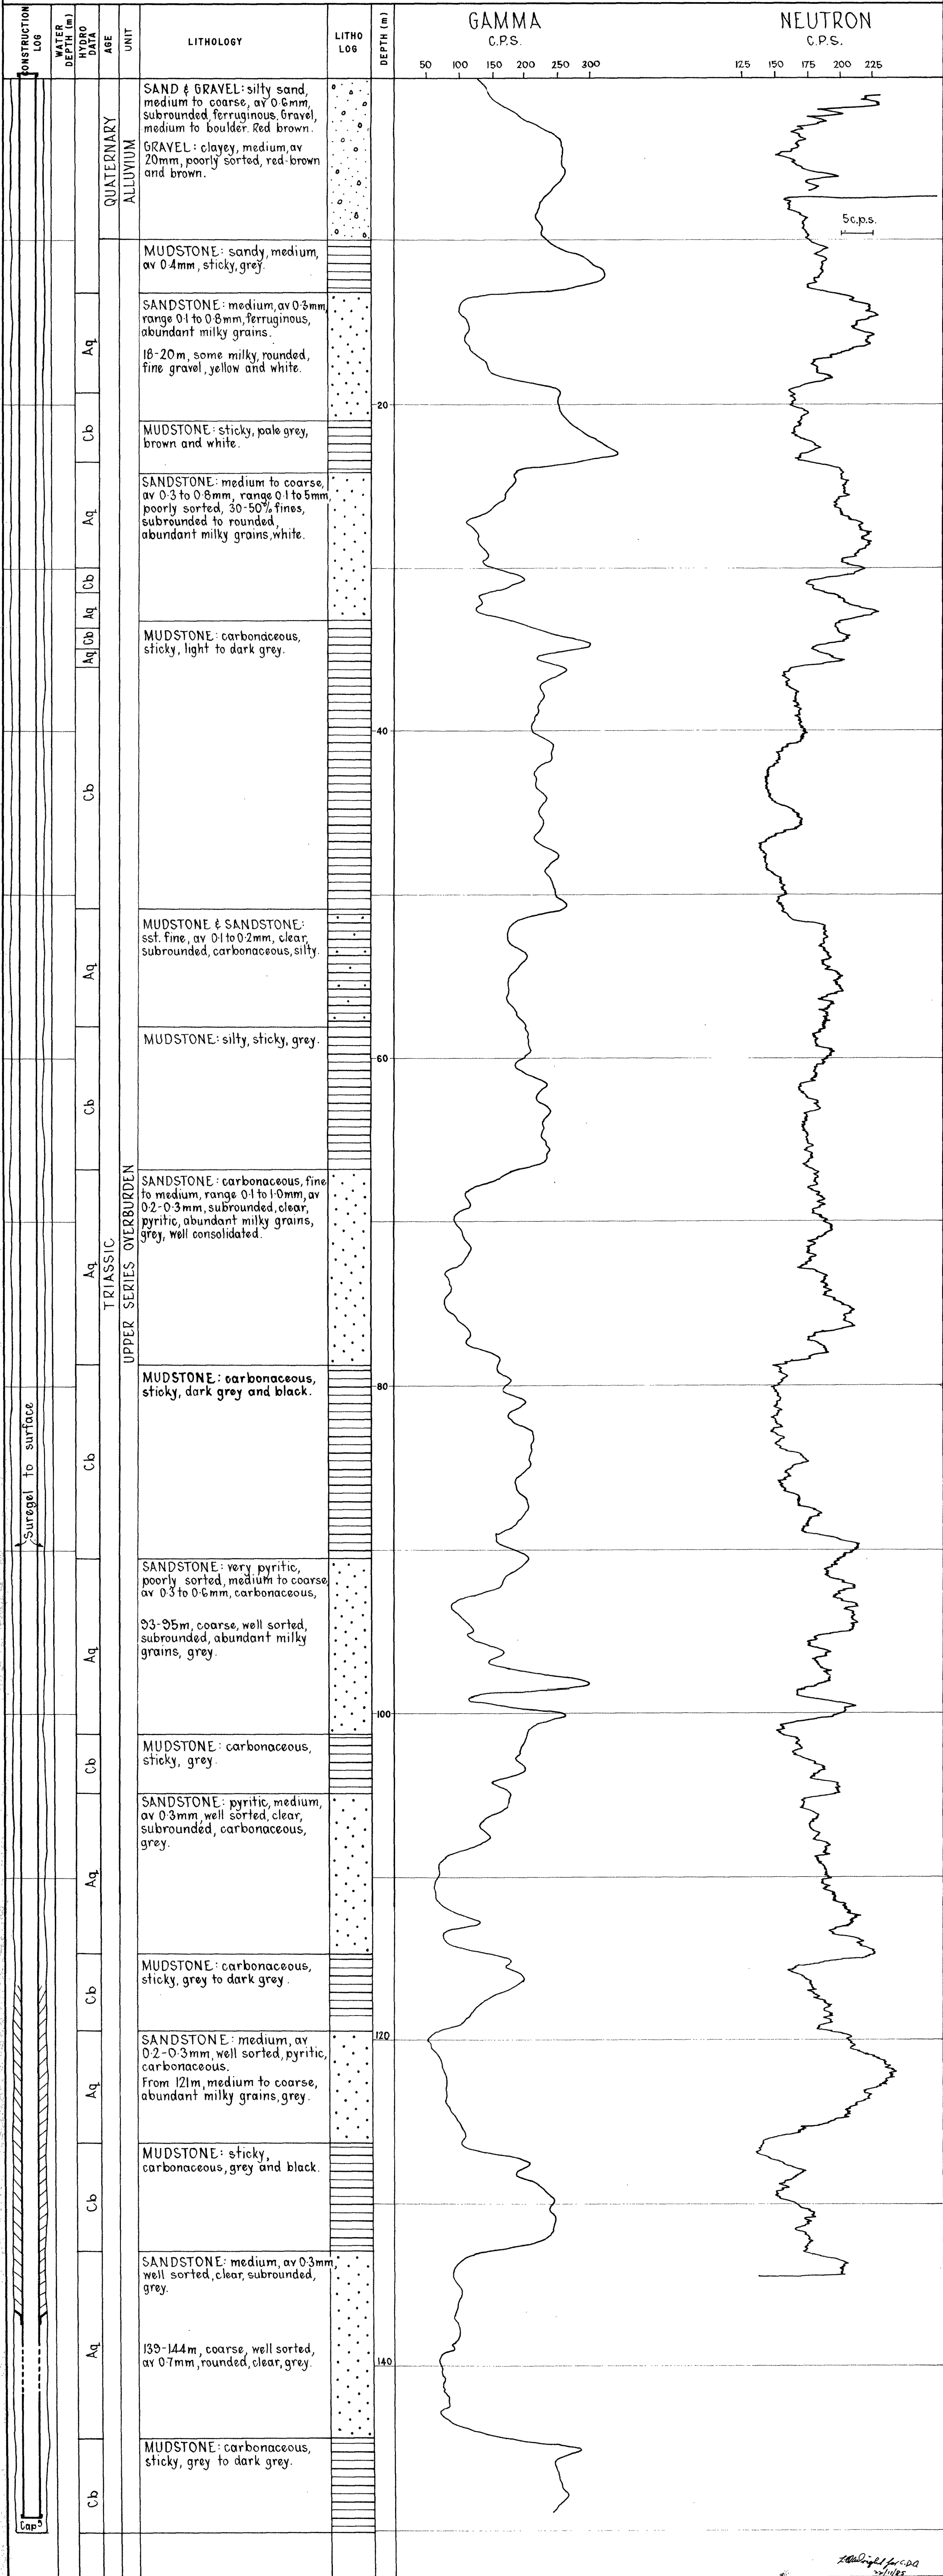

## COMPOSITE WELL LOG - GROUNDWATER

PROJECT: LEIGH CREEK LOBE B - UPPER SERIES DEWATERING

LOG SYMBOLS

LOCATION: K.2722-44/2326-72 (60m Radius from 9040W)

CASING SEAL

GRAVEL PACKED INTERVAL

SECTION: HUNDRED:

WIREWOUND SCREEN

HYDRAULIC CONDUCTIVITY  
(m/day, Estimated)

REFERENCE ELEV. 195.77 (TOD) m A.H.D. LOGGED BY: D.R. EDWARDS

SLOTTED CASING

## CONSTRUCTION DETAILS

DRILLING TECHNIQUE: ROTARY MUD  
CIRCULATION: MUD (HYDROPOL) RESISTIVITY:  
START: 2-6-83 FINISH: 3-6-83 TOTAL DEPTH: 128m

HOLE DIAMETER	mm.	FROM (m)	TO (m)
	150	0	128

CASING DIAMETER	50 Class 18 P.Y.C.	+0.34	128


SCREEN DETAILS	Slotted P.Y.C. (3mm slots)	117	119
	Linatex seal at 115m, Cement from 115m to 95m.		

TYPE OF LOG	16in. NORMAL	64in. NORMAL	6ft. LATERAL	SELF POTENT.	POINT RESIST.	NEUTRON	GAMMA	DENSITY
DATE OF RUN						8-7-83	2-6-83	
FIRST READING				N.B. Neutron logged inside casing		123	128	
LAST READING						111	0	
RECORDED BY						D.R. Edwards		

DEPTH TO WATER	TOTAL DISSOLVED SOLIDS		DATE
	mg/L	Analysis No.	
18.60m	15000		
(T.O.C. 21-7-83)			

REMARKS:

SITE 2 (U25)

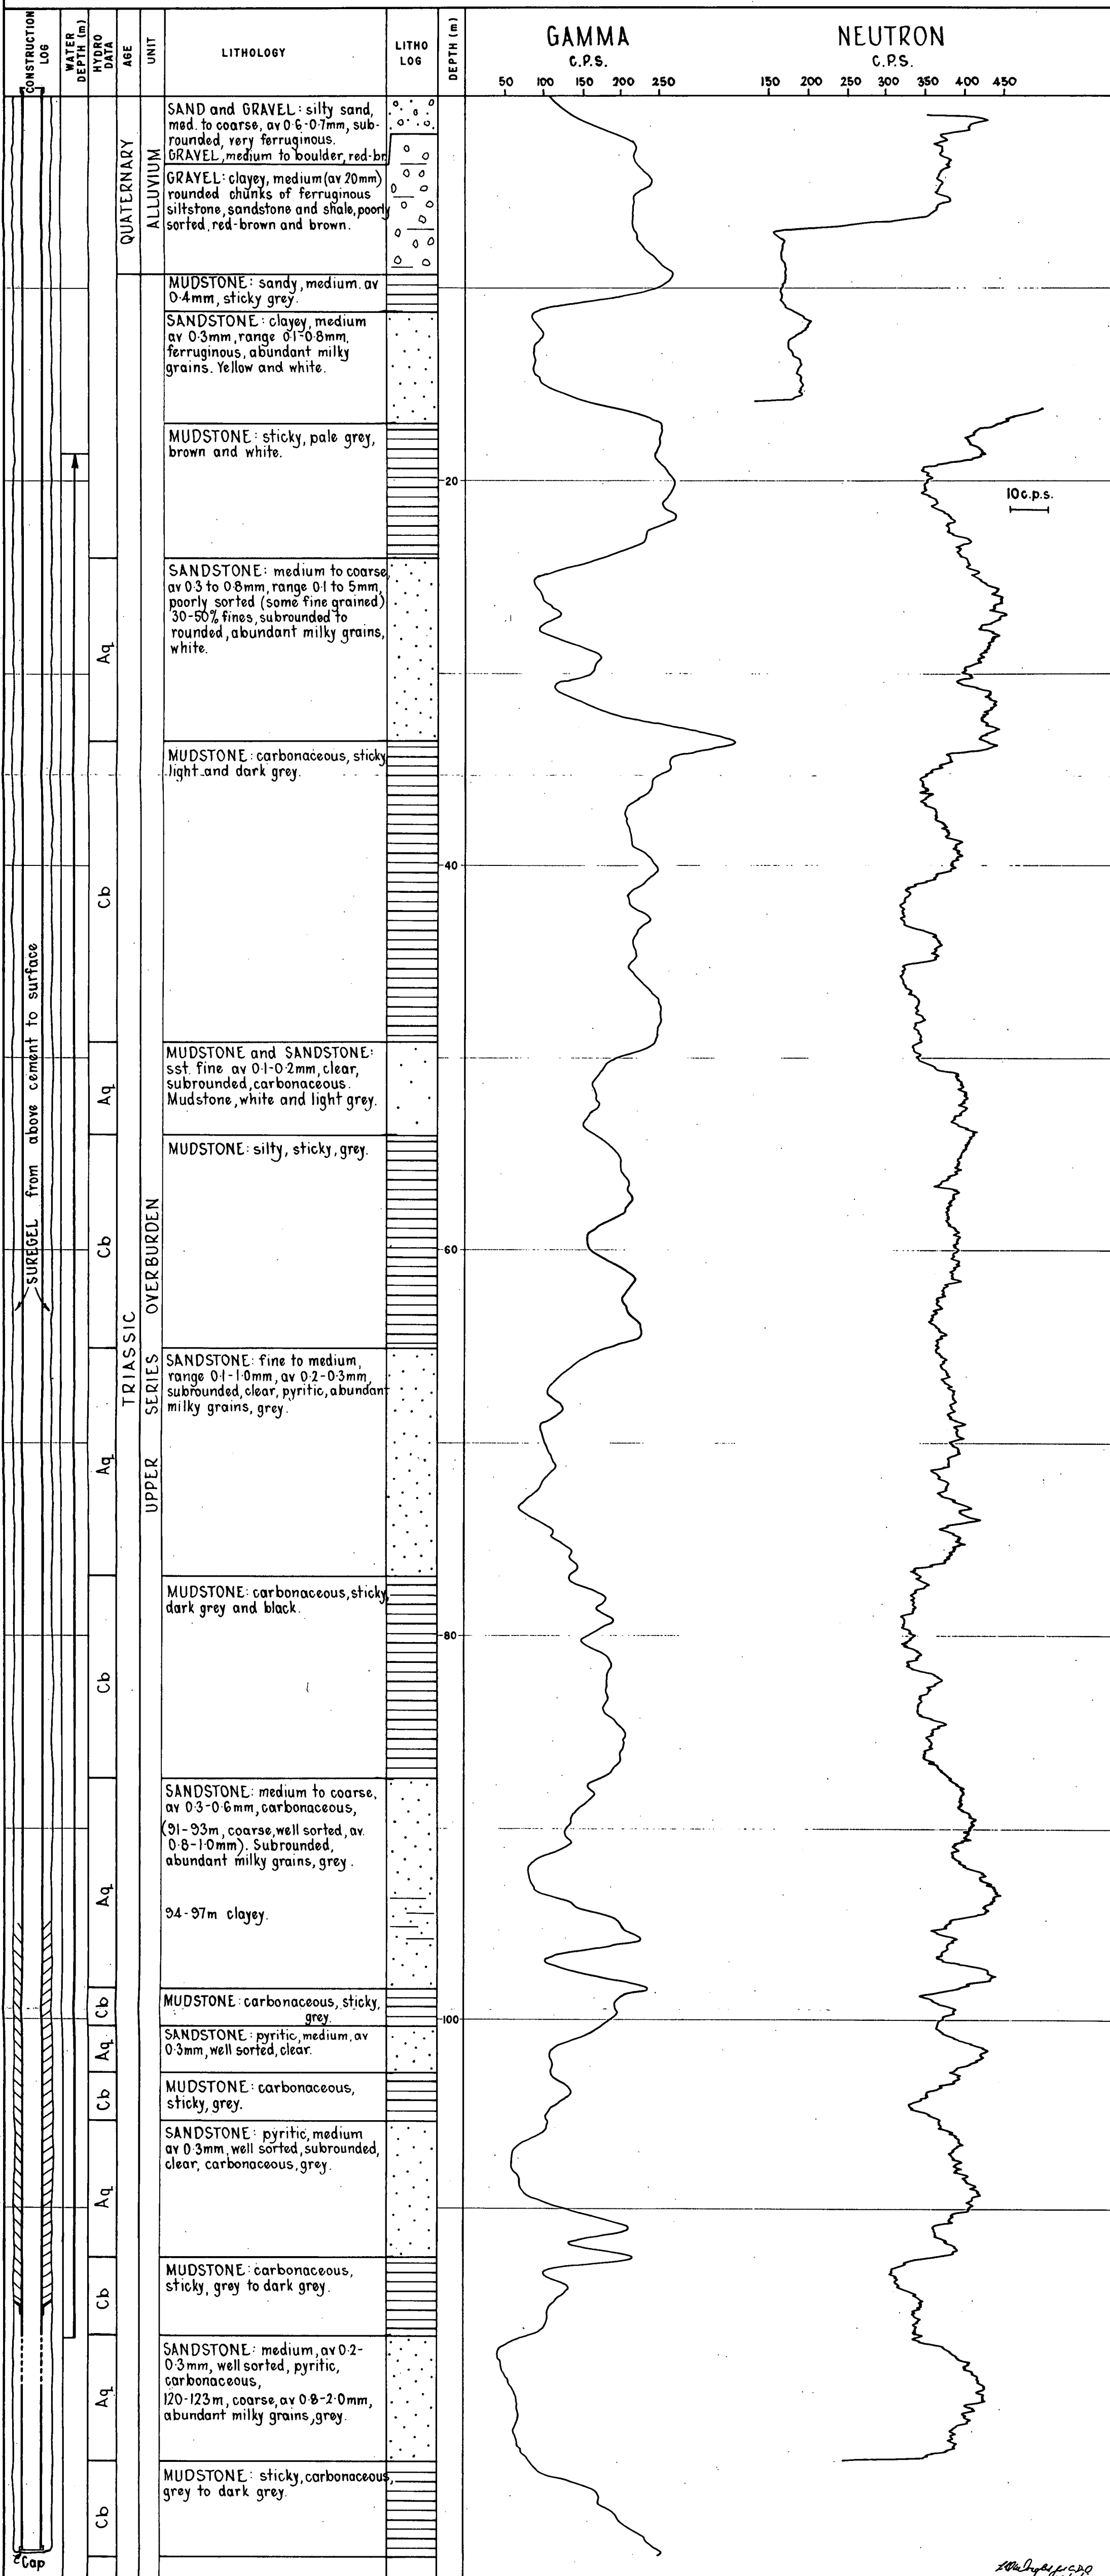

COMPOSITE WELL LOG - GROUNDWATER

E.T.S.A. WELL N° 9043P/  
9044P

PROJECT: LEIGH CREEK LOBE B. UPPER SERIES DEWATERING

LOG SYMBOLS

LOCATION: K 2791: 69/2393: 38 (120m Radius from 9040W)

CASING SEAL

GRAVEL PACKED INTERVAL

SECTION: HUNDRED:

WIREWOUND SCREEN

K HYDRAULIC CONDUCTIVITY  
(m/day, Estimated)

REFERENCE ELEV. 195.57m A.H.D. - 9043P  
195.65m A.H.D. - 9044P

LOGGED BY: D.R. EDWARDS

SLOTTED CASING

CONSTRUCTION DETAILS

DRILLING TECHNIQUE: ROTARY MUD  
CIRCULATION: MUD (HYDROPOL) RESISTIVITY:  
START: 21-7-83. FINISH: 22-7-83 TOTAL DEPTH: 94m.

HOLE DIAMETER	mm.	FROM (m)	TO (m)
	150	0	94
CASING DIAMETER	50 Class 18 PVC	+0.25	94
	50 Class 18 PVC	+0.33	65
SCREEN	50mm Slotted PVC	(Deep) 70	72
DETAILS	50mm Slotted PVC	(Shallow) 58	60


TYPE OF LOG	16 in. NORMAL	64 in. NORMAL	6 ft. LATERAL	SELF POTENT.	CALIPER	NEUTRON	GAMMA	DENSITY
DATE OF RUN						22-7-83		
FIRST READING					93	93.5	93.5	93.5
LAST READING					2	0	0	0.4
RECORDED BY						D. R. EDWARDS		

DEPTH TO WATER	TOTAL DISSOLVED SOLIDS		DATE
	mg/L	Analysis No.	
18.40 (r.o.c.) 9043P	14,000		
15.40 (r.o.c.) 9044P	267-83		

REMARKS: SITE 2 (U25)

For Grain Size Analysis  
Interval m to m

See plan No.

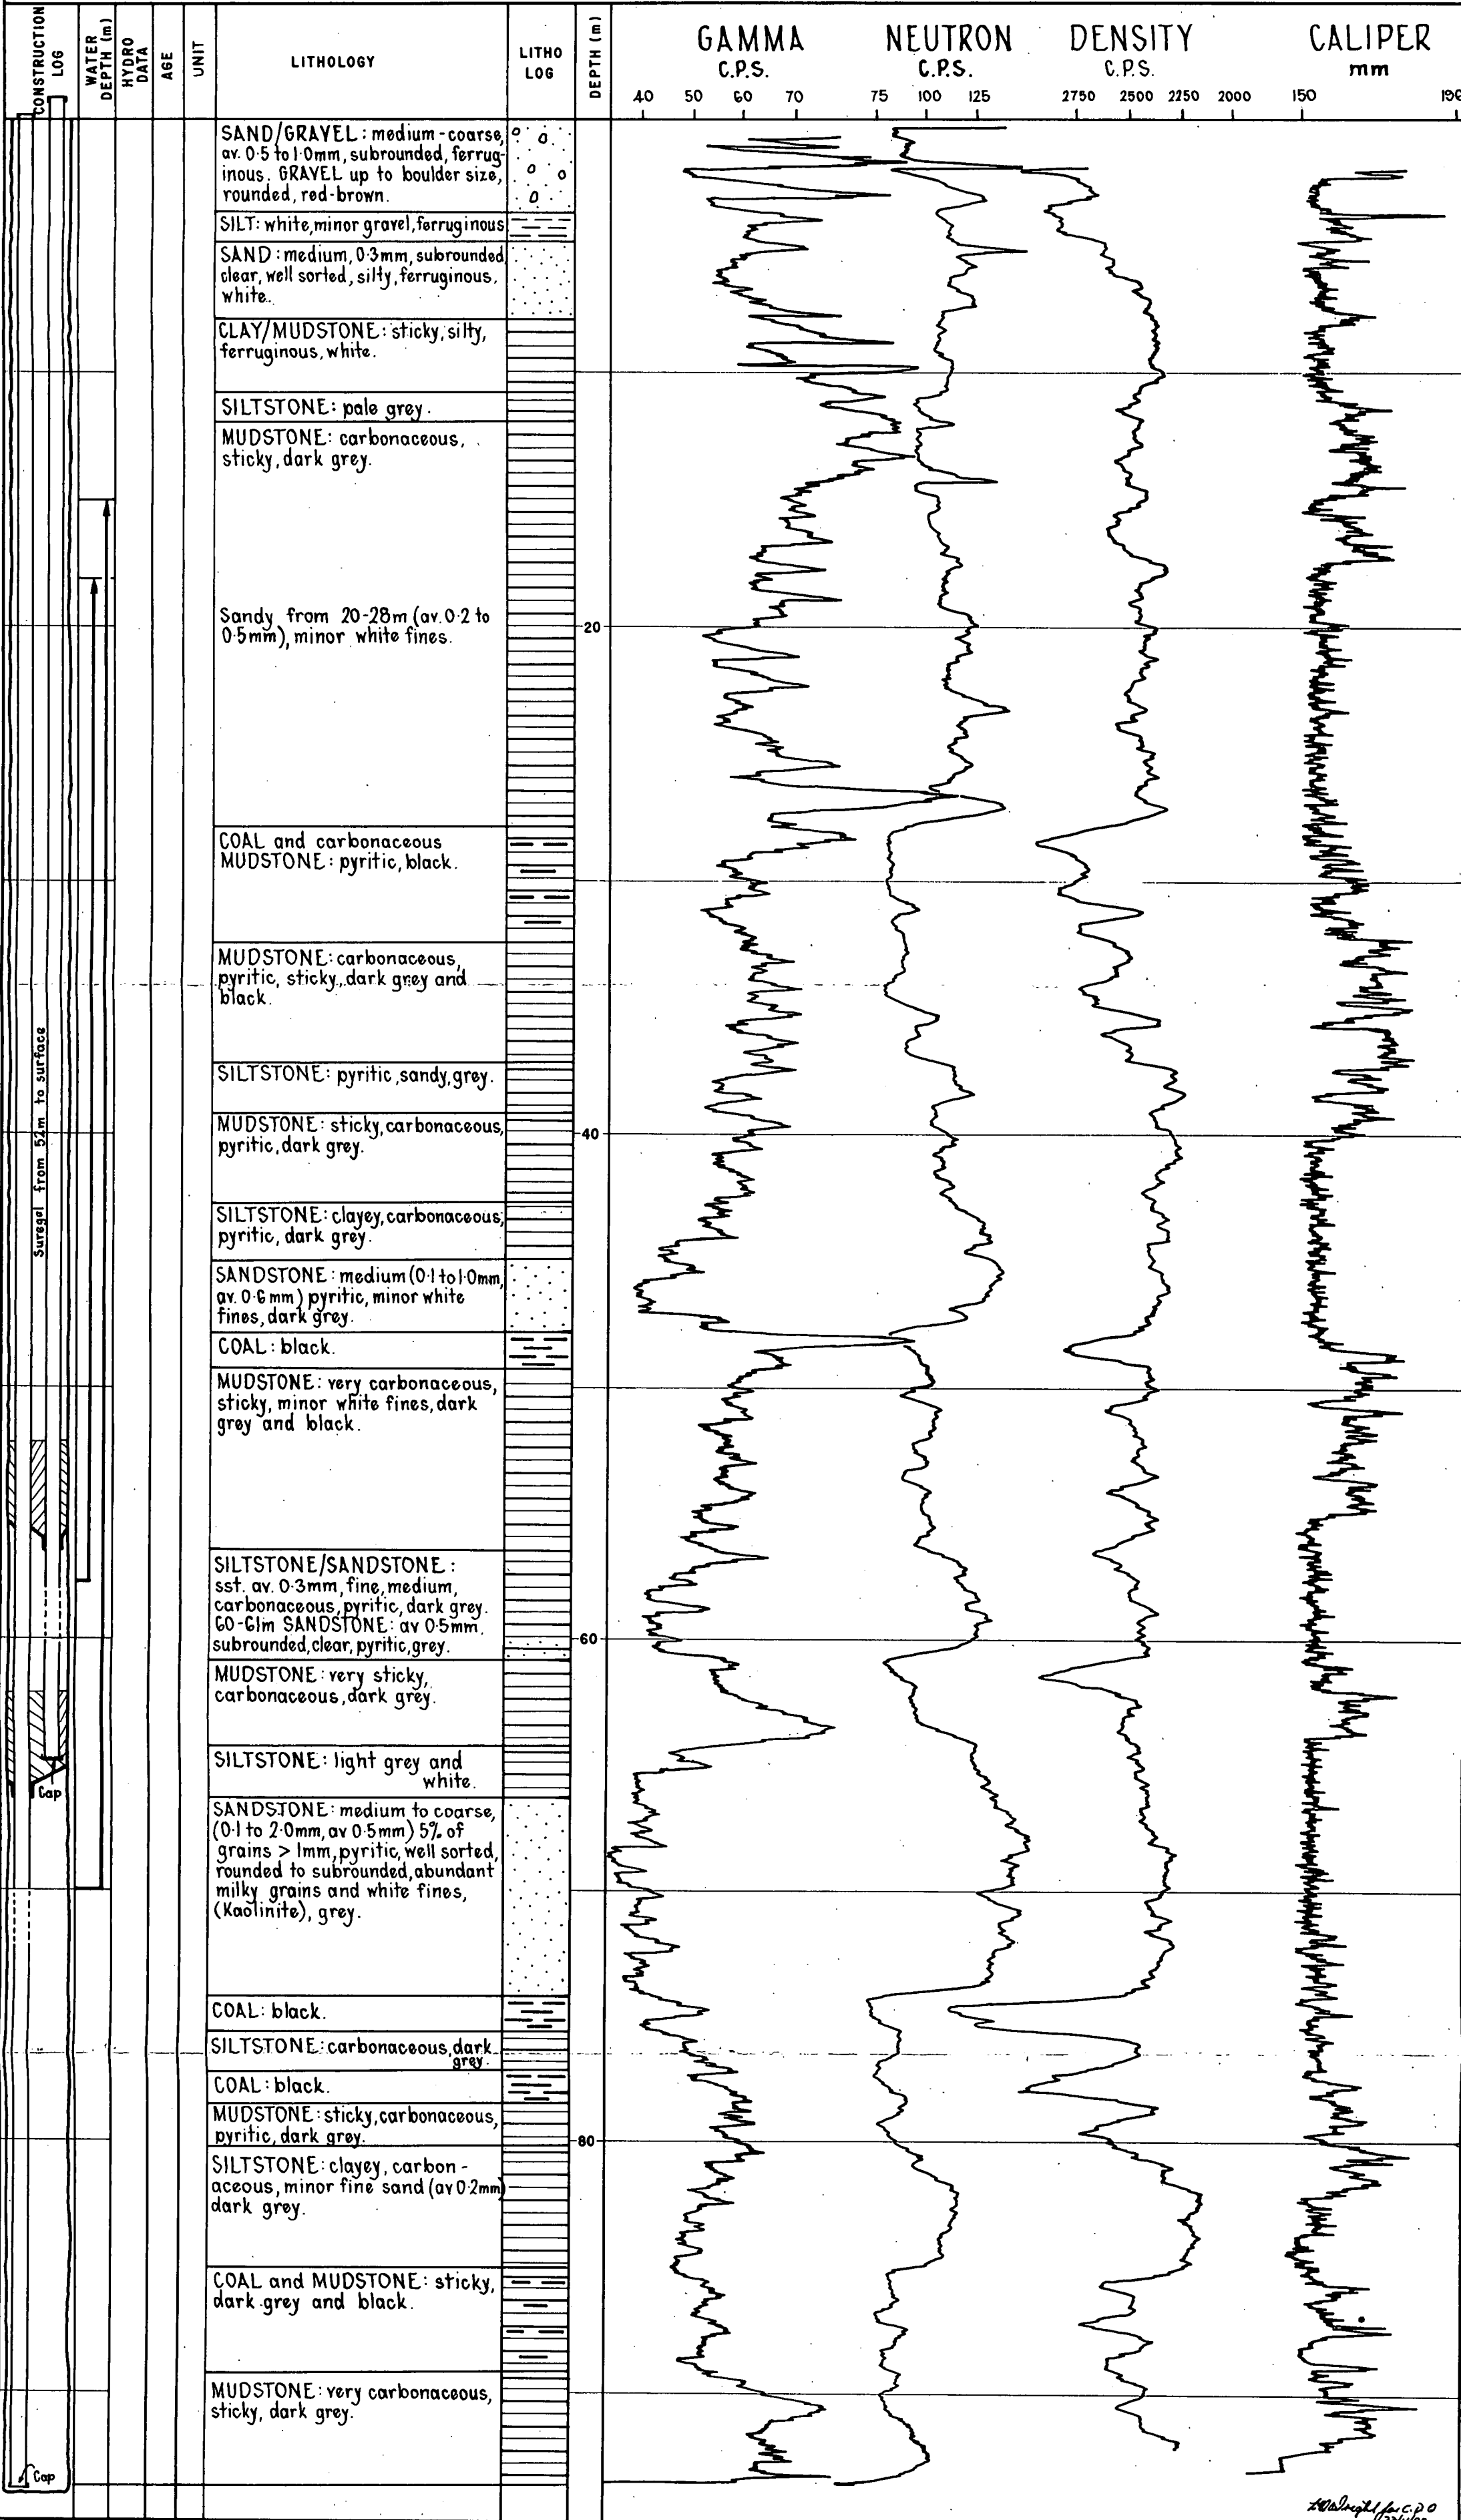

PROJECT: Upper Coal Series Dewatering Leigh Creek

MINES DEPARTMENT — SOUTH AUSTRALIA  
ENGINEERING DIVISION

HOLE NO: 9040 W \*

LOCATION OR COORDS: K 2672.38/2360.24 (Production Well)

## WATER WELL LOG

UNIT / STATE NO

6537-46+φw-598

SEC.

HD:

El Surface

El Ref. Point 195+42

m

m

Datum AHD

(TOC)

92893  
DM PERMITS 92974

AQUIFER  SUMMARY:	DEPTH TO WATER CUT (m)	DEPTH TO STANDING WATER (m)	INTERVAL TESTED		SUPPLY			TOTAL DISSOLVED SOLIDS
			From:	To:	kilolitres/day *	Test Length (hrs)	Method	milligrammes/litre
			Analysis No:					
		20.05 (TOC) 15/6/83	145 - 150 (200 mmID 0.4 mm Aperture)		40 L/sec	8 hours	Air lifting	14,068
								W—

DEPTH (m)		GRAPHIC LOG	ROCK / SEDIMENT NAME	GEOLOGICAL DESCRIPTION	FORMATION / AGE	DEPTH CORE SAMPLE	CASING		
From	To						dia (mm)	From (m)	To (m)
00	7		SAND/GRAVEL	very ferruginous, medium sand <del>save</del> boulder gravel up to 50 mm, poorly sorted. Red Brown			203	+0.3	157
7	11		CLAY	gravelly ferruginous sandy mottled grey/red brown.			ID		
11	34		MUDSTONE	sticky grey.			chem	line.	
34	38		SANDSTONE/gravel	medium sandstone and fine gravel clear, clayey and white.			OPEN HOLE		
38	47		Mudstone	sticky grey.			157	to	169m
47	58		Gravel/Sandst	fine gravel medium sandstone, milky fines (kaolinitic). Pale grey and white					
58	82		Mudstone	sticky pale grey and white					
82	84		Coal	Black					
84	99		Mudstone	sandy, sticky, carbonaceous. Grey.					
99	105		Sandstone	medium, well sorted, subrounded, carbonaceous, pyritic, grey.					

REMARKS: SITE 2 (U25):

\* NOTE: 110 kl / day = 1000 gph / hr.

DRILL TYPE: ROTARY

COMPLETED: 14/6/83

CIRCULATION: MUD

LOGGED BY: D.R. EDWARDS

SHEET... 1 ..... OF... 2 .....

DATE: 6/6/83

(Permit 92974 refers to construction alteration). 125 mm telescopic string and portion of annulus sand pack removed/stabilized on 20/7/83. \*Replacement well for 9030 (collapsed/abandoned) - see composite log for lithology of 9030.

PROJECT: Upper Coal Series Dewatering Leigh Creek

MINES DEPARTMENT — SOUTH AUSTRALIA  
ENGINEERING DIVISION

HOLE NO: 9041 P

LOCATION OR COORDS: K 2718.60/2330.52 (55 m radius from 9040W)

## WATER WELL LOG

UNIT / STATE NO

6537-4610W-578

DM PERMIT 92791

SEC. MD. EL Surface 195.65 m  
EL Ref. Point 195.65 m Datum AHD

AQUIFER  SUMMARY:	DEPTH TO WATER CUT (m)	DEPTH TO STANDING WATER (m)	INTERVAL TESTED		SUPPLY			TOTAL	DISSOLVED	SOLIDS
			From:	To:	kilolitres/day*	Test Length (hrs)	Method	milligrammes/litre	Analysis No:	
		20.71 m TOC	139-141 3 mm slots gauge wrapped				Air lifted	14,500 mg/l (approx)		W —

DEPTH (m)		GRAPHIC LOG	ROCK / SEDIMENT NAME	GEOLOGICAL DESCRIPTION	FORMATION / AGE	DEPTH COPE SAMPLE	CASING		
From	To						Dia (mm)	From (m)	To (m)
0	10		Sand and gravel	medium to coarse sand av 0.6 mm, subrounded, gravel, medium to boulder Red Brown			50	+0.25	149
10	13		Mudstone	sandy, sticky, grey					
13	34		SANDSTONE	clayey, medium av 0.3 mm, milky grains, kaolinitic, white. MUDST 23-25m.					
34	51		MUDSTONE	carbonaceous sticky light grey/dark grey					
51	67		Mudstone and Sandstone	sandstone-fine, carbonaceous, white and light grey.					
67	80		SANDSTONE	fine to medium subrounded, clear, pyrites, kaolinitic, grey.					
80	92		MUDSTONE	carbonaceous, sticky, dark grey and black					
92	101		SANDSTONE	medium to coarse carbonaceous, milky grains, subrounded, grey.					
REMARKS: SITE 2 (U25) * NOTE: 110 l / day = 1000gals / hr.						DRILL TYPE: ROTARY		COMPLETED: 1-6-83	
						CIRCULATION: Mud		LOGGED BY: D.R. Edwards	
						SHEET 1 OF 2		DATE: 31-5-83 1-6-83	

PROJECT: Upper Coal Series Dewatering High Creek

MINES DEPARTMENT — SOUTH AUSTRALIA  
ENGINEERING DIVISION

HOLE NO: 9042 P

LOCATION OR COORDS: K 2722.44/2326.72 (60 m radius from 9040 W)

## WATER WELL LOG

UNIT / STATE NO

6537-46+65-579

SEC.

HD.

EL Surface

m

EL Ref. Point 195.77

m

Datum AHD

DM PERMIT 92892

AQUIFER  SUMMARY:	DEPTH TO WATER CUT (m)	DEPTH TO STANDING WATER (m)	INTERVAL TESTED		SUPPLY			TOTAL DISSOLVED SOLIDS
			From:	To:	kilolitres/day *	Test Length (hrs)	Method	milligrammes/litre Analysis No:
		18.60 m TOC 21/7/83	117	119 (3 mm slots) guage wrapped.			Air lifted	14,500 mg/l (approx) W —

DEPTH (m)		GRAPHIC LOG	ROCK / SEDIMENT NAME	GEOLOGICAL DESCRIPTION	FORMATION / AGE	DEPTH COPE SAMPLE	CASING		
From	To						Dia (mm)	From (m)	To (m)
00	9		Sand & Gravel clayey	medium to coarse sand, average 0.6/0.7 mm, medium to boulder gravel Red Brown			50	+0.34	m
9	11		Mudstone	sandy, grey			class		±128
11	16		Sandstone	medium av 0.3 mm ferruginous, kaolinitic, yellow/ white			18		
16	24		Mudstone	sticky pale grey, brown and white.			PVC		
24	32		SANDSTONE	medium to coarse av 0.3 to 0.8 mm, poorly sorted, 30% kaolinitic fines, white			cap at end		
32	64		MUDSTONE	(same sandstone lenses 49-54 m) sticky, carbonac- eous, light and dark grey.					
64	78		SANDSTONE	fine to medium av 0.2/0.3 mm subrounded, clear, r pyritic, grey.					
78	90		MUDSTONE	carbonaceous, sticky, dark grey and black.					

REMARKS: SITE 23 (U25)

\* NOTE: 110 kl / day = 1000gals / hr.

DRILL TYPE: ROTARY

COMPLETED: 3/6/83

CIRCULATION: MUD

LOGGED BY: D.R. EDWARDS

SHEET 1 OF 2

DATE: 2/6/83

PROJECT: Upper Coal Series Dewatering Leigh Creek

MINES DEPARTMENT — SOUTH AUSTRALIA  
ENGINEERING DIVISION

HOLE NO: 9043 P

9044 P

LOCATION OR COORDS: K 2791.69/2393.38 (120 m radius from 9040)

## WATER WELL LOG

UNIT / SCALE NO  
6537-46103-570  
6537-46103-571

DM PERMIT 92795

SEC.

HD.

EL Surface

EL Ref. Point 195.65 (9044 P)

Datum AHD

(TOC) 195.57 (9043 P)

AQUIFER  SUMMARY:	DEPTH TO WATER CUT (m)	DEPTH TO STANDING WATER (m)	INTERVAL TESTED		SUPPLY			TOTAL DISSOLVED SOLIDS
			From:	To:	kilolitres/day*	Test Length (hrs)	Method	milligrammes/litre
								Analysis No:
	66 m	18.40 TOC (9043 P)	70	72	3mm slots guage wrapped		Air lifted	14,500 mg/l (approx)
	56 m	15.40 TOC (9044 P)	58	60				

DEPTH (m)		GRAPHIC LOG	ROCK / SEDIMENT NAME	GEOLOGICAL DESCRIPTION	FORMATION / AGE	DEPTH CODE SAMPLE	CASING		
From	To						dia (mm)	From (m)	To (m)
0	8		SAND/GRAVEL	medium sand and boulder sized gravel ferruginous Red Brown		9043 P COMPLETION	(50	+0.25	94
8	28		MUDSTONE	silty, sandy carbonaceous, sticky minor white fines grey			18	(slots	
28	33		COAL	Black			PVC	70=72	
33	45		MUDSTONE AND SILTSTONE	carbonaceous, pyritic Dark grey and black.			LINATEX SEAL	at 66 m cement	from 66-62 m
45	48		SANDSTONE	medium av 0.5 mm, carbonaceous, pyritic, Dark grey.		9044 P COMPLETION	(50	+0.33	65
48	49		COAL	Black			18	(slots	
49	56		Mudstone	carbonaceous sticky Dark grey/Black			PVC	58=60	
56	61		SANDSTONE	medium to coarse, kaolinitic, grey			LINATEX SEAL	AT 56 m cement	from 56 to 52 m
61	66		Mudstone and SILTSTONE	carbonaceous, sticky dark grey				suregel 52 m	to surface
66	74		SANDSTONE	medium to coarse pyritic, grey.					

REMARKS: SITE 2 (U25)

\* NOTE: 110 kl / day = 1000 gals / hr.

DRILL TYPE: ROTARY

COMPLETED: 21/7/83

CIRCULATION: MUD

LOGGED BY: D.R. EDWARDS



SHEET 1 OF 2

DATE: 21/7/83

APPENDIX 3


		<u>Plan No.</u>
U/27 Site Well Location		S17453
Composite log	9050W	83-510
	9051P	83-511
	9052P	83-515
	9053P	83-512
	9054P	83-514
Summary Cuttings Logs	9050W	
	9051P	
	9052P	
	9053P	
	9054P	
905W Caliper Logging		S17454



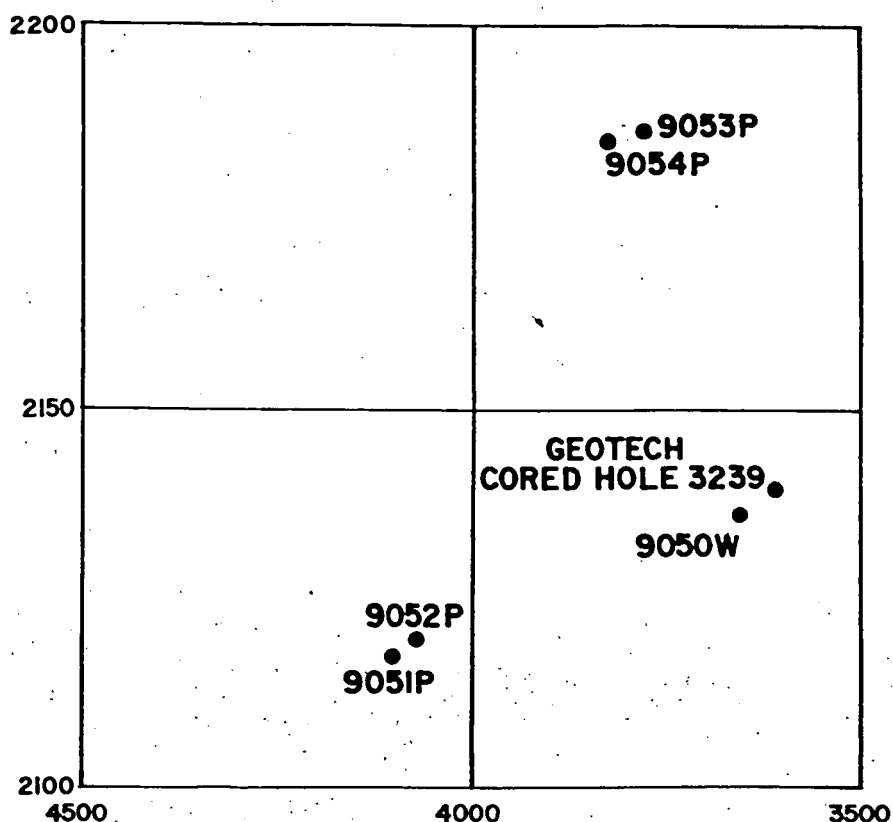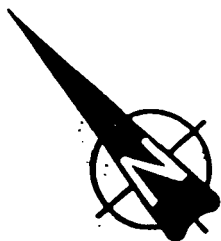

For all SADME Well Unit No's see appendix 6

### APPENDIX 3

 DEPARTMENT OF MINES AND ENERGY SOUTH AUSTRALIA  LEIGH CREEK COALFIELD LOBE B GROUNDWATER INVESTIGATION  U/27 SITE WELL LOCATIONS E.T.S.A. 'K' GRID	COMPILED D.E.B D.A.	<i>W</i> C D O DATE
	DRAWN G.B.	SCALE 1:1000
	DATE 19 JUL 84	PLAN NUMBER
	CHECKED	S17453

COMPOSITE WELL LOG - GROUNDWATER

PROJECT: LEIGH CREEK LOBE B. UPPER SERIES DEWATERING  
LOCATION: K2136/45/3966-65  
SECTION: HUNDRED:  
REFERENCE ELEV. 192.37 (T.O.C.) m A.H.D. LOGGED BY: D. R. EDWARDS

LOG SYMBOLS


CASING SEAL  
GRAVEL PACKED INTERVAL  
WIREWOUND SCREEN  
HYDRAULIC CONDUCTIVITY (m/day, Estimated)  
SLOTTED CASING

CONSTRUCTION DETAILS			
DRILLING TECHNIQUE: ROTARY			
CIRCULATION: MUD (To 129m)-AIR (129m to 160m)			
START: 29-7-83 FINISH: 9-8-83 TOTAL DEPTH: 160m.			
HOLE DIAMETER	mm.	FROM (m)	TO (m)
	381	0	128
	199-8	128	160
CASING DIAMETER	203 I.D. CHEMLINE	+0.78	121
	203 I.D. CHEMLINE	126	128 (open)
SCREEN DETAILS	203 I.D. Stainless steel (2mm aperture)	121	126

TYPE OF LOG	16 in. NORMAL	64 in. NORMAL	6 ft. LATERAL	CALIPER	CALIPER	NEUTRON	GAMMA	DENSITY
DATE OF RUN				After jetting	Before jetting	2-8-83	8-8-83	8-8-83
FIRST READING					150.6	161	160.5	160.5
LAST READING					0.4	1	0	120
RECORDED BY				A. Young		D. R. Edwards		

DEPTH TO WATER	TOTAL DISSOLVED SOLIDS		DATE
	mg/L	Analysis No.	
21-55 T.O.C.	14270		9-8-83
15-8-83			

REMARKS:  
SITE 3  
Wells logged twice: 1. 0-129m  
2. 160-120m.

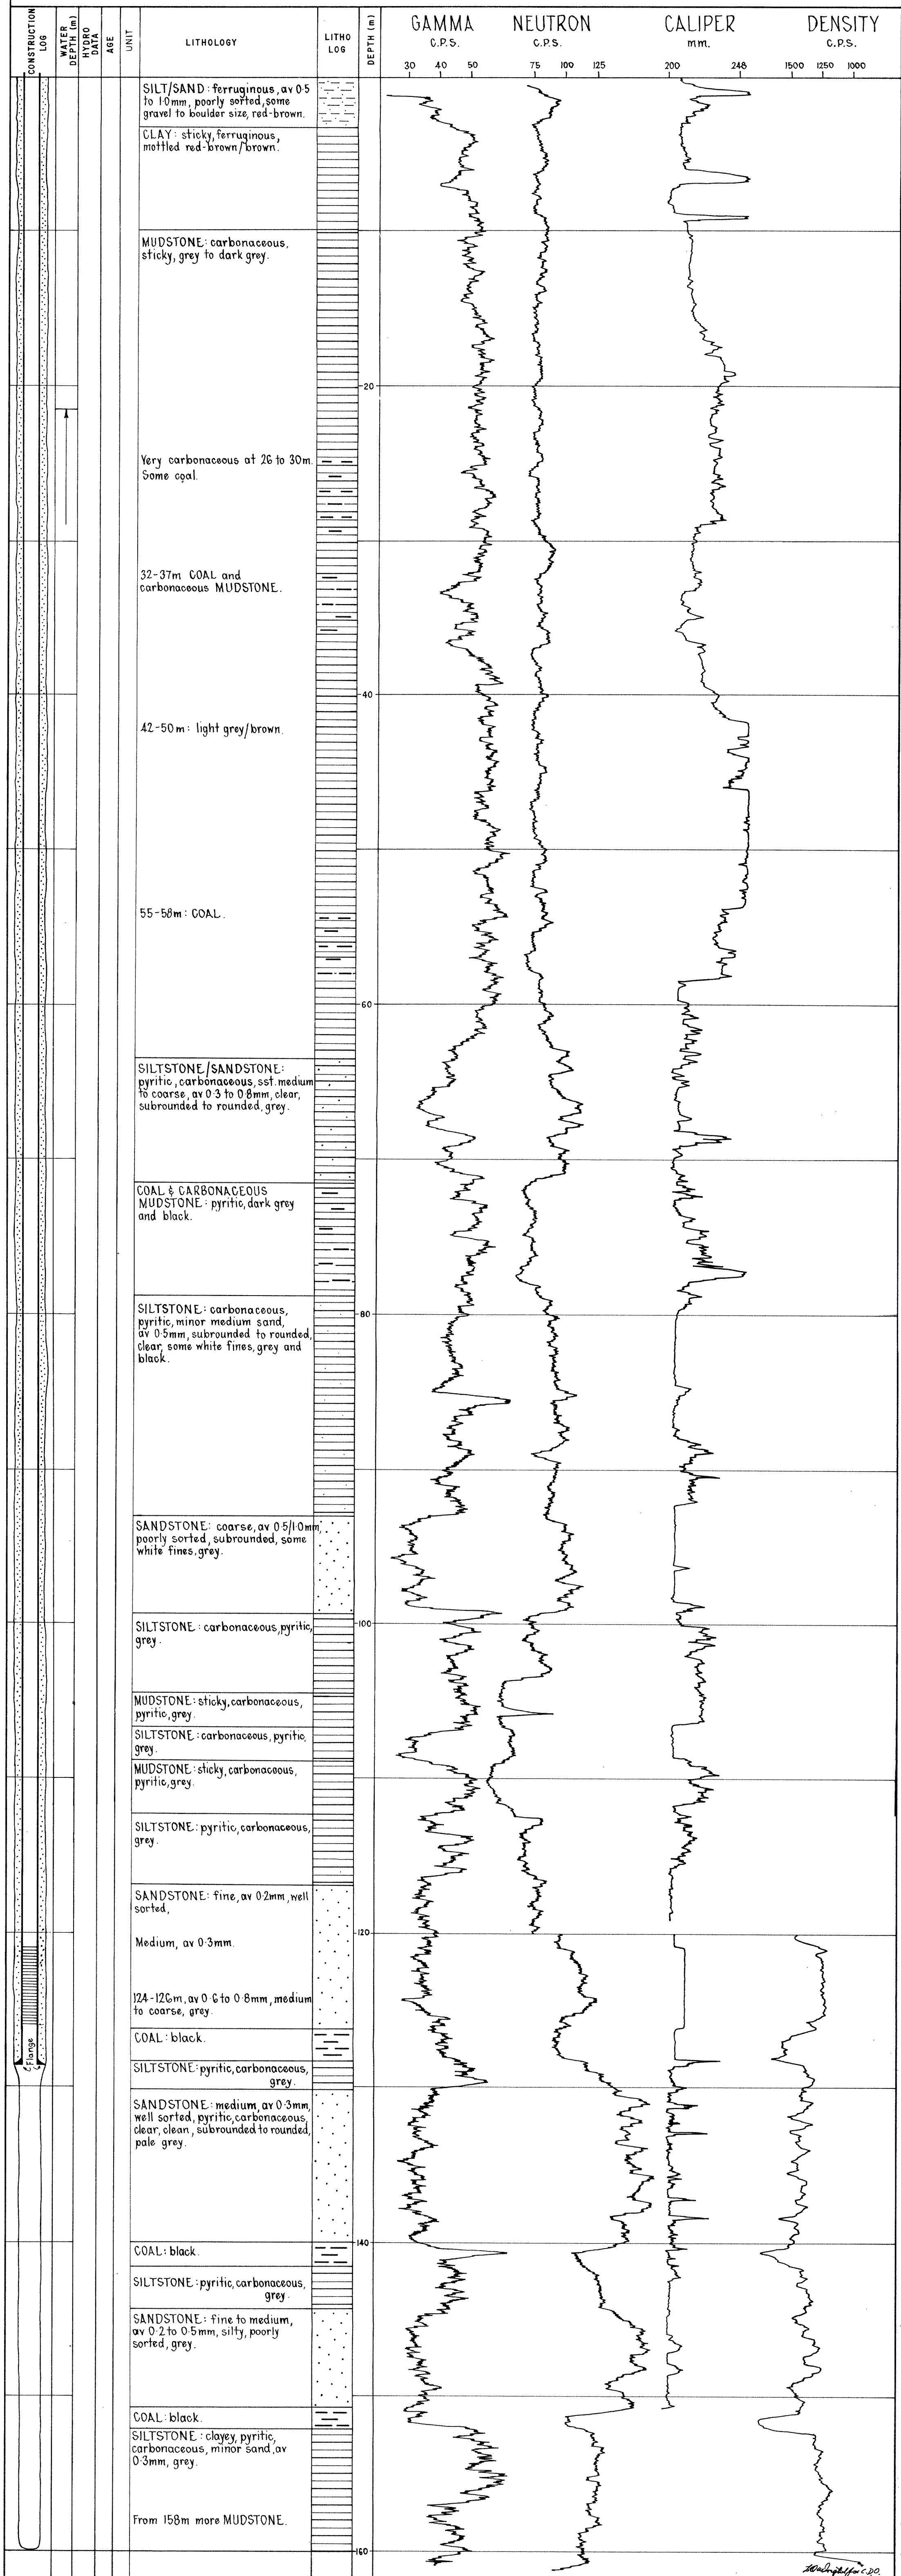

# COMPOSITE WELL LOG - GROUNDWATER

WELL 653747mOW00537 UNIT No.
PERMIT No. 92895
PLAN No. 83-511
E.T.S.A. WELL No. 9051P

PROJECT: LEIGH CREEK LOBE B. UPPER SERIES DEWATERING . . . . .

LOG SYMBOLS

LOCATION: K2117.36/4010.79. (50m Radius from 9050W) . . . . .

| | CASING SEAL                      || GRVEL PCKED INTERVAL

SECTION:..... HUNDRED:.....

WIREWOUND SCREEN	K HYDRAULIC CONDUCTIVITY ( $\mu$ - 1 day Estimated)
------------------	--

REFERENCE ELEV 192.80 TO C. m A.H.D. LOGGED BY: D.R. EDWARDS.....

SLOTTED CASING

## CONSTRUCTION DETAILS


DRILLING TECHNIQUE: ROTARY ..... MUD  
CIRCULATION: MUD ..... RESISTIVITY: .....  
START: 18-7-83. FINISH: 19-7-83. TOTAL DEPTH: 164m.

HOLE DIAMETER	mm.	FROM (m)	TO (m)
	150	0	164
CASING DIAMETER	50 Class 18 P.V.C.	+0.40	163
	Linatex seal at 145m		Cement 145-125m
SCREEN DETAILS	Slotted P.V.C.	149	151
	Gauze wrapped		

TYPE OF LOG	16in. NORMAL	64in. NORMAL	6ft. LATERAL	SELF POTENT.	CALIPER	NEUTRON	GAMMA	DENSITY
DATE OF RUN						19-7-83		
FIRST READING					162.5	164.5	164.5	164
LAST READING					0.6	0	1	1
RECORDED BY						D. R. Edwards		

DEPTH TO WATER	TOTAL DISSOLVED SOLIDS		DATE
	mg/L	Analysis No.	
23-34 T.O.C.	14000 (approx.)		
8-8-83			

REMARKS: SITE 3

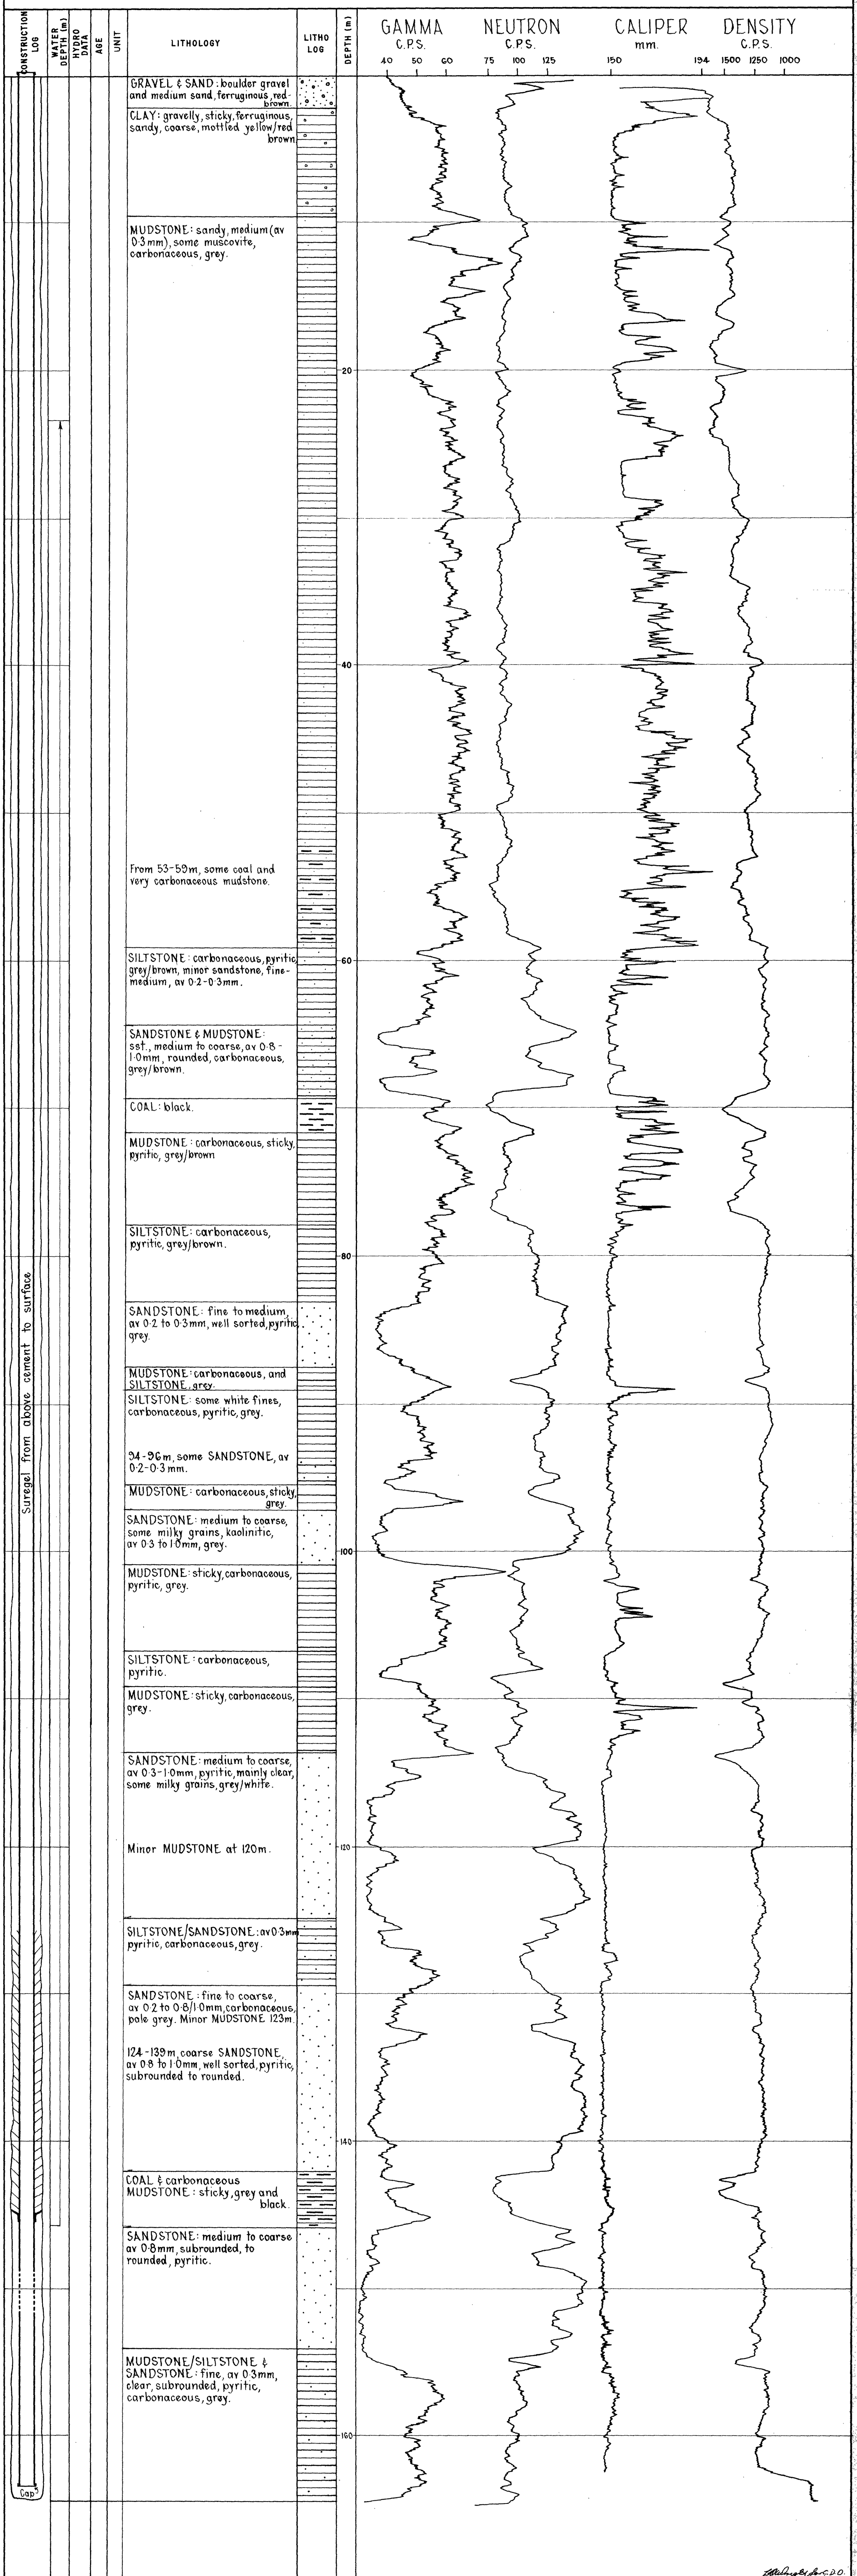

*20/10/85*



COMPOSITE WELL LOG - GROUNDWATER

PROJECT: LEIGH CREEK LOBE B. UPPER SERIES DEWATERING

LOG SYMBOLS

LOCATION: K.2185.27/3982.G1 (55m radius from 9050W)

CASING SEAL

GRAVEL PACKED INTERVAL

SECTION: HUNDRED

WIREWOUND SCREEN

HYDRAULIC CONDUCTIVITY  
(m/day, Estimated)

REFERENCE ELEV. 191.76 (T.O.C.)m A.H.D.      LOGGED BY: D.R. Edwards


SLOTTED CASING

CONSTRUCTION DETAILS			
DRILLING TECHNIQUE: ROTARY		MUD	
CIRCULATION: AIR		RESISTIVITY:	
START: 27.7.83    FINISH: 28.7.83    TOTAL DEPTH: 94m			
HOLE DIAMETER	mm.	FROM (m)	TO (m)
	150	0	94
CASING DIAMETER			
	50	+0.22	94
	(Class 1B PVC)		
SCREEN DETAILS	3mm Slots	86	88
	Linatex seal at 84m - Cement from 84 to 64m		

TYPE OF LOG	16 in. NORMAL	64 in. NORMAL	6 ft. LATERAL	SELF POTENT.	CALIPER	NEUTRON	GAMMA	DENSITY
DATE OF RUN						27.7.83		
FIRST READING					83.5	84.5	85.8	82.8
LAST READING					0.7	0	1	0
RECORDED BY						D.R. Edwards		

DEPTH TO WATER	TOTAL DISSOLVED SOLIDS		DATE
	mg/L	Analysis No.	
19.93	14000		
T.O.C. 8.8.83	(approx.)		

REMARKS: SITE 3  
For Grain Size Analysis  
Interval m to m  
See plan No. ....

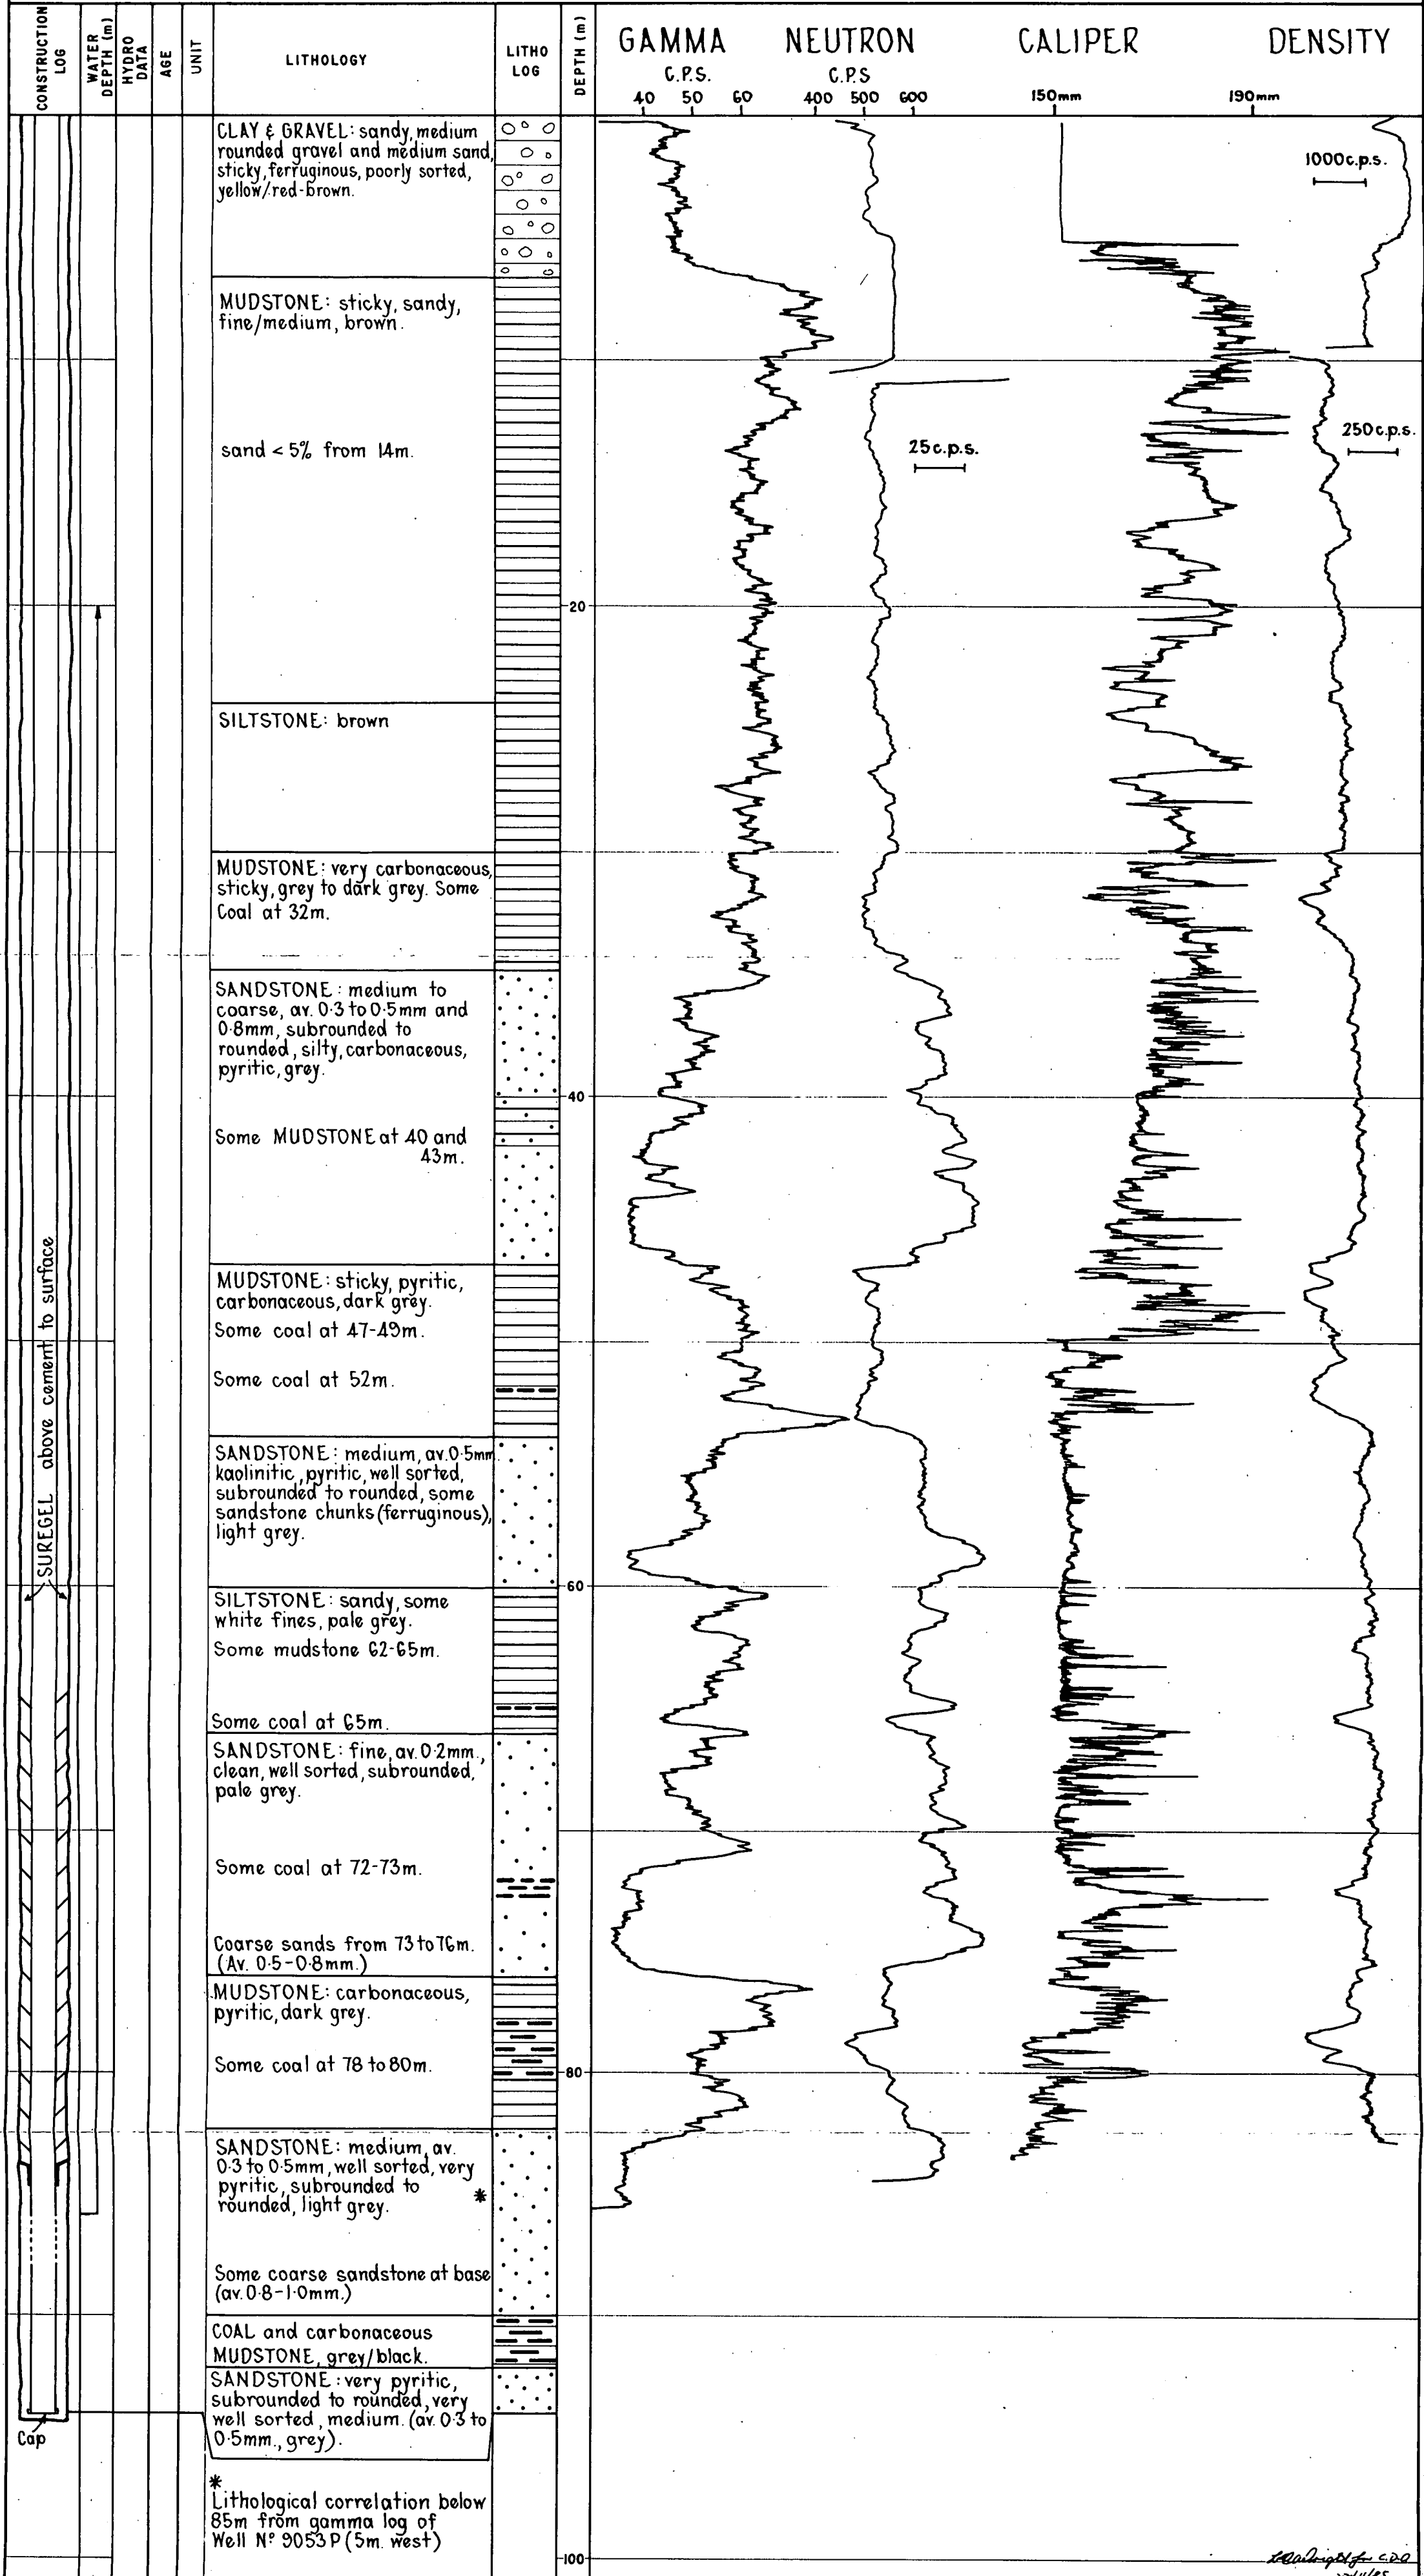

PROJECT: Upper Coal Series Dewatering Lobe B Leigh Creek LOCATION OR COORDS: K. 2136.45/3966.65 (Production Well)										MINES DEPARTMENT — SOUTH AUSTRALIA ENGINEERING DIVISION					HOLE NO: 9050 W		
<b>WATER WELL LOG</b>															UNIT / SHEET NO 6537-47ndw-532		
															DM PERMIT 92894		
SEC.		HD.		EL Surface EL Ref. Point 192.37		m		m		Datum AHD							

AQUIFER	DEPTH TO WATER CUT (m)	DEPTH TO STANDING WATER (m)	INTERVAL TESTED		SUPPLY			TOTAL DISSOLVED SOLIDS	
			From:	To:	kilolitres/day *	Test Length (hrs)	Method	milligrammes/litre	Analysis No:
SUMMARY:		21.55 m TOC 15/8/83	121 SCREENED 128	126 160		16 hours	Air lifting	14,270	W—

open hole

DEPTH (m)		GRAPHIC LOG	ROCK / SEDIMENT NAME	GEOLOGICAL DESCRIPTION	FORMATION / AGE	DEPTH COPE SAMPLE	CASING		
From	To						Dia (mm)	From (m)	To (m)
0	3		SLIT/SAND & GRAVEL	sand average 0.5 mm, gravel up to boulder sized, ferruginous, poorly sorted, red brown.			200 ID	+0.78	128
3	10		CLAY	silty, mottled Red Brown.			Clemline		
10	26		MUDSTONE	sticky carbonaceous grey			Flanged shoe, at	128 m	
26	30		COAL & carbonaceous MUDSTONE	grey					
30	63		Coal & carbonaceous MUDSTONE	grey			OPEN HOLE (199.8 mm DIAM)	128 - 160 m	
63	71		SILTSTONE & SANDSTONE	pyritic, av 0.3/0.5 mm clear, grey.					
71	78		Coal & Mudstone	grey					
78	93		SILTSTONE	grey					
93	99		SANDSTONE	coarse av 0.5/1.00 mm poorly sorted grey					
99	116		MUDSTONE & SILTSTONE	grey					

REMARKS: <u>SITE 3(U27)</u>  *Annulus between casing and hole walls is gravel packed from flange at 128 m to surface, permitting aquifers above screen to contribute.	NOTE: 110 kl / day = 1000gals / hr.		DRILL TYPE: ROTARY	COMPLETED: 5/8/83
			CIRCULATION: MUD/AIR	LOGGED BY: D. EDWARDS
			SHEET 11 OF 2	DATE: 29/7/83 30/7/83

PROJECT: Upper Coal Series Dewatering Lobe B Creek						MINES DEPARTMENT — SOUTH AUSTRALIA ENGINEERING DIVISION						HOLE NO: 9051 P			
LOCATION OR COORDS: K 2117.36/4010.79 (50 m radius from 9050 W)						<b>WATER WELL LOG</b>						UNIT / STATE NO <b>6537-47 m<sub>QW</sub>-537</b>			
SEC.		HD.		EL Surface 192.41 m		m		EL Ref. Point 192.80 m		m		Datum AHD		DM PERMIT 92895	

AQUIFER  SUMMARY:	DEPTH TO WATER CUT (m)	DEPTH TO STANDING WATER (m)	INTERVAL TESTED		SUPPLY			TOTAL DISSOLVED SOLIDS
			From:	To:	kilolitres/day *	Test Length (hrs)	Method	milligrammes/litre
		23.34 TOC 8/8/83	149 151 3 mm slots (guage wrapped)				AIR LIFTED UNTIL CLEAN	14,000 (approx)
Analysis No: W —								

DEPTH (m)		GRAPHIC LOG	ROCK / SEDIMENT NAME	GEOLOGICAL DESCRIPTION	FORMATION / AGE	DEPTH CORE SAMPLE	CASING		
From	To						Dia (mm)	From (m)	To (m)
0	2		GRAVEL & SAND	boulder gravel and medium sand av. 0.2/0.5 mm ferruginous, poorly sorted Red Brown			50	+0.04	163
2	9		CLAY	gravelly, sticky, ferruginous, sandy, mottled yellow and red brown.			18		
9	53		MUDSTONE	sandy (medium), carbonaceous, sticky, grey.					
53	59		COAL & MUDSTONE	sticky grey.					
59	64		SILTSTONE	pyritic, carbonaceous grey					
64	69		SANDSTONE/MUDSTONE	medium/coarse sandstone, carbonaceous pyritic mudstone, grey					
69	71		Coal	black					
71	83		Mudstone/Siltstone	carbonaceous, pyritic grey brown.					
83	87		SANDSTONE	fine/medium av 0.2/0.3 mm grey.					
87	97		MUDSTONE & SILT- STONE	carbonaceous, pyritic, grey.					
REMARKS: <u>SITE 3 (U27)</u>						DRILL TYPE: ROTARY		COMPLETED: 19/7/83	
						CIRCULATION: MUD		LOGGED BY: D.R. EDWARDS	
						SHEET 1 OF 2		DATE: 18/7/83	

\* NOTE: 110 l / day = 1000 gals / hr.

HOLE NO: 9052 P

# WATER WELL LOG

UNIT / ~~STATE~~ NO

6537-47mφw-538

HD.

EL Surface - 192.50

EL Ref. Point 192.741

三

W

**Datum**

AHD

DM PERMIT 92896

DEPTH (m)		GRAPHIC LOG	ROCK / SEDIMENT NAME	GEOLOGICAL DESCRIPTION	FORMATION / AGE	DEPTH COPE SAMPLE	CASING		
From	To						Dia(mm)	From(m)	To(m)
0	4		Gravel & Sand	boulder gravel and medium sand, poorly sorted, ferruginous red brown			50 class 18 PVC	+0.24-144	
4	6		CLAY	gravelly, (rounded), sticky, ferruginous mottled yellow/Red brown					
6	10		SAND	medium (av 0.5 mm) ferruginous, clayey, silty, Red Brown					
10	19		MUDSTONE & SILT-CLAY STONE	sticky, ferruginous, sandy grey			slots 135	137	
19	55		MUDSTONE	sticky, carbonaceous, pyritic, grey/dark grey					
55	58		Coal & Carbonaceous MUDSTONE	sticky, dark grey & black.			slump 137	144	
58	65		Mudstone/Siltstone	sticky, carbonaceous, pyritic dark grey.					
65	70		SANDSTONE	medium to coarse, silty av 0.3/0.8 mm, carbonaceous pyritic grey.					
70	84		Coal MUDSTONE AND SILTSTONE	sticky, carbonaceous, pyritic grey brown.			CINATEX SEAL AT 133 m		
							Suregel 113-0		
								CEMENT FROM 133 - 113	

\* NOTE: 110 kl / day = 1000gals / hr.

COMPLETED: 26/7/83

LOGGED BY D. R. EDWARDS

DATE: 25/7/83



PROJECT: Upper Coal Series Dewatering Lobe B Leigh Creek MINES DEPARTMENT — SOUTH AUSTRALIA  
ENGINEERING DIVISIONLOCATION OR COORDS: K 2186.35/3977.91 (55m radius from 9050 W) **WATER WELL LOG**

El Surface 191.61 m

El Ref. Point 191.76 (TOC) m

Datum AHD

HOLE NO: 9053 P

UNIT / SCALE NO

6537-47m $\phi$ W-599

DM PERMIT 92975

AQUIFER  SUMMARY:	DEPTH TO WATER CUT (m)	DEPTH TO STANDING WATER (m)	INTERVAL TESTED		SUPPLY		TOTAL DISSOLVED SOLIDS	
			From:	To:	kilolitres/day *	Test Length (hrs)	Method	milligrammes/litre
								Analysis No:
		21.44	Slotted	At....	40 m 1.6 l/sec		Air Lifted While Drill- ing	14,000 (approx)
		TOC	PVC		64 m 2.2 l/sec			
		8/8/83			86 m 5.7 l/sec			
			(97 - 99 3 mm slots)		102 m 1.2 l/sec			

DEPTH (m)		GRAPHIC LOG	ROCK / SEDIMENT NAME	GEOLOGICAL DESCRIPTION	FORMATION / AGE	DEPTH COPE SAMPLE	CASING		
From	To						Jia (mm)	From (m)	To (m)
0	2		CLAY	sticky minor gravel, ferruginous red/yellow brown.			50	+0.15	102
2	6		GRAVEL	clayey, (boulder) sandy ferruginous Red and yellow Brown.					class 12 PVC
6	9		CLAY	sticky, minor gravel and sand ferruginous					SLOTS 97-99
9	12		SAND	medium (av 0.3/0.5 mm), subrounded Red/yellow Brown; ferruginous grey.					Slumps 99-102
12	41		MUDSTONE & SILT- STONE	sticky carbonaceous, pyritic grey brown to grey. At 30 - 32 m some COAL					CONATEX SEAL AT
41	46		SANDSTONE	medium to coarse					90 m CEMENT FROM
46	53		Coal & Carbonaceous MUDSTONE	sticky, pyritic, grey and black					90-70 m
53	60		SANDSTONE	medium to coarse av 0.5/0.8 mm, well sorted, sub- rounded, silty, carbonaceous pyritic grey.					SUREGEL
							70-0		

REMARKS: SITE 3 (U27)

\* NOTE: 110 kl / day = 1000 gal / hr.

DRILL TYPE: ROTARY

COMPLETED: 29/7/83

CIRCULATION: AIR

LOGGED BY: D.R. EDWARDS

SHEET 1 OF 2

DATE: 28/7/83

PROJECT: Upper Coal Series Dewatering Lobe B Leigh Creek										MINES DEPARTMENT — SOUTH AUSTRALIA ENGINEERING DIVISION										HOLE NO: 9054 P			
LOCATION OR COORDS: 2185.27/3982.61 (55 m radius from 9050 W)										<b>WATER WELL LOG</b>										UNIT / GRADE NO <b>6537-47mØW-581</b>			
SEC                      HD.										El Surface 191.61                      m El Ref. Point 191.76 (TOC)                      m                      Datum AHD										DM PERMIT 92897			

AQUIFER  SUMMARY:	DEPTH TO WATER CUT (m)	DEPTH TO STANDING WATER (m)	INTERVAL TESTED		SUPPLY			TOTAL DISSOLVED SOLIDS	
			From:	To:	kilolitres/day *	Test Length (hrs)	Method	milligrammes/litre	Analysis No:
		19.93 m (TOC) 8/8/83	86 - 88 (3mm slots)		11.2 (total cumulative Discharge)	3	Air Lifting While drilling	(14,000) approx.	W —




  

DEPTH (m)		GRAPHIC LOG	ROCK / SEDIMENT NAME	GEOLOGICAL DESCRIPTION	FORMATION / AGE	DEPTH COPE SAMPLE	CASING		
From	To						Dia (mm)	From (m)	To (m)
0	7		CLAY/GRAVEL	sandy, medium grave and sticky ferruginous clay yellow/Red Brown			50	+0.22	94
7	35		Mudstone & SILT- STONE	carbonaceous, pyritic Brown to Dark grey			Class 18 PVC		
35	47		SANDSTONE	medium to coarse, pyritic grey			Slots 86-88		
47	54		MUDSTONE & COAL	sticky grey			LINATEX SEAL AT 84 m		
54	60		SANDSTONE	medium, some sandstone chunks recovered, pyritic, well sorted light grey.			+ Cement from 84 m to 64 m		
60	66		SILTSTONE	carbonaceous, sandy pale grey (some coal 65 m)			Suregel from 64 - surface		
66	76		SANDSTONE	fine to coarse clear, well sorted pale grey (some coal 72 - 73 m).					
76	82		MUDSTONE	carbonaceous, pyritic sticky, grey.					
82	90		SANDSTONE	medium to coarse well sorted, pyritic light grey.					
90	92		COAL & MUDSTONE	sticky grey/black					
92	94*		SANDSTONE	medium, well sorted grey.					

<b>REMARKS:</b> <u>SITE 3 (U27)</u> * NOTE: 110 kl / day = 1000 gals / hr.  *Hole inadvertently drilled 2 m in to next aquifer, however a 1.51 m head difference is maintained between this hole and adjacent 9053 P completed in 92-101 m aquifer (indicating no contact)				DRILL TYPE: <b>ROTARY</b>		COMPLETED: <b>28/7/83</b>	
				CIRCULATION: <b>AIR</b>		LOGGED BY: <b>D.R. EDWARDS</b>	
				SHEET <b>1</b> OF <b>1</b>		DATE: <b>27/7/83</b>	

BAUG83 22OCT83  
PRE-JETTING POST JETTING

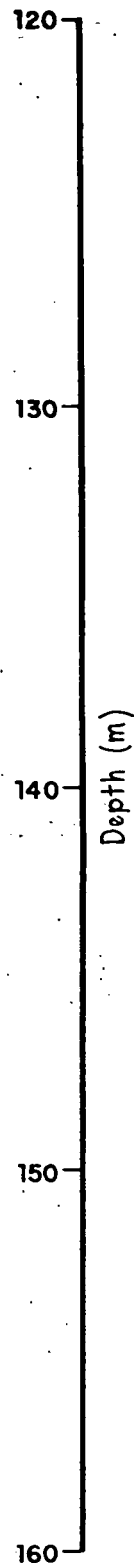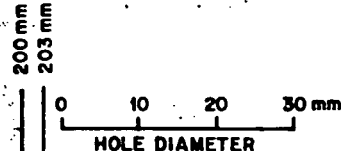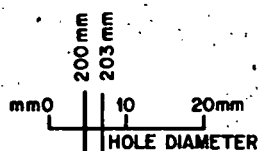

SILTSTONE  
grey

SANDSTONE  
fine av. 0.2mm

SCREEN  
121-126m 124-126m av. 0.6mm to 0.8mm well sorted

COAL  
black

SILTSTONE  
grey

SANDSTONE  
av. 0.3mm grey


COAL  
black

SILTSTONE  
grey

SANDSTONE  
av. 0.2mm to 0.5mm grey

COAL  
black

SILTSTONE  
clayey grey

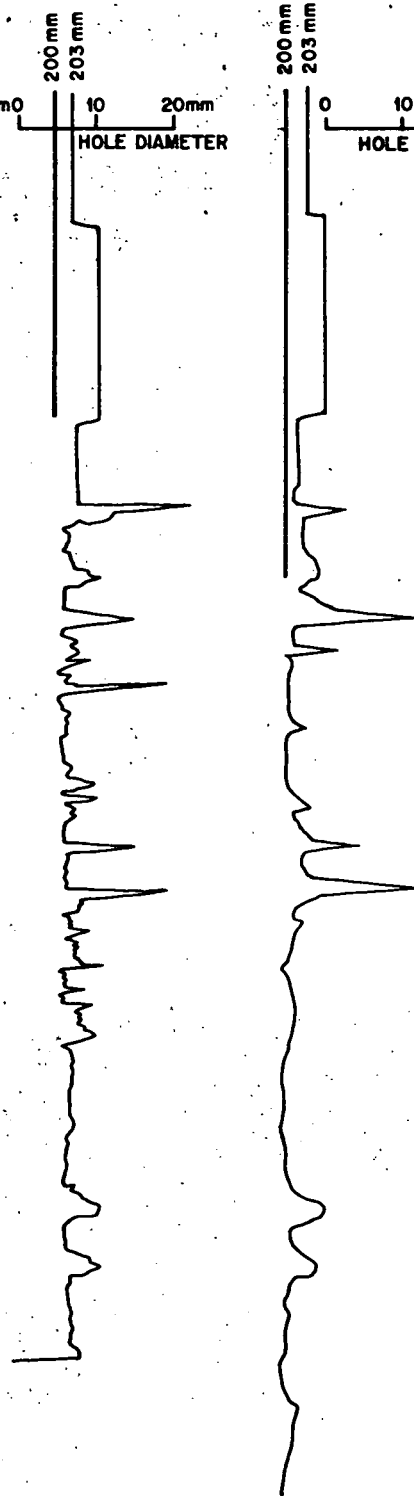

APPENDIX 3

DEPARTMENT OF MINES AND ENERGY  
SOUTH AUSTRALIA

COMPILED  
D.E. & D.A.

AS 4/85  
CDO DATE

LEIGH CREEK COALFIELD LOBE B GROUNDWATER INVESTIGATION

9050W WELL UNIT NO. 653747n0W00532

CALIPER LOGGING

DRAWN  
G.B.

SCALE

DATE  
20 JUL84

PLAN NUMBER

CHECKED

S17454

APPENDIX 4

A.M.D.E.L. Report



**The Australian  
Mineral Development  
Laboratories**

Flemington Street, Frewville,  
South Australia 5063  
Phone Adelaide 79 1662  
Telex AA 82520

Please address all  
correspondence to  
P.O. Box 114 Eastwood  
SA 5063  
In reply quote:

Your Ref:

4 July 1983

GS 1/4/0

12.02

Director-General,  
Department of Mines & Energy,  
PO Box 151,  
EASTWOOD, SA 5063.

Attention: D. Edward.

REPORT GS 6401/83

YOUR REFERENCE: Application dated 15 June 1983

MATERIAL: Four sandstone cores

LOCALITY: Leigh Creek, South Australia

IDENTIFICATION: A2330/83 Bore No. 3161 138.4-138.48 m  
A2331/83 Bore No. 3239 142.13-142.18 m  
A2332/83 Bore No. 3239 151.02-151.07 m  
A2333/83 Bore No. 3239 153.9 -153.95 m

DATE RECEIVED: 20 June 1983

WORK REQUIRED: Brief petrographic description, identification  
of cementing material, porosity and permeability  
analysis

Head Office:  
Flemington Street, Frewville  
South Australia 5063,  
Telephone (08) 79 1662  
Telex: Amdel AA82520  
Pilot Plant:  
Osman Place  
Thebarton, S.A.  
Telephone (08) 435 733  
Branch Laboratories:  
Melbourne, Vic.  
Telephone (03) 645 3093  
Perth, W.A.  
Telephone (09) 325 7311  
Townsville  
Queensland 4814  
Telephone (077) 75 1377

Investigation and Report by: Michael Till

Chief - Geological Services Section: Dr Keith J. Henley  
Manager, Mineral and Materials Sciences Division: Dr William G. Spencer

*Keith Henley*

for Brian S. Hickman  
Managing Director

## ANALYSIS OF FOUR LEIGH CREEK CORE SAMPLES

### 1. INTRODUCTION

Four sandstone core samples were received from Mr N. Gerges of the South Australian Department of Mines & Energy with a request for brief petrographic description, identification of the cementing material and determination of the porosity and permeability of the samples.

### 2. PROCEDURE

#### 2.1 Petrography

A transverse and a longitudinal thin section was prepared for each sample (TSC40085-40092) using kerosene rather than water as the coolant.

#### 2.2 X-ray Diffraction

The samples were air-dried at room temperature. A portion of each was powdered finely and used to prepare an X-ray diffractometer trace which was interpreted by standard procedures.

Further, weighed subsamples of samples A2330/83 and A2333/83 were taken and dispersed in water with the aid of deflocculants and an electric blender, and allowed to sediment to produce  $-2 \mu\text{m}$  e.s.d. fractions by the pipette method. The resulting dispersions were examined by plummet balance to determine their solids contents, and were then used to produce oriented clay preparations on ceramic plates. Two plates were prepared per sample, both being saturated with  $\text{Mg}^{++}$  ions, and one in addition being treated with glycerol. When air-dry, these were examined in the X-ray diffractometer. Various additional diagnostic examinations were carried out as required, including examination of the glycerol-free plate hot ( $\sim 130^\circ\text{C}$ ) and after heating for one hour at  $550^\circ\text{C}$ .

#### 2.3 Core Analysis

Plugs of the samples were drilled under liquid nitrogen, fitted with lead sleeving and tested for porosity and gas permeability at ambient pressure.

### 3. RESULTS

#### 3.1 X-ray Diffraction

Referring to the semi-quantitative abbreviations listed below the results are as follows:

##### Sample: A2330/83

Bulk Mineralogy:	Quartz	D
	Kaolinite	A
	Mica/illite	Tr
-2 $\mu\text{m}$ Mineralogy:	Kaolinite	D
	Mica/illite	SD
	Quartz	Tr
	Montmorillonite	Tr

4.5% of the sample was found to separated into the  $-2 \mu\text{m}$  size fraction\*

Sample: A2331/83

Bulk Mineralogy:	Quartz	D
	Kaolinite	A
	Halite	Tr

Sample: A2332/83

Bulk Mineralogy:	Quartz	D
	Kaolinite	A
	Mica/illite	Tr
	Halite	Tr

Sample: A2333/83

Bulk Mineralogy:	Quartz	D
	Kaolinite	A
	Mica/illite	Tr
	Pyrite	Tr

-2 $\mu$ m Mineralogy:	Kaolinite	D
	Mica/illite	Tr-A
	Quartz	Tr
	Montmorillonite	Tr

1.5% of the sample was found to separate into the -2  $\mu$ m size fraction\*

\* As determined by the plummet balance. The figure obtained applies only to the pre-treatment and dispersion conditions used.

Semi-quantitative Abbreviations:

- D = Dominant. Used for the component apparently most abundant, regardless of its probable percentage level.
- CD = Co-dominant. Used for two (or more) predominating components, both or all of which are judged to be present in roughly equal amounts.
- SD = Sub-dominant. The next most abundant component(s) providing its percentage level is judged above about 20.
- A = Accessory. Components judged to be present between the levels of roughly 5 and 20%.
- Tr = Trace. Components judged to be below about 5%.

### 3.2 Core Analysis

Sample	Bore No.	Depth	Permeability mDarcy	Porosity %
A2330/83	3161	138.4 - 138.48 m	5060	4.22 36.7
A2331/83	3239	142.13 - 142.18 m	4380	3.65 36.8
A2332/83	3239	151.02 - 151.07 m	3930	3.28 35.0
A2333/83	3239	153.9 - 153.95 m	3260	2.72 36.8

### 3.3 Petrography

Sample: A2330/83: TSC40085, 40086

# 3161  
138.4 - 138.48 m

Rock Name:

A kaolinitic well-sorted, medium-grained sandstone

Hand Specimen:

A medium-grey friable sandstone.

Thin Section:

The sample comprises a framework of fine to medium sand-sized, subrounded to well-rounded quartz grains with a matrix of argillaceous material.

The quartz framework grains range in size from 0.25 to 0.4 mm and consist predominantly of single crystals with a very few grains showing typical quartzite textures. Partially altered grains of K-feldspar occur in minor amounts and buff/olive tourmaline and detrital muscovite flakes occur in trace amounts.

The argillaceous matrix is stained brown and consists mainly of kaolinite with minor sericite. In only a very few pore spaces does it occupy the entire pore space, usually occupying less than 10% of the pore space or occurring as a thin coating on the quartz grains. The remaining potential pore space is void. Cementing of grains by authigenic quartz cement was not observed.



#3239

Sample: A2331; TSC40087-40088

142.13 - 142.18m

## Rock Name:

A kaolinitic well-sorted, medium-grained sandstone

## Hand Specimen:

A medium-grey friable sandstone.

## Thin Section:

This sample consists of a framework of medium sand-sized, subrounded to well-rounded quartz grains with a matrix of finer-grained quartz and argillaceous material.

The quartz framework grains range in size from 0.25 to 0.4 mm and consist predominantly of single crystals. A minor number of grains consist of two or more grains cemented by quartz and a few quartz grains show marginal overgrowth. However, the cementation in each case is considered to have occurred before deposition. A very few grains with typical quartzite textures are also present. The few original feldspar grains now are altered to brown-stained grains of kaolinite, or kaolinite and sericite and opaques. These grains have been deformed by compaction of the surrounding quartz.

The argillaceous matrix is stained brown and consists of kaolinite occurring as a thin coating on the quartz grains. Small equant quartz grains, 0.06 to 0.1 mm in size occupy part of the pore space in some areas. The remaining pore space is void. Cementing of grains by authigenic quartz was not observed.

# 3239

151.02 to 151.07~

Sample: A2332; TSC40089, 40090

## Rock Name:

A kaolinite, well-sorted, medium-grained sandstone

## Hand Specimen:

A medium-grey friable sandstone.

## Thin Section:

This sample is very similar to sample A2330 as it comprises predominantly medium-grained detrital quartz grains in a matrix of argillaceous material.

The quartz grains vary in size from 0.2 to 0.55 mm and consist predominantly of single crystals, with a few grains consisting of cemented composite grains. A few deformed grains of brown-stained kaolinite or kaolinite, sericite and opaques are also present.

The argillaceous matrix consists of brown-stained kaolinite forming a thin coating on the quartz grains. The remaining potential pore space is void. Cementing of grains by authigenic quartz was not observed.

#3239

153.9 - 153.95 m

Sample: A2333; TSC40091, 40092

Rock Name:

A pyritic, kaolinitic well-sorted, medium-grained sandstone

Hand Specimen:

A medium-grey friable sandstone containing a few pyrite grains.  
The sandstone is not friable in the few areas containing pyrite cement.

Thin Section:

This sample consists of a framework of medium to coarse sand-sized, subrounded to well-rounded quartz grains with a matrix of argillaceous material and pyrite grains and a cement of pyrite.

The quartz framework grains range in size from 0.25 to 0.8 mm and consist predominantly of single crystals and with a very few quartzite grains. A very few grains show marginal overgrowth. A few deformed grains of brown-stained kaolinite are also present.

The matrix consists mainly of brown-stained kaolinite which occurs as a thin coating on the quartz grains and fills some of the smaller interstitial spaces. Small pyrite grains varying in size from 0.05 to 0.1 mm occur in the matrix. In addition, pyrite masses occur as overgrowths on quartz grains and pyrite fills interstitial spaces apparently at random, with adjacent pore spaces being free of pyrite. As observed using a stereo microscope, the pyrite does effectively cement the quartz grains in a few areas. The argillaceous matrix and mounting resin is stained yellow adjacent to these pyrite masses, and pale yellow crystals, probably derived from the alteration of pyrite, were observed in a few areas in hand specimen, but are not present in the area sectioned. Cementing of grains by authigenic quartz was not observed.

## APPENDIX 5

### Water Analyses

9010W	22/5/82	A.C.S. Laboratories
9010W	1/10/82	ETSA Laboratories
9040W	21/7/83	A.M.D.E.L.
9050W	8/8/83	A.M.D.E.L.
9020W	7/11/83	ETSA Laboratories
9050W	7/11/83	ETSA Laboratories

# WATER ANALYSIS REPORT

SAMPLE No.

JOB No. A 4469 (A.C.S. LABORATORIES)

## CHEMICAL COMPOSITION

## DERIVED AND OTHER DATA

		MILLIGRAMS PER LITRE mg/l	MILLEQUIVS. PER LITRE me/l
<u>CATIONS</u>			
CALCIUM	(Ca)	675	33.6
MAGNESIUM	(Mg)	480	39.5
SODIUM	(Na)	6600	287
POTASSIUM	(K)	37	1
IRON	(Fe)	-	-
<u>ANIONS</u>			
HYDROXIDE	(OH)	-	-
CARBONATE	(CO <sub>3</sub> )	<1	-
BICARBONATE	(HCO <sub>3</sub> )	70	1
SULPHATE	(SO <sub>4</sub> )	3460	72
CHLORIDE	(Cl)	10220	288
FLUORIDE	(F)	-	-
NITRATE	(NO <sub>3</sub> )	-	-
PHOSPHATE	(PO <sub>4</sub> )	-	-

CONDUCTIVITY (E.C.)  
MICRO-S/cm AT 25 DEG.C

TOTAL DISSOLVED SOLIDS

MILLIGRAMS  
PER LITRE  
mg/l

A. BASED ON E.C.  
B. CALCULATED (HCO<sub>3</sub>=CO<sub>3</sub>)  
C. RESIDUE ON EVAP.  
AT 180 DEG.C

21,560

TOTAL HARDNESS AS CaCO<sub>3</sub>  
CARBONATE HARDNESS AS CaCO<sub>3</sub>  
NON-CARBONATE HARDNESS AS CaCO<sub>3</sub>  
TOTAL ALKALINITY AS CaCO<sub>3</sub>  
FREE CARBON DIOXIDE (CO<sub>2</sub>)  
SUSPENDED SOLIDS  
SILICA (SiO<sub>2</sub>)  
BORON (B)

## TOTALS AND BALANCE

CATIONS 361.1 (me/l)  
ANIONS 361 (me/l)

DIFF = 0.1  
SUM = 722.1

DIFF 100  
SUM =

REACTION - pH  
TURBIDITY (JACKSON)  
COLOUR (HAZEN)

UNITS

7.48

SODIUM TO TOTAL CATION RATIO (me/l)

NAME - ETSA  
ADDRESS LEIGH CREEK  
DATE COLLECTED 22/5/82  
SAMPLE COLLECTED BY: D.R. EDWARDS

FIELD TEMP. 12 °C  
FIELD pH @ °C  
FIELD COND. 14,000 µ-S/cm

OBS. No. 9010 W  
HOLE No. REMARKS Sample is from  
D.M. No. first development and  
probably includes same  
displacement water -  
(ATS >10,000 mg/l)

# WATER ANALYSIS REPORT

SAMPLE No. .

JOB No. (ETSA, LAB ANALYSIS)

## CHEMICAL COMPOSITION

## DERIVED AND OTHER DATA

		MILLIGRAMS PER LITRE mg/l	MILLEQUIVS. PER LITRE me/l
<b>CATIONS</b>			
CALCIUM	(Ca)	280	14
MAGNESIUM	(Mg)	20	1.64
SODIUM	(Na)	2760	120
POTASSIUM	(K)	-	-
IRON	(Fe)	-	-
<b>ANIONS</b>			
HYDROXIDE	(OH)	-	-
CARBONATE	(CO <sub>3</sub> )	-	-
BICARBONATE	(HCO <sub>3</sub> )	490	8.03
SULPHATE	(SO <sub>4</sub> )	400	8.33
CHLORIDE	(Cl)	4220	118.9
FLUORIDE	(F)	-	-
NITRATE	(NO <sub>3</sub> )	-	-
PHOSPHATE	(PO <sub>4</sub> )	-	-

CONDUCTIVITY (E.C.)  
MICRO-S/cm AT 25 DEG.C 13,900

TOTAL DISSOLVED SOLIDS 8,170

MILLIGRAMS  
PER LITRE  
mg/l

A. BASED ON E.C.  
B. CALCULATED (HCO<sub>3</sub>=CO<sub>3</sub>)  
C. RESIDUE ON EVAP.  
AT 180 DEG.C

TOTAL HARDNESS AS CaCO<sub>3</sub>  
CARBONATE HARDNESS AS CaCO<sub>3</sub>  
NON-CARBONATE HARDNESS AS CaCO<sub>3</sub>  
TOTAL ALKALINITY AS CaCO<sub>3</sub>  
FREE CARBON DIOXIDE (CO<sub>2</sub>)  
SUSPENDED SOLIDS  
SILICA (SiO<sub>2</sub>)  
BORON (B)

## TOTALS AND BALANCE

CATIONS 135.6 (me/l)  
ANIONS 135.2 (me/l)

DIFF = 0.4  
SUM = 231

DIFF 100  
SUM = 0.2

REACTION - pH  
TURBIDITY (JACKSON)  
COLOUR (HAZEN)

## UNITS

SODIUM TO TOTAL CATION RATIO(me/l)

NAME - ETSA  
ADDRESS LEIGH CREEK  
DATE COLLECTED 1/10/82  
SAMPLE COLLECTED BY: RER

FIELD TEMP.  
FIELD pH  
FIELD COND.

°C  
°C  
μ-S/cm

OBS. No. 9010W  
HOLE No. 6536OW254  
D.M. No.

# WATER ANALYSIS REPORT

SAMPLE No. W/4263/83

JOB No. 445/84 (AMDEL ANALYSIS)

## CHEMICAL COMPOSITION

		MILLIGRAMS PER LITRE mg/ℓ	MILLEQUIVS. PER LITRE me/ℓ
<b>CATIONS</b>			
CALCIUM	(Ca)	515	25.7
MAGNESIUM	(Mg)	365	30
SODIUM	(Na)	4220	183.6
POTASSIUM	(K)	22	0.6
IRON	(Fe)	-	-
<b>ANIONS</b>			
HYDROXIDE	(OH)	0	0
CARBONATE	(CO <sub>3</sub> )	0	0
BICARBONATE	(HCO <sub>3</sub> )	311	5.1
SULPHATE	(SO <sub>4</sub> )	2620	54.5
CHLORIDE	(Cl)	6269	176.8
FLUORIDE	(F)	<1	0
NITRATE	(NO <sub>3</sub> )	<1	0
PHOSPHATE	(PO <sub>4</sub> )	-	-

## TOTALS AND BALANCE

CATIONS 239.8 (me/ℓ)

ANIONS 236.5 (me/ℓ)

DIFF = 3.4

SUM = 476.3

DIFF 100  
SUM = 0.7%

## DERIVED AND OTHER DATA

CONDUCTIVITY (E.C.)  
MICRO-S/cm AT 25 DEG.C

TOTAL DISSOLVED SOLIDS

A. BASED ON E.C.  
B. CALCULATED (HCO<sub>3</sub>=CO<sub>3</sub>)  
C. RESIDUE ON EVAP.  
AT 180 DEG.C

MILLIGRAMS  
PER LITRE  
mg/ℓ

14165

TOTAL HARDNESS AS CaCO<sub>3</sub> 2788  
CARBONATE HARDNESS AS CaCO<sub>3</sub> 255  
NON-CARBONATE HARDNESS AS CaCO<sub>3</sub> 2533  
TOTAL ALKALINITY AS CaCO<sub>3</sub> 255  
FREE CARBON DIOXIDE (CO<sub>2</sub>)  
SUSPENDED SOLIDS  
SILICA (SiO<sub>2</sub>)  
BORON (B)

UNITS

7.7

REACTION - pH  
TURBIDITY (JACKSON)  
COLOUR (HAZEN)

SODIUM TO TOTAL CATION RATIO(me/ℓ) 76.5%

NAME - ETSA  
ADDRESS LEIGH CREEK  
DATE COLLECTED 21/7/83  
SAMPLE COLLECTED BY: D.R. EDWARDS

FIELD TEMP.  
FIELD pH  
FIELD COND.

°C  
@ °C  
μ-S/cm

OBS. No. 9040W  
HOLE No. Sampled Intervals  
D.M. No. 145 to 150 and  
157 to 169 m

# WATER ANALYSIS REPORT

SAMPLE No. W/4265/83

JOB No. 445/84 (AMDEL ANALYSIS)

## CHEMICAL COMPOSITION

		MILLIGRAMS PER LITRE mg/ℓ	MILLEQUIVS. PER LITRE me/ℓ
<b>CATIONS</b>			
CALCIUM	(Ca)	510	25.4
MAGNESIUM	(Mg)	365	30.0
SODIUM	(Na)	4270	185.7
POTASSIUM	(K)	26	0.7
IRON	(Fe)	-	-
<b>ANIONS</b>			
HYDROXIDE	(OH)	0	0
CARBONATE	(CO <sub>3</sub> )	0	0
BICARBONATE	(HCO <sub>3</sub> )	311	5.1
SULPHATE	(SO <sub>4</sub> )	2680	55.8
CHLORIDE	(Cl)	6309	177.9
FLUORIDE	(F)		
NITRATE	(NO <sub>3</sub> )	<1	0
PHOSPHATE	(PO <sub>4</sub> )	-	-

### TOTALS AND BALANCE

CATIONS 241.9 (me/ℓ)  
ANIONS 238.8 (me/ℓ)

DIFF = 3.0  
SUM = 480.7

DIFF 100  
SUM = 0.6%

## DERIVED AND OTHER DATA

CONDUCTIVITY (E.C.)  
MICRO-S/cm AT 25 DEG.C

TOTAL DISSOLVED SOLIDS

A. BASED ON E.C.  
B. CALCULATED (HCO<sub>3</sub>=CO<sub>3</sub>)  
C. RESIDUE ON EVAP.  
AT 180 DEG.C

MILLIGRAMS  
PER LITRE  
mg/ℓ

14314

TOTAL HARDNESS AS CaCO<sub>3</sub>  
CARBONATE HARDNESS AS CaCO<sub>3</sub>  
NON-CARBONATE HARDNESS AS CaCO<sub>3</sub>  
TOTAL ALKALINITY AS CaCO<sub>3</sub>  
FREE CARBON DIOXIDE (CO<sub>2</sub>)  
SUSPENDED SOLIDS  
SILICA (SiO<sub>2</sub>)  
BORON (B)

2775  
255  
2520  
255

REACTION - pH  
TURBIDITY (JACKSON)  
COLOUR (HAZEN)

UNITS  
7.9

SODIUM TO TOTAL CATION RATIO(me/ℓ) 76.8%

NAME - ETSA  
ADDRESS LEIGH CREEK  
DATE COLLECTED 8/8/83  
SAMPLE COLLECTED BY: D.R. EDWARDS

FIELD TEMP.  
FIELD pH  
FIELD COND.

°C  
°C  
μ-S/cm

OBS. No. 9050W  
HOLE No. Sampled Interval  
D.M. No. 121-151 m



# WATER ANALYSIS REPORT

SAMPLE No.

JOB No. (ETSA LAB ANALYSIS)

## CHEMICAL COMPOSITION

## DERIVED AND OTHER DATA

		MILLIGRAMS PER LITRE mg/ℓ	MILLEQUIVS. PER LITRE me/ℓ
<b>CATIONS</b>			
CALCIUM	(Ca)	336	16.8
MAGNESIUM	(Mg)	209	17.2
SODIUM	(Na)	3772	164.0
POTASSIUM	(K)	-	-
IRON	(Fe)	-	-
<b>ANIONS</b>			
HYDROXIDE	(OH)	-	-
CARBONATE	(CO <sub>3</sub> )	-	-
BICARBONATE	(HCO <sub>3</sub> )	482	7.9
SULPHATE	(SO <sub>4</sub> )	1881	39.2
CHLORIDE	(Cl)	5388	152.0
FLUORIDE	(F)	-	-
NITRATE	(NO <sub>3</sub> )	-	-
PHOSPHATE	(PO <sub>4</sub> )	-	-

CONDUCTIVITY (E.C.)  
MICRO-S/cm AT 25 DEG.C 16,400

TOTAL DISSOLVED SOLIDS

MILLIGRAMS  
PER LITRE  
mg/ℓ

A. BASED ON E.C.  
B. CALCULATED (HCO<sub>3</sub>=CO<sub>3</sub>)  
C. RESIDUE ON EVAP.  
AT 180 DEG.C

12,076

TOTAL HARDNESS AS CaCO<sub>3</sub>  
CARBONATE HARDNESS AS CaCO<sub>3</sub>  
NON-CARBONATE HARDNESS AS CaCO<sub>3</sub>  
TOTAL ALKALINITY AS CaCO<sub>3</sub>  
FREE CARBON DIOXIDE (CO<sub>2</sub>)  
SUSPENDED SOLIDS  
SILICA (SiO<sub>2</sub>)  
BORON (B)

## TOTALS AND BALANCE

CATIONS (me/ℓ)  
ANIONS (me/ℓ)

DIFF =  
SUM =

DIFF 100 =  
SUM

REACTION - pH  
TURBIDITY (JACKSON)  
COLOUR (HAZEN)

UNITS  
6.96

SODIUM TO TOTAL CATION RATIO(me/ℓ)

NAME -  
ADDRESS  
DATE COLLECTED 7/11/83  
SAMPLE COLLECTED BY: ETSA

FIELD TEMP.  
FIELD pH  
FIELD COND.

°C  
@ °C  
μ-S/cm

OBS. No. 9020W  
HOLE No.  
D.M. No.

# WATER ANALYSIS REPORT

SAMPLE No.

JOB No. (ETSA LAB ANALYSIS)

## CHEMICAL COMPOSITION

## DERIVED AND OTHER DATA

		MILLIGRAMS PER LITRE mg/l	MILLEQUIVS. PER LITRE me/l
<b>CATIONS</b>			
CALCIUM	(Ca)	492	24.6
MAGNESIUM	(Mg)	367	30.2
SODIUM	(Na)	4830	210.0
POTASSIUM	(K)	-	-
IRON	(Fe)	-	-
<b>ANIONS</b>			
HYDROXIDE	(OH)	-	-
CARBONATE	(CO <sub>3</sub> )	-	-
BICARBONATE	(HCO <sub>3</sub> )	305	5.0
SULPHATE	(SO <sub>4</sub> )	3720	77.5
CHLORIDE	(Cl)	6665	188.0
FLUORIDE	(F)	-	-
NITRATE	(NO <sub>3</sub> )	-	-
PHOSPHATE	(PO <sub>4</sub> )	-	-

CONDUCTIVITY (E.C.)  
MICRO-S/cm AT 25 DEG.C 20,000

TOTAL DISSOLVED SOLIDS

MILLIGRAMS  
PER LITRE  
mg/l  
16,400

A. BASED ON E.C.  
B. CALCULATED (HCO<sub>3</sub>=CO<sub>3</sub>)  
C. RESIDUE ON EVAP.  
AT 180 DEG.C

TOTAL HARDNESS AS CaCO<sub>3</sub>  
CARBONATE HARDNESS AS CaCO<sub>3</sub>  
NON-CARBONATE HARDNESS AS CaCO<sub>3</sub>  
TOTAL ALKALINITY AS CaCO<sub>3</sub>  
FREE CARBON DIOXIDE (CO<sub>2</sub>)  
SUSPENDED SOLIDS  
SILICA (SiO<sub>2</sub>)  
BORON (B)

### TOTALS AND BALANCE

CATIONS (me/l)  
ANIONS (me/l)

DIFF =  
SUM =

DIFF 100  
SUM =

REACTION - pH  
TURBIDITY (JACKSON)  
COLOUR (HAZEN)

UNITS  
6.93

SODIUM TO TOTAL CATION RATIO(me/l)

NAME -  
ADDRESS  
DATE COLLECTED 7/11/83  
SAMPLE COLLECTED BY: ETSA

FIELD TEMP.  
FIELD pH  
FIELD COND.

°C  
@ °C  
μ-S/cm

OBS. No. 9050W  
HOLE No.  
D.M. No.

APPENDIX 6

Index of DME Well Unit Numbers

INDEX OF DME WELL UNIT NUMBERS

Site U/24

	<u>UNIT NUMBER</u>
9010W	6536-5aOW-254
9020W	6536-5aOW-426
9021P	6536-5aOW-331
9022P	6536-5aOW-332
9023P	6536-5aOW-333
9024P	6536-5aOW-319
9025P	6536-5aOW-320
9026P	6536-5aOW-300

Site U/25

9030W	6537-46rOW-573
9040W	6537-46rOW-598
9041P	6537-46rOW-578
9042P	6537-46rOW-579
9043P	6537-46rOW-570
9044P	6537-46rOW-571

Site U/27

9050W	6537-47nOW-532
9051P	6537-47mOW-537
9052P	6537-47mOW-538
9053P	6537-47mOW-599
9054P	6537-47mOW-581